

O.D.O.T. DISTRICT 2 SURVEY OFFICE (USE ONLY)

PERSONNEL \_\_\_\_\_ REFERENCE NO. 23 C SHEET 29 OF 38

NOTES RHOADES DATE 5/2/13 ROUTE US 20

H.C. CODER WEATHER FAIR COUNTY WILLIAMS

R.C. LAU TEMP. 70° TOWNSHIP BRIDGEWATER

SECTION 32

T 9 S R 3 W

TYPE MONUMENT P.K.NAIL




~~ON SURFACE~~ - BELOW 0.3'

LEFT - 0 PAV'T - ~~RIGHT~~ 3'

- TO - EDGE PAVEMENT

S.L.M. 364+79.64

GRID: NORTHING: 726550.327 EASTING: 1374459.063

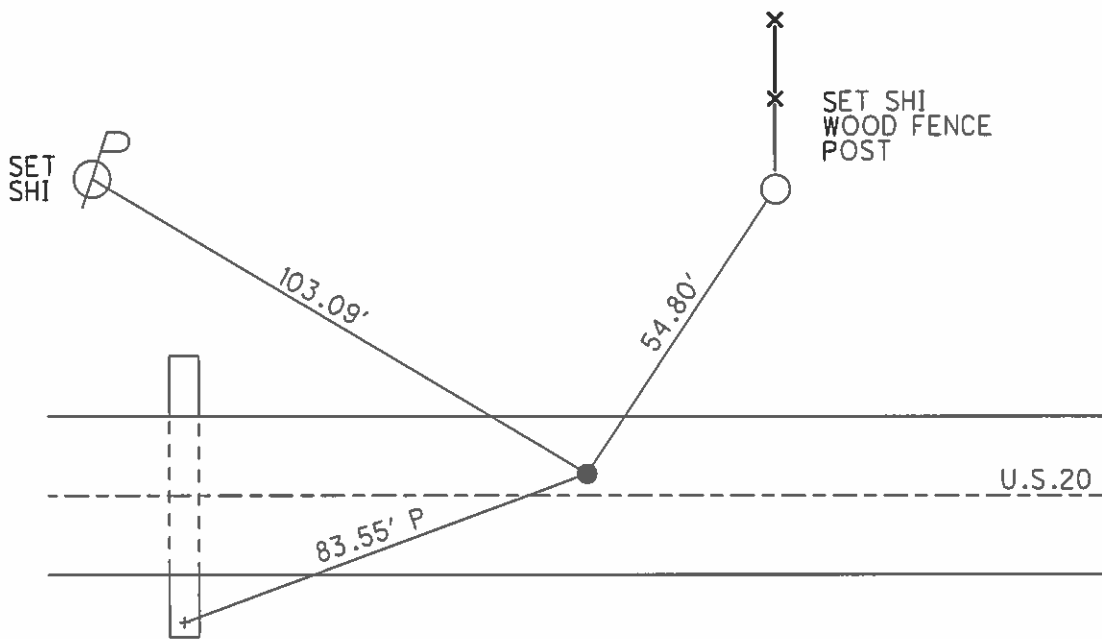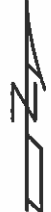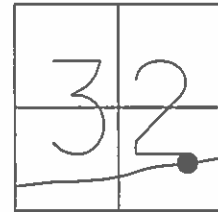

SET "+" CUT  
IN 18" RCP

SET SHI  
WOOD FENCE  
POST

RECORD:  
FD NAIL  
7/25/90, I.S.

SET P.K.NAIL  
9/6/90, DJC

FD P.K./WASHER  
4/10/12, SAH

SET MAG/WASHER  
GPS, REFC23  
7/16/14, DCH