

O.D.O.T. DISTRICT 2 SURVEY OFFICE (USE ONLY)

PERSONNEL _____ REFERENCE NO. 23 D SHEET 30 OF 38

NOTES RHOADES DATE 5/2/13 ROUTE US 20
 H.C. CODER WEATHER FAIR COUNTY WILLIAMS
 R.C. LAU TEMP. 70° TOWNSHIP BRIDGEWATER
 _____ SECTION 32
 _____ T 9 S R 3 W

TYPE MONUMENT P.K./WASHER



~~ON SURFACE~~ - BELOW 0.25'

LEFT - C PAV'T - RIGHT ON

- TO - EDGE PAVEMENT

S.L.M. 369+60.80

GRID: NORTHING: 726576.021 EASTING: 1374939.477

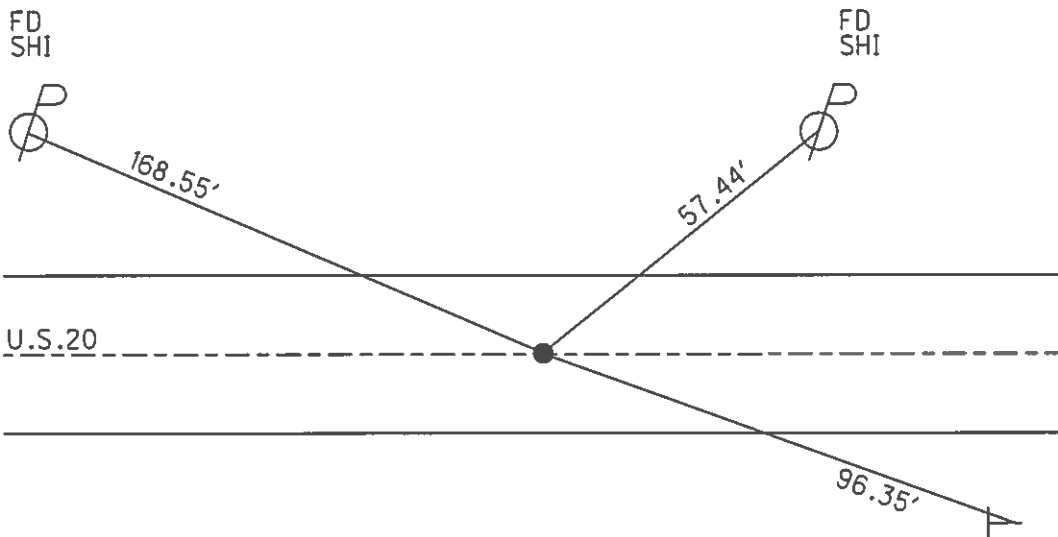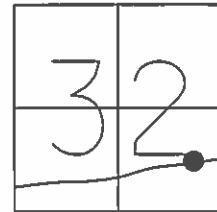

RECORD:
 FD NAIL
 7/25/90, I.S.

SET P.K.NAIL
 9/21/90, DJC

FD P.K./WASHER
 0.25' DOWN
 4/10/12, SAH

SET MAG/WASHER
 GPS, REFD23
 7/16/14, DCH

NEARSIDE
 SIGN. 2' UP
 MP 7