


O.D.O.T. DISTRICT 2 SURVEY OFFICE (USE ONLY)

PERSONNEL _____ REFERENCE NO. 24 C SHEET 33 OF 38


NOTES STONE _____ DATE 7/24/90 ROUTE US 20
H.C. CURTIS _____ WEATHER WARM COUNTY WILLIAMS
R.C. HOUSEHOLDER _____ TEMP. 82° TOWNSHIP BRIDGEWATER
GROWLS _____ SECTION 33
T 9 S R 3 W

TYPE MONUMENT R.R.SPIKE
ON SURFACE - ~~BELOW~~ ON _____
LEFT - Q PAV'T - ~~RIGHT~~ 21.7'
- TO - EDGE PAVEMENT
S.L.M. 412+35.23

GRID: NORTHING: 727455.783 EASTING: 1379090.206

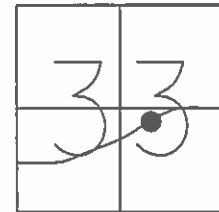

RES #8709

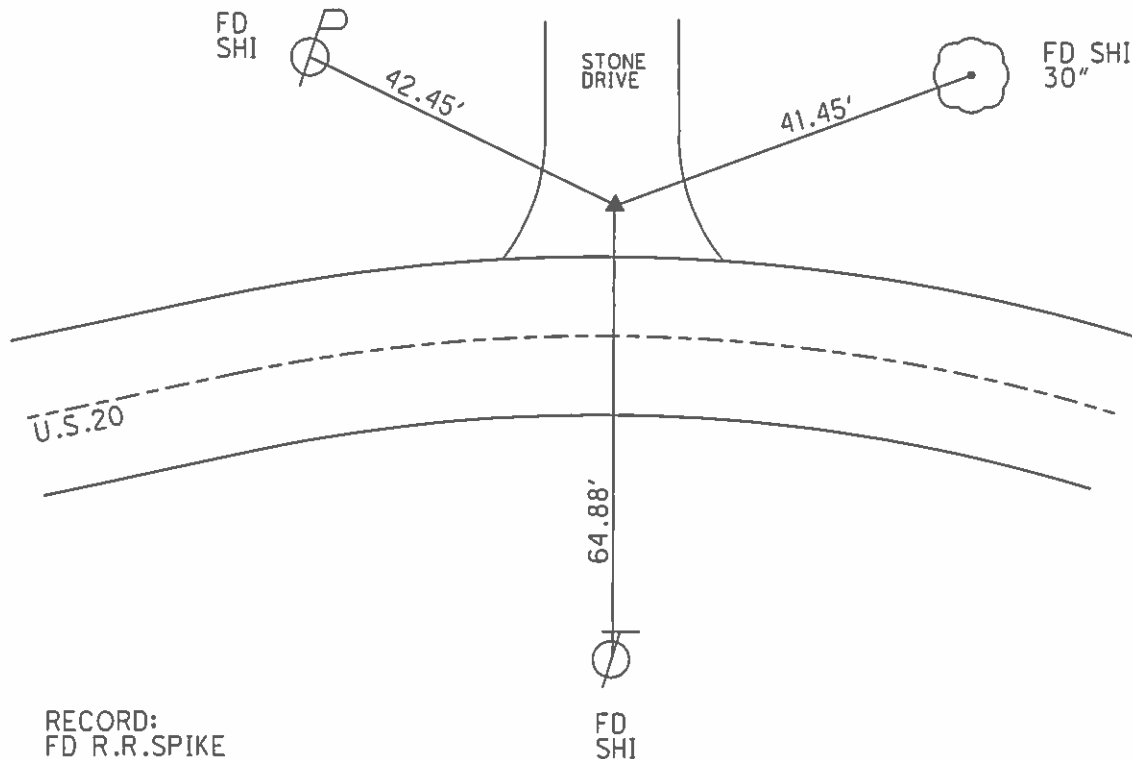

RECORD:
FD R.R.SPIKE
7/24/90, I.S.
9/21/90, SAH
4/11/12, DCH

GPS, REFC24
7/22/14, EBW