

O.D.O.T. DISTRICT 2 SURVEY OFFICE (USE ONLY)

PERSONNEL _____ REFERENCE NO. 24 F SHEET 36 OF 38

NOTES RHOADES DATE 5/1/13 ROUTE US 20

H.C. CODER WEATHER FAIR COUNTY WILLIAMS

R.C. LAU TEMP. 70° TOWNSHIP BRIDGEWATER

SECTION 33

T 9 S R 3 W

TYPE MONUMENT P.K.NAIL



ON SURFACE - ~~BELOW~~ ON _____

LEFT - Q PAV'T - ~~RIGHT~~ 0.5'

_____ TO _____ EDGE PAVEMENT

S.L.M. 422+81.08

GRID: NORTHING: 727437.927 EASTING: 1380135.725

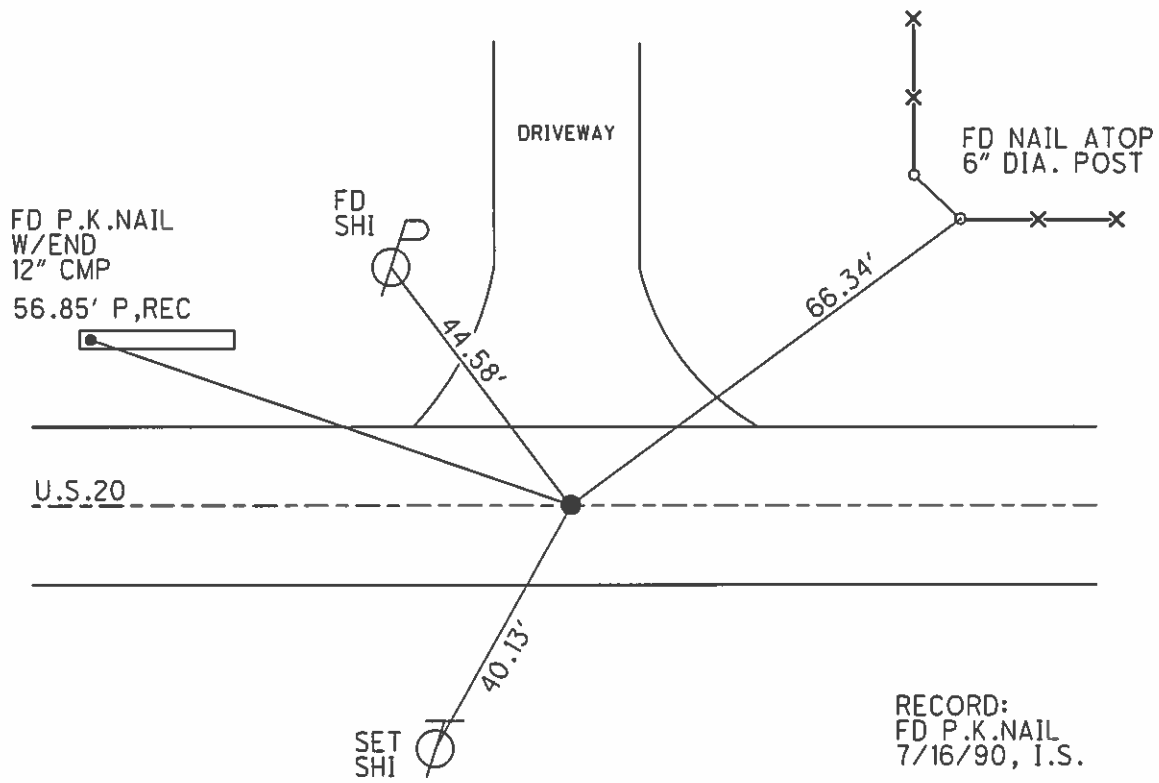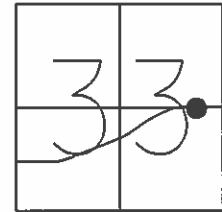

RECORD:
 FD P.K.NAIL
 7/16/90, I.S.

 SET P.K.NAIL
 9/21/90, DJC

 FD P.K.NAIL
 4/11/12, SAH

 SET MAG/WASHER
 GPS, REFF24
 7/17/14, EBW