



O.D.O.T. DISTRICT 2 SURVEY OFFICE (USE ONLY)

PERSONNEL _____ REFERENCE NO. 25 SHEET 37 OF 38

NOTES RHOADES _____ DATE 5/2/13 ROUTE US 20
 H.C. CODER _____ WEATHER FAIR COUNTY WILLIAMS
 R.C. LAU _____ TEMP. 70° TOWNSHIP BRIDGEWATER
 _____ SECTION 34
 _____ T 9 S R 3 W

TYPE MONUMENT P.K.NAIL
 ON SURFACE - ~~BELOW~~ ON _____
 LEFT - C PAV'T - ~~RIGHT~~ 0.5'
 _____ TO _____ EDGE PAVEMENT
 S.L.M. 429+56.76

GRID: NORTHING: 727426.451 EASTING: 1380811.268

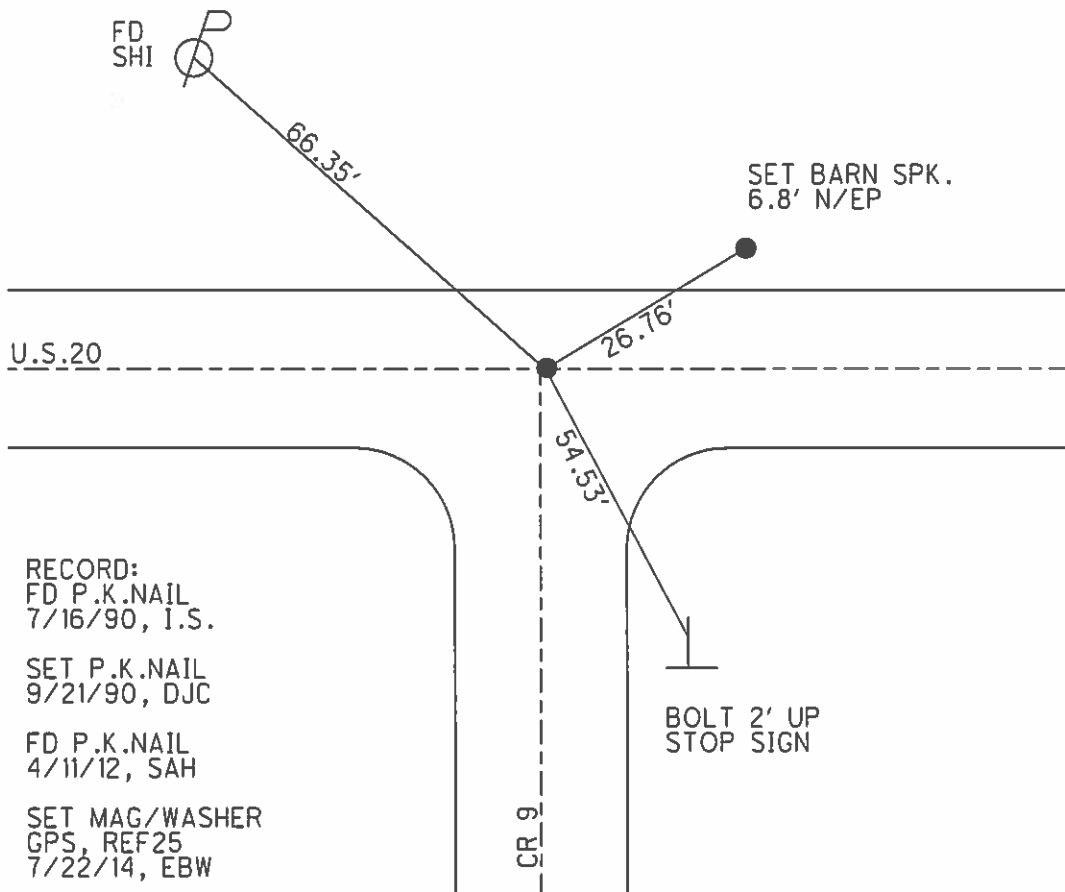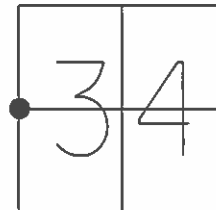

RECORD:
 FD P.K.NAIL
 7/16/90, I.S.

SET P.K.NAIL
 9/21/90, DJC

FD P.K.NAIL
 4/11/12, SAH

SET MAG/WASHER
 GPS, REF25
 7/22/14, EBW