


O.D.O.T. DISTRICT 2 SURVEY OFFICE (USE ONLY)

PERSONNEL _____ REFERENCE NO. 27 SHEET 38 OF 38

NOTES RHOADES _____ DATE 5/2/13 ROUTE US 20
 H.C. CODER _____ WEATHER FAIR COUNTY WILLIAMS
 R.C. LAU _____ TEMP. 70° TOWNSHIP BRIDGEWATER
 _____ SECTION 34, 35
 _____ T 9 S R 3 W


TYPE MONUMENT P.K./WASHER
 ON SURFACE - ~~BELOW~~ ON
 LEFT - Q PAV'T - RIGHT ON
- TO - EDGE PAVEMENT
 S.L.M. 482+38.14

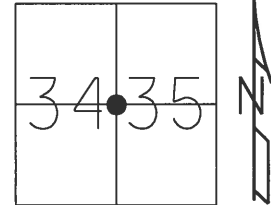

GRID: NORTHING: 727324.594 EASTING: 1386091.778

NOTE: SR 576 REF 30A

RECORD: P.I.
 STA. 481+26.86
 $\Delta = 0^{\circ}13' LT$
 FD 1" IPIN IN
 CONC. 3" BELOW
 FD P.K./WASHER
 6/16/93, CL
 SET P.K./WASHER
 8/9/93, CL
 FD P.K./WASHER
 4/11/12, SAH
 FD P.K.NAIL
 REF27
 2/5/13, DCH
 FD P.K.SHANK
 GPS, REF27
 7/22/14, EBW

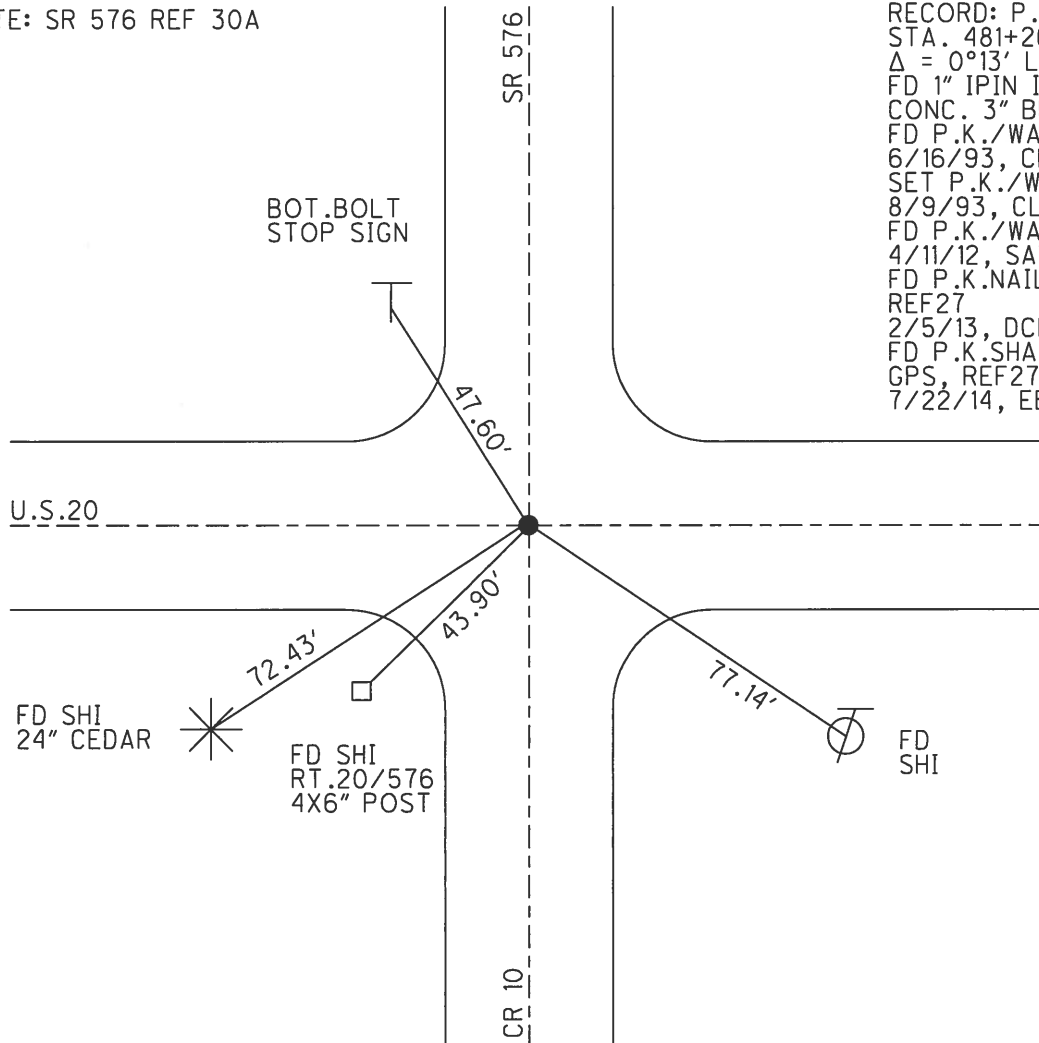

O.D.O.T. DISTRICT 2 SURVEY OFFICE (USE ONLY)

PERSONNEL _____ REFERENCE NO. 27 SHEET 38 OF 38

NOTES RHOADES _____ DATE 5/2/13 ROUTE US 20

H.C. CODER _____ WEATHER FAIR COUNTY WILLIAMS

R.C. LAU _____ TEMP. 70° TOWNSHIP BRIDGEWATER

SECTION 34-35

T 9 S R 3 W


TYPE MONUMENT P.K./WASHER

ON SURFACE - ~~BELOW~~ ON


LEFT - Q PAV'T - RIGHT ON

- TO - EDGE PAVEMENT

S.L.M. 482+38.14

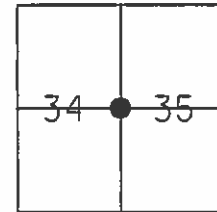

GRID: NORTHING: 727324.594 EASTING: 1386091.778

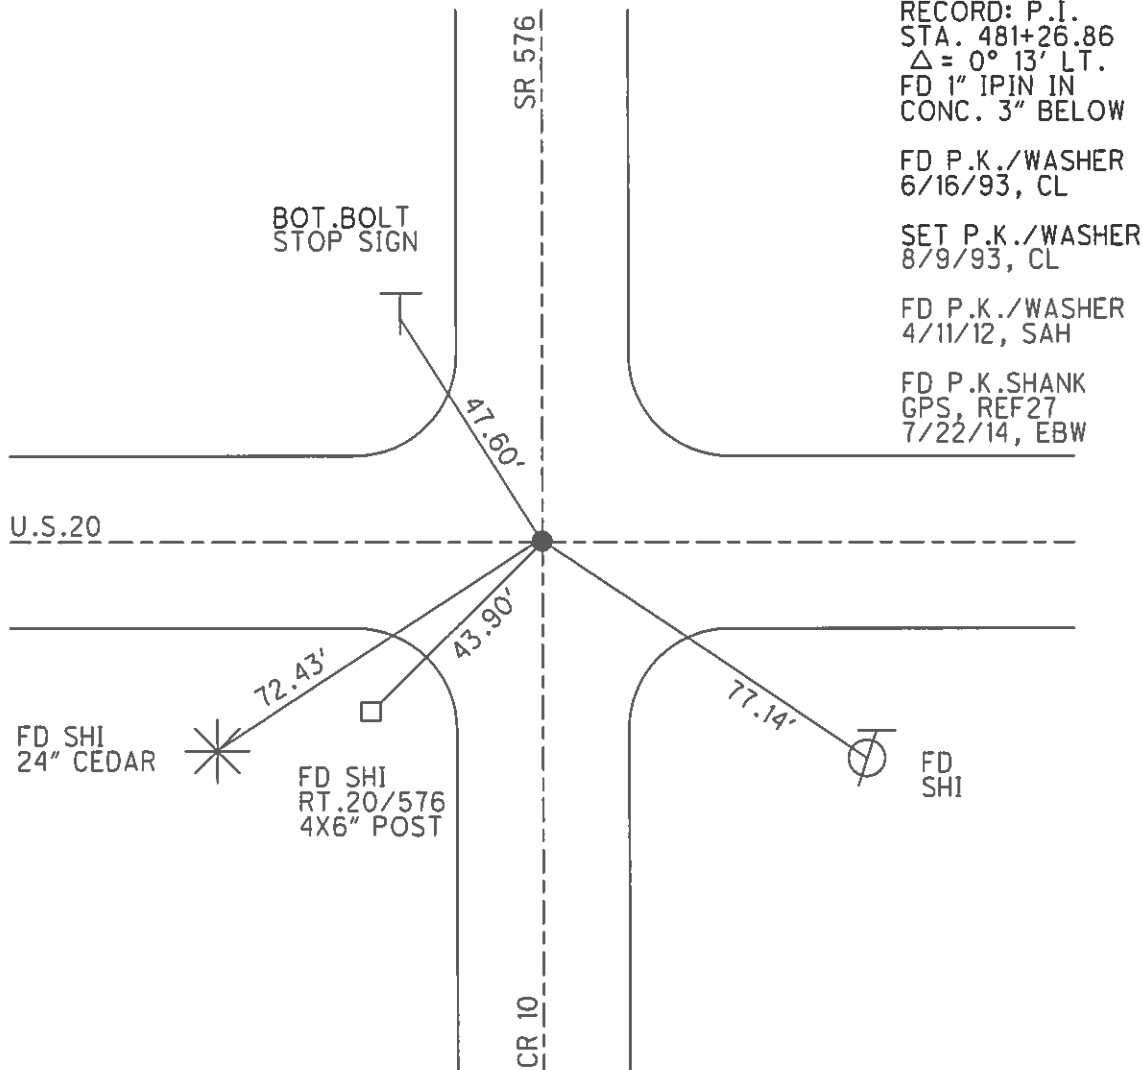

RECORD: P.I.
 STA. 481+26.86
 $\Delta = 0^\circ 13' \text{ LT.}$
 FD 1" IPIN IN
 CONC. 3" BELOW
 FD P.K./WASHER
 6/16/93, CL
 SET P.K./WASHER
 8/9/93, CL
 FD P.K./WASHER
 4/11/12, SAH
 FD P.K. SHANK
 GPS, REF27
 7/22/14, EBW