



O.D.O.T. DISTRICT 2 SURVEY OFFICE (USE ONLY)

PERSONNEL _____ REFERENCE NO. 28 SHEET 3 OF 10
 NOTES HUSS DATE 4/24/12 ROUTE US 20
 H.C. CANTERBURY WEATHER CLEAR-WINDY COUNTY WILLIAMS
 R.C. HARBAUGH TEMP. 51° TOWNSHIP BRIDGEWATER
 _____ SECTION 35
 _____ T 9 S R 3 W

TYPE MONUMENT P.K.SHANK
 ON SURFACE - ~~BELOW~~ ON
 LEFT - ☉ PAV'T - RIGHT ON
12.0' TO RT EDGE PAVEMENT
 S.L.M. 507+56.45

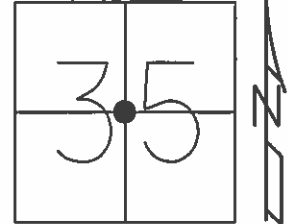

Grid: Northing: 727283.692 Easting: 1388747.098

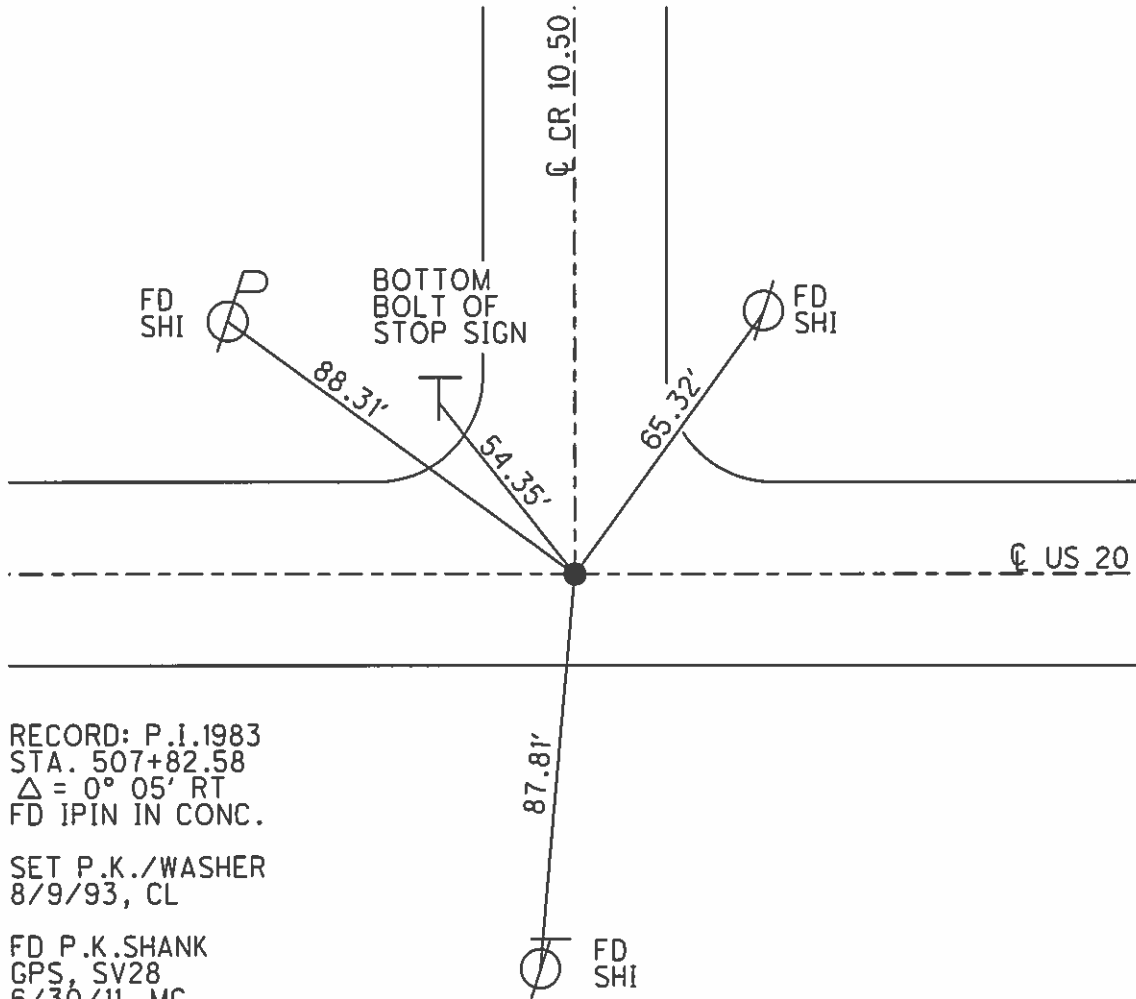

RECORD: P.I.1983
 STA. 507+82.58
 $\Delta = 0^\circ 05' RT$
 FD IPIN IN CONC.

SET P.K./WASHER
 8/9/93, CL

FD P.K.SHANK
 GPS, SV28
 6/30/11, MC

SET MAG/WASHER
 GPS, NEWREF28
 8/1/12, SAH