



O.D.O.T. DISTRICT 2 SURVEY OFFICE (USE ONLY)

PERSONNEL _____ REFERENCE NO. 31 SHEET 7 OF 10
 NOTES HUSS DATE 4/24/12 ROUTE US 20
 H.C. CANTERBURY WEATHER CLEAR-WINDY COUNTY WILLIAMS
 R.C. HARBAUGH TEMP. 52° TOWNSHIP BRIDGEWATER
 _____ SECTION 36
 _____ T 9 S R 3 W

TYPE MONUMENT P.K.NAIL
 ON SURFACE - ~~BELOW~~ ON
 LEFT - ☉ PAV'T - ~~RIGHT~~ 1.3'
 _____ TO _____ EDGE PAVEMENT
 S.L.M. 587+01.18

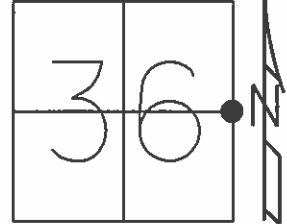

Grid: Northing: 727122.425 Easting: 1396690.067

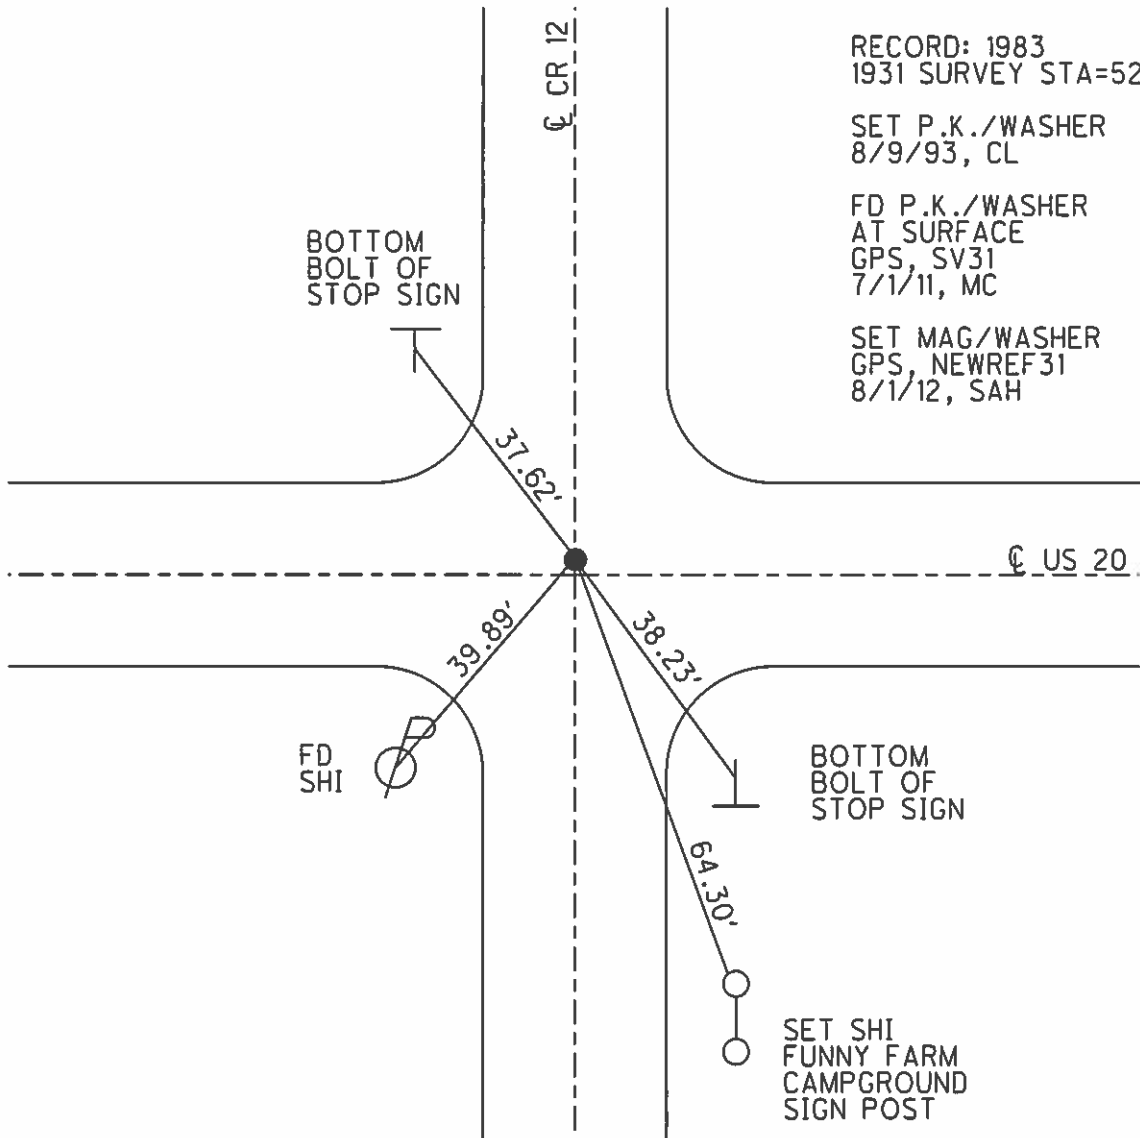

RECORD: 1983
 1931 SURVEY STA=52+89
 SET P.K./WASHER
 8/9/93, CL
 FD P.K./WASHER
 AT SURFACE
 GPS, SV31
 7/1/11, MC
 SET MAG/WASHER
 GPS, NEWREF31
 8/1/12, SAH