

O.D.O.T. DISTRICT 2 SURVEY OFFICE (USE ONLY)

PERSONNEL

REFERENCE NO. 34

SHEET 10 OF 10

NOTES NIESE DATE 3/22/21
 H.C. AUBLE WEATHER FAIR
 R.C. NIESH TEMP. 52°

ROUTE US 20
 COUNTY WILLIAMS
 TOWNSHIP BRIDGEWATER
 SECTION 31
 T 9 S R 3 W

DWG BY RHOADES PID 95998

TYPE MONUMENT P.K.SHANK

ON SURFACE - ~~BELOW~~ ON

OFFSET ☉ PAVEMENT ON LT : RT

12.4' TO RT EDGE PAVEMENT


STATION: 641+14.79

HORZ.DATUM: NAD83 2011

GEOID: NAVD88 2012A


GRID: NORTHING: 727013.129

EASTING: 1401991.205

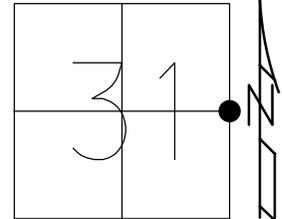

RECORD: P.I.
 FD 3/4" IPIPE
 1988
 SET SM.R.R.SPIKE
 5/31/88, MDB
 FD SM.R.R.SPIKE
 0.2' DOWN
 5/4/98, SAH
 SET P.K./WASHER
 11/12/98, BVD
 FD P.K.SHANK
 SV34
 7/1/11, MC
 SET MAG/WASHER
 NEWREF34
 8/2/12, SAH
 FD P.K.NAIL
 REF1
 12/14/18, JLL
 SET MAG/WASHER
 10/26/21, DSA
 FD MAG/WASHER
 10/19/22, JMR


NOTE: US 20A REF 1

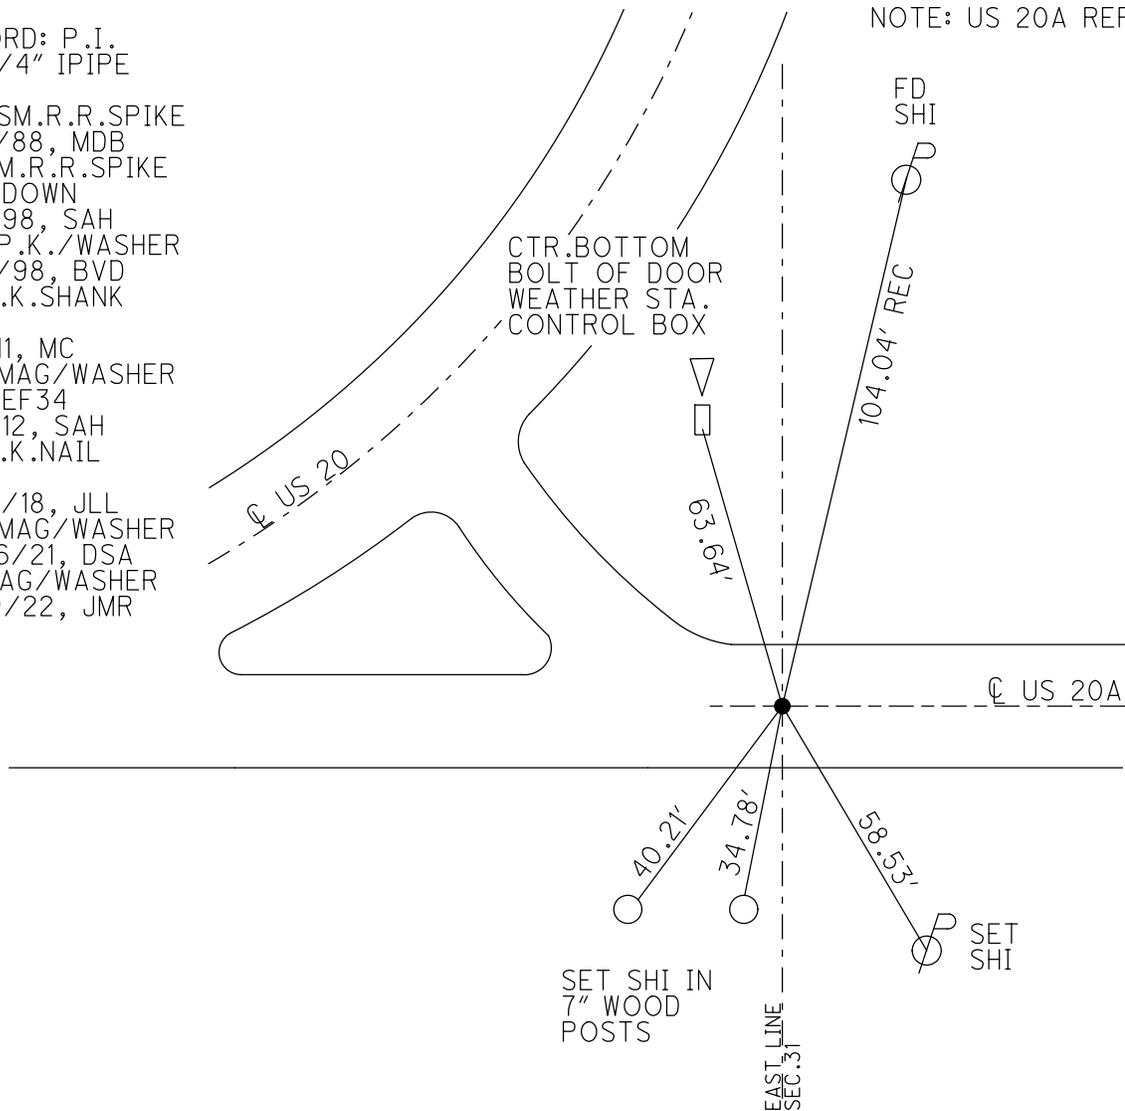

O.D.O.T. DISTRICT 2 SURVEY OFFICE (USE ONLY)

PERSONNEL	REFERENCE NO. <u>34</u>	SHEET <u>10</u> OF <u>10</u>
NOTES <u>NIESE</u>	DATE <u>3/22/21</u>	ROUTE <u>US 20</u>
H.C. <u>AUBLE</u>	WEATHER <u>FAIR</u>	COUNTY <u>WILLIAMS</u>
R.C. <u>NIESH</u>	TEMP. <u>52°</u>	TOWNSHIP <u>BRIDGEWATER</u>
DWG BY <u>RHOADES</u>	PID <u>95998</u>	SECTION <u>31</u>
		T <u>9</u> S R <u>3</u> W


TYPE MONUMENT P.K.SHANK
 ON SURFACE - ~~BELOW~~ ON
 OFFSET ☉ PAVEMENT ON LT : RT
12.4' TO RT EDGE PAVEMENT
 STATION: 641+14.79

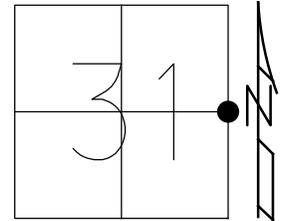

HORZ.DATUM: NAD83 2011 GEOID: NAVD88 2012A
 GRID: NORTHING: 727013.129 EASTING: 1401991.205

- RECORD: P.I.
- FD 3/4" IPIPE
- 1988
- SET SM.R.R.SPIKE
- 5/31/88, MDB
- FD SM.R.R.SPIKE
- 0.2' DOWN
- 5/4/98, SAH
- SET P.K./WASHER
- 11/12/98, BVD
- FD P.K.SHANK
- SV34
- 7/1/11, MC
- SET MAG/WASHER
- NEWREF34
- 8/2/12, SAH
- FD P.K.NAIL
- REF1
- 12/14/18, JLL
- SET MAG/WASHER
- 10/26/21, DSA

NOTE: US 20A REF 1

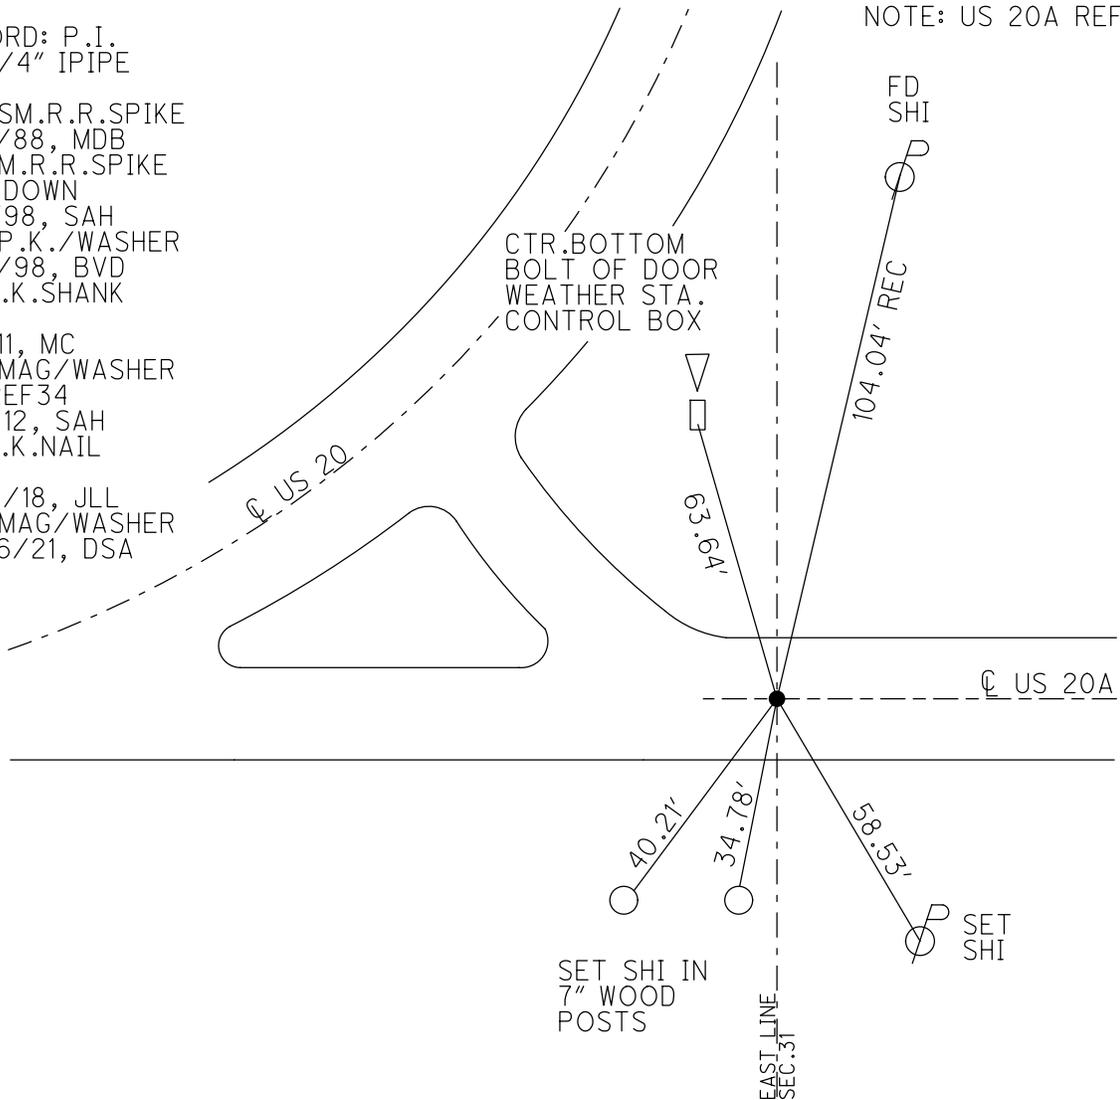

O.D.O.T. DISTRICT 2 SURVEY OFFICE

PERSONNEL

REFERENCE NO. 1

SHEET 1 OF 3

NOTES S. Huss

H.C. B. VanDusen

R.C. S. Huss

DATE 5-4-98

WEATHER Clidy-Rain

TEMP. +58° F.

ROUTE 20 A

COUNTY Williams

TOWNSHIP Bridgewater

SECTION 31

T 9 S R 2 W


TYPE MONUMENT SMALL R.R. SPK.

~~ON SURFACE~~ - BELOW 0.2'

~~WEST~~ - C. PAV'T. - ~~EAST~~ YES

13.4' TO RT. EDGE PAVEMENT

S.L.M. 5+06

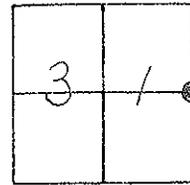

This point is also
Ref #34 for SR-20
S.M.

Set PKW BUD
11-12-98

