

O.D.O.T. DISTRICT 2 SURVEY OFFICE (USE ONLY)

PERSONNEL	REFERENCE NO.	<u>43</u>	SHEET	<u>12</u>	OF	<u>24</u>
NOTES	POORE	DATE	<u>8-03-2017</u>	ROUTE	<u>US 20</u>	
H.C.	LEU	WEATHER	<u>SUNNY</u>	COUNTY	<u>WILLIAMS</u>	
R.C.	CARSON	TEMP.	<u>75° F</u>	TOWNSHIP	<u>MADISON</u>	
	HOMAN			SECTION	<u>28</u>	
				T	<u>9</u>	S
				R	<u>2</u>	W

TYPE MONUMENT R.R.SPIKE


~~ON SURFACE~~ - BELOW 1"

LEFT - ☉ PAV'T - RIGHT ON


- TO - EDGE PAVEMENT

S.L.M. 809+75.52

Grid: Northing: 734765.002 Easting: 1412776.342

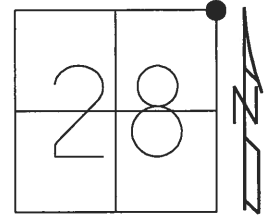

RECORD:
 1929 PLAN
 $\Delta = 0^\circ 05' \text{ LT.}$
 $\Delta = 0^\circ 07' 25'' \text{ LT (M)}$
 SET SM.R.R.SPIKE
 8-31-88, IRS
 FD SM.R.R.SPIKE
 5/6/98, SAH
 SET P.K./WASHER
 11-13-98, SAH
 FD P.K./WASHER
 7/22/05, MB
 FD R.R.SPIKE
 1" DOWN
 REF43
 5/24/16, DCH
 SET MAG/WASHER
 NEWREF43
 9-29-2017, JLL

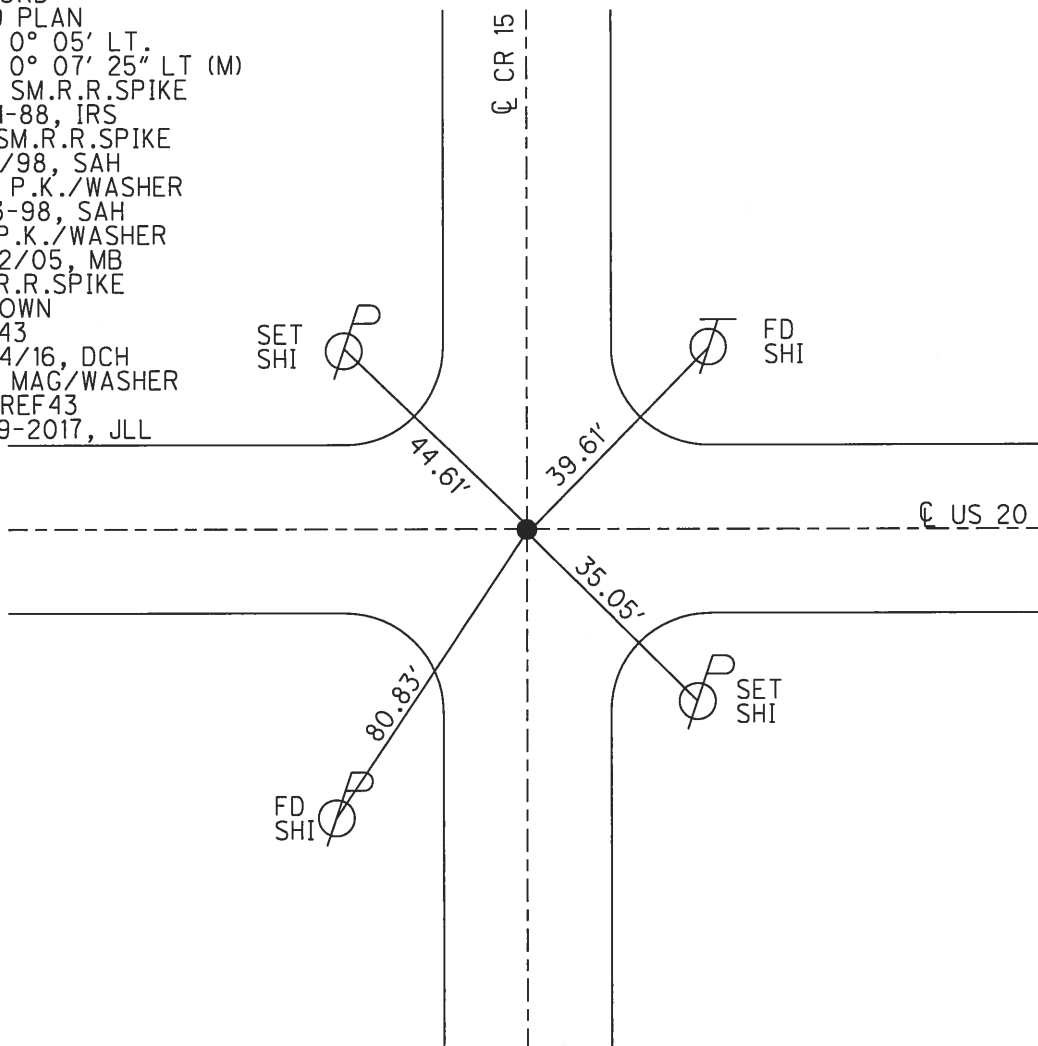

O.D.O.T. DISTRICT 2 SURVEY OFFICE

PERSONNEL _____

REFERENCE NO. 43

SHEET 11 OF 16

NOTES Huss

H.C. Van Dusen

R.C. Condes

DATE 5-6-98

WEATHER Pt. Cldy-Fair

TEMP. +62°F

ROUTE US-20

COUNTY Williams

TOWNSHIP Madison

SECTION 21-22-27-28

T 9 S R 2 W


TYPE MONUMENT SMALL RR. SPK.

ON SURFACE - ~~BELOW~~ YES

~~TO~~ - CL PAV'T. - ~~NO~~ YES


TO - EDGE PAVEMENT

S.L.M. 809+40 807+83

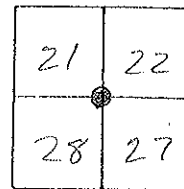

*Set Small RR. Spk.
8-31-88 TRS*

*Set Pk/W
11-13-98 SAM*

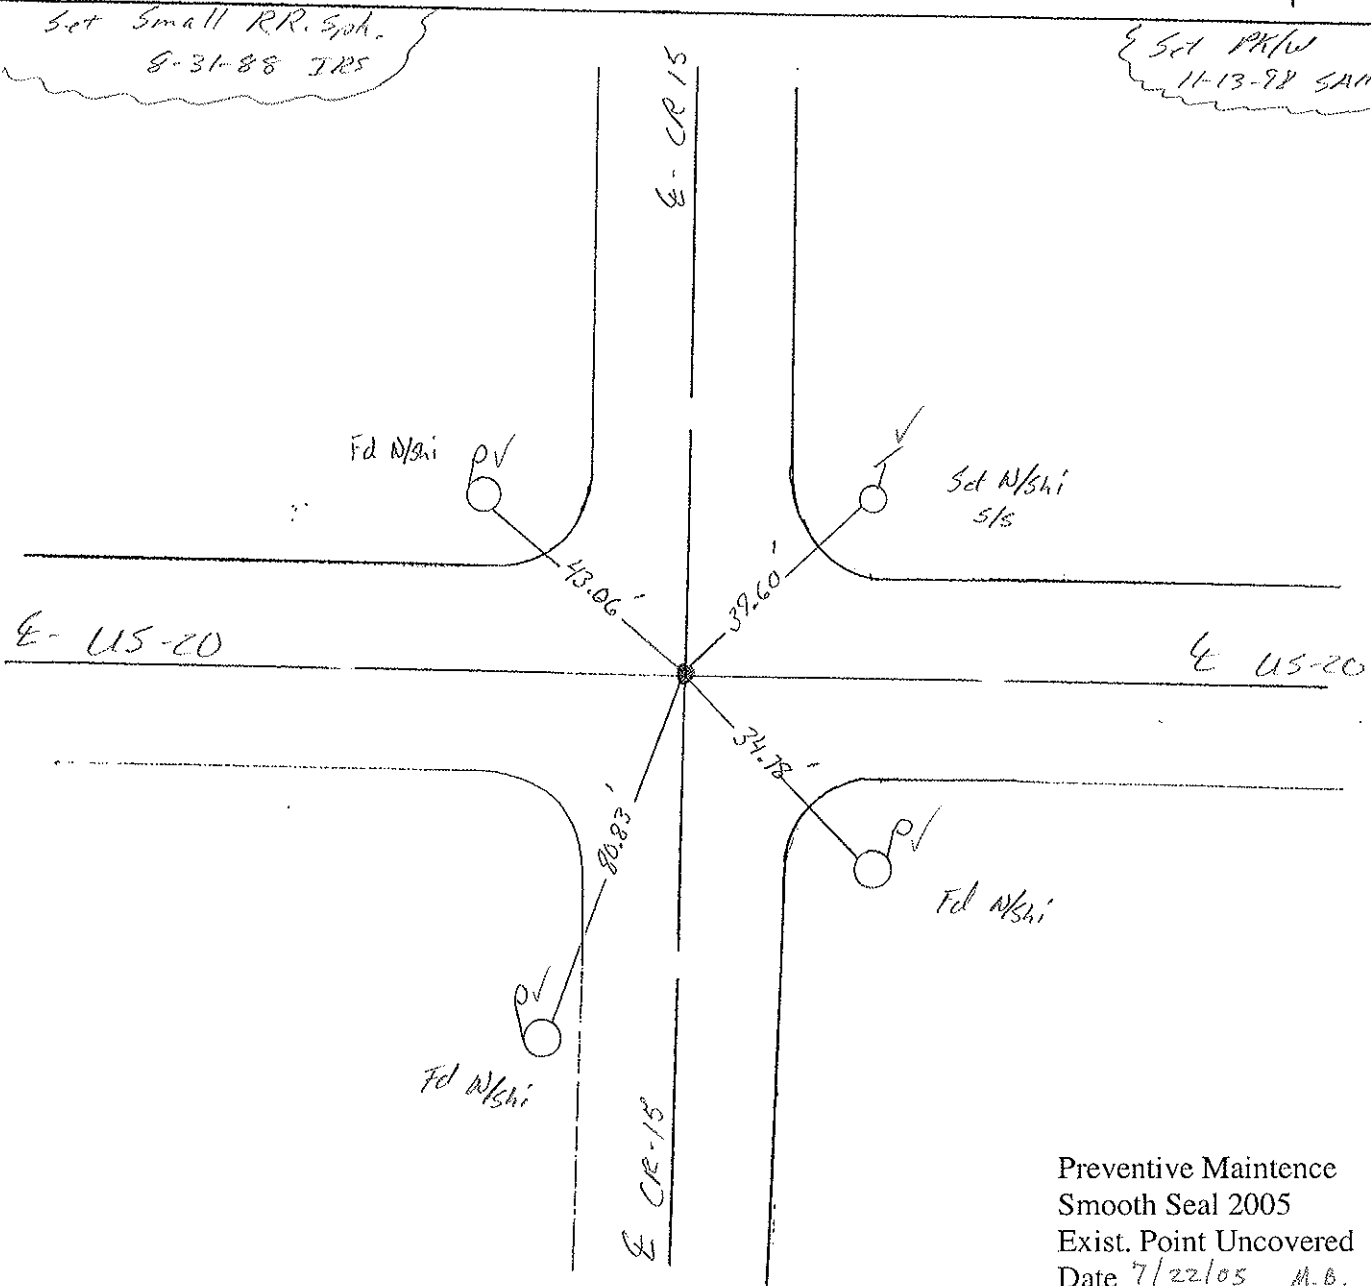

Preventive Maintenance
Smooth Seal 2005
Exist. Point Uncovered
Date 7/22/05 M.B.