


O.D.O.T. DISTRICT 2 SURVEY OFFICE (USE ONLY)


PERSONNEL _____ REFERENCE NO. 45 SHEET 15 OF 24
 NOTES POORE DATE 8-03-17 ROUTE US 20
 H.C. LEU WEATHER SUNNY COUNTY WILLIAMS
 R.C. CARSON TEMP. 80° F TOWNSHIP MADISON
 _____ SECTION 27
 _____ T 9 S R 2 W

TYPE MONUMENT P.K.NAIL
~~ON SURFACE~~ - BELOW 1 1/2"
 LEFT - ☪ PAV'T - RIGHT 0.5'
 - TO - EDGE PAVEMENT
 S.L.M. 862+56.09

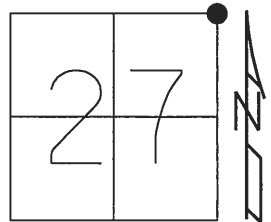

Grid: Northing: 734678.520 Easting: 1418056.184

RECORD:
 1929 PLAN
 Δ= 0° 05' RT (R)
 Δ= 0° 05' 53" RT (M)
 SET SM.R.R.SPIKE
 8-31-88, IRS
 FD SM.R.R.SPIKE
 5/6/98, SAH
 SET P.K./WASHER
 11-13-98, SAH
 FD P.K./WASHER
 7/28/05, MB
 FD P.K.NAIL
 1 1/2" DOWN
 REF45
 5/24/16, DCH
 SET MAG/WASHER
 NEWREF45
 3/14/18, JLL

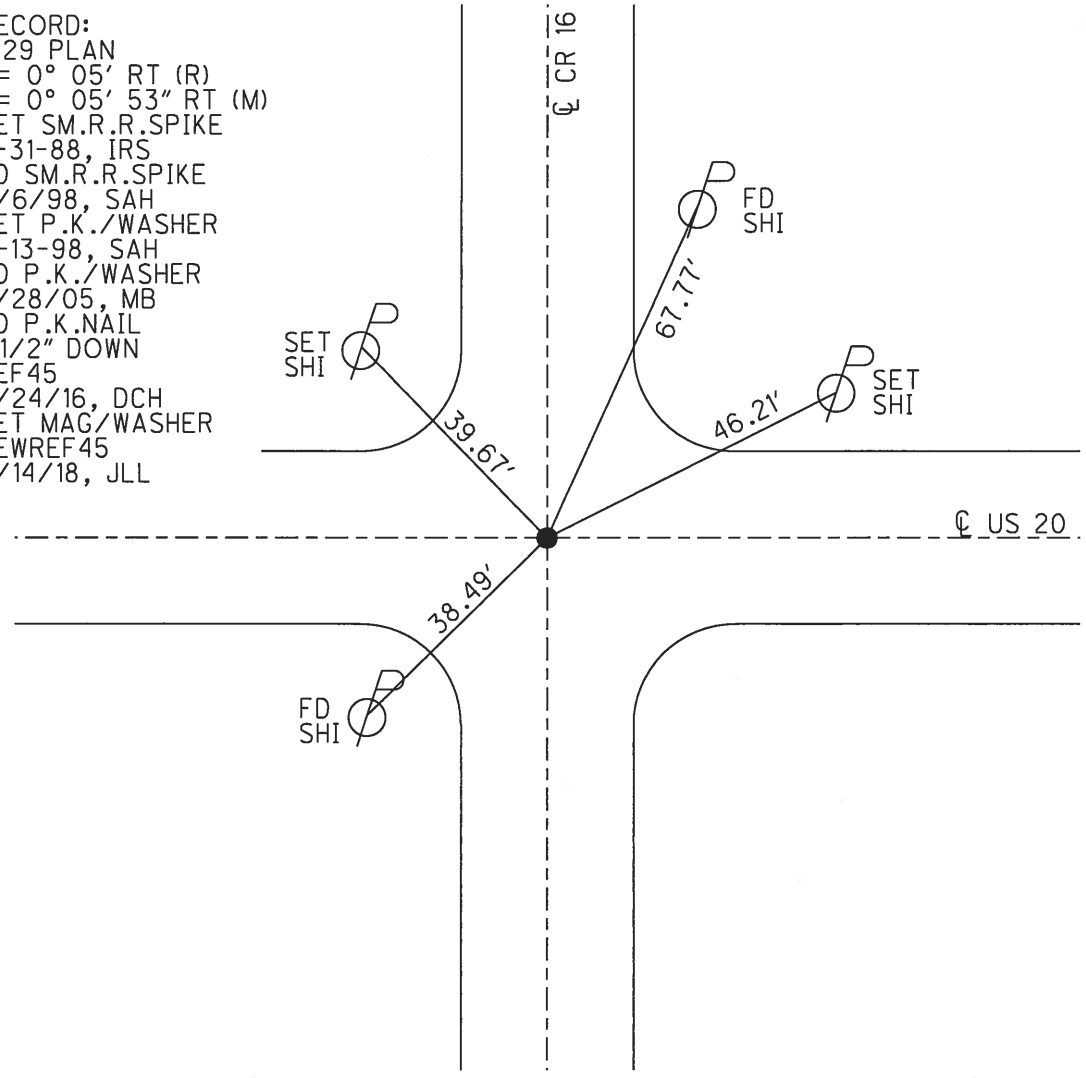

O.D.O.T. DISTRICT 2 SURVEY OFFICE

PERSONNEL _____

REFERENCE NO. 45

SHEET 14 OF 16

NOTES H_{16.52}

H.C. Van Pusey

R.C. Condris

DATE 5-6-98

WEATHER pt cldy - Fair

TEMP. +62° F

ROUTE US-20

COUNTY Williams

TOWNSHIP Madison

SECTION 22-23-26-27

T 9 S R 2 W

TYPE MONUMENT SMALL RR. SPK.

ON SURFACE - ~~BELOW~~ YES

LEFT ~~PAV'T~~ RIGHT 0.8' LT

— TO — EDGE PAVEMENT


S.L.M. 861+78 860+69

22	23
27	26



*Set Small RR. Spk.
8-31-88 IRS*

*Set PK/W
11-13-95 SAI*

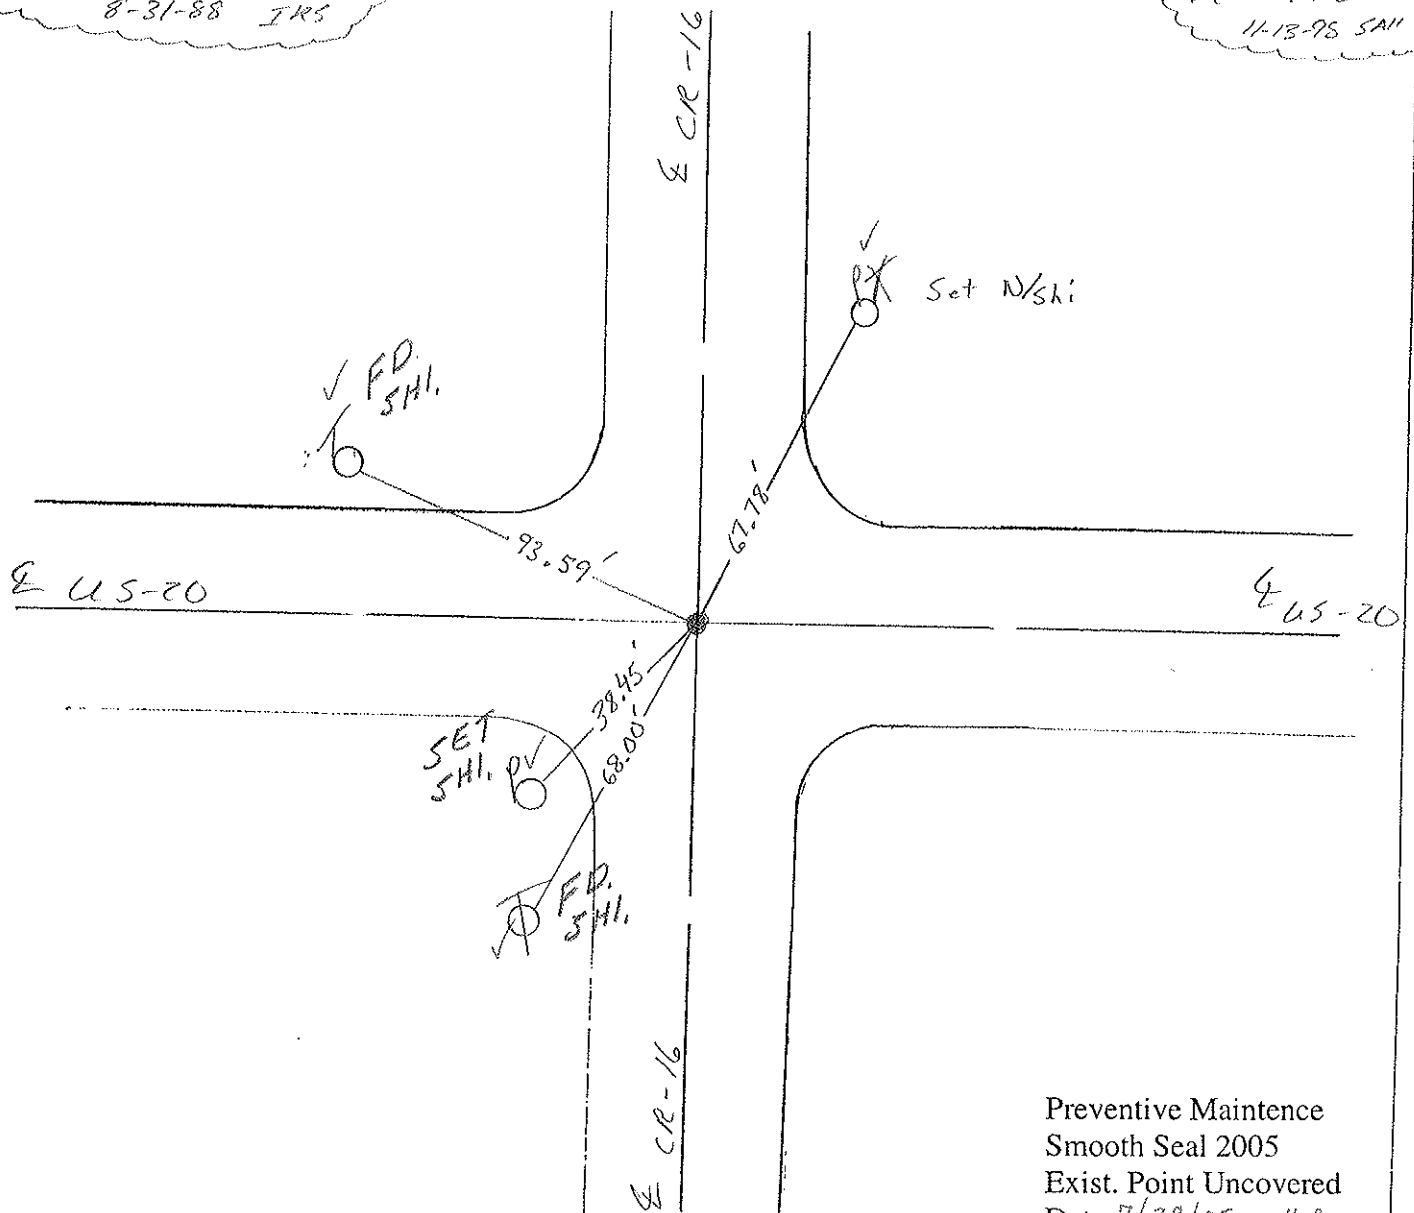

Preventive Maintenance
Smooth Seal 2005
Exist. Point Uncovered
Date 7/28/05 M.B.