
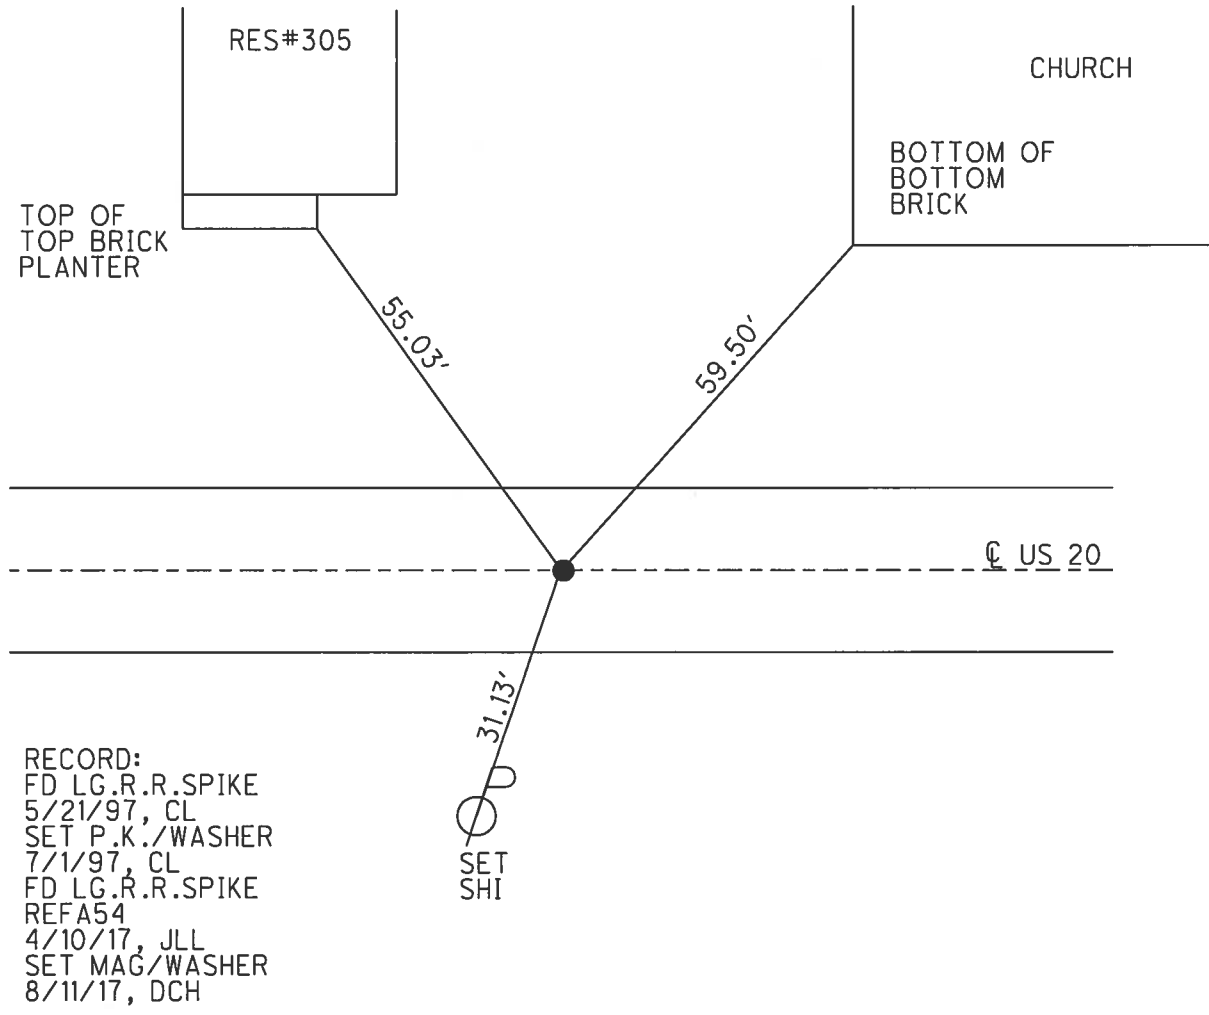


O.D.O.T. DISTRICT 2 SURVEY OFFICE (USE ONLY)

PERSONNEL _____ REFERENCE NO. 54 A SHEET 3 OF 11
 NOTES LEU DATE 4/10/2017 ROUTE US 20
 H.C. HOMAN WEATHER CLOUDY COUNTY WILLIAMS
 R.C. LEU TEMP. 65° TOWNSHIP MILLCREEK
 _____ SECTION 21
 _____ T 9 S R 1 W

TYPE MONUMENT LG.R.R.SPIKE
~~ON SURFACE~~ - BELOW 6"
 LEFT - CL PAV'T - ~~RIGHT~~ 0.5'
12.1' TO RT EDGE PAVEMENT
 S.L.M. 1081+10

Grid: Northing: 734245.231 Easting: 1439970.797

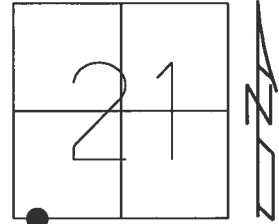

RECORD:
 FD LG.R.R.SPIKE
 5/21/97, CL
 SET P.K./WASHER
 7/1/97, CL
 FD LG.R.R.SPIKE
 REFA54
 4/10/17, JLL
 SET MAG/WASHER
 8/11/17, DCH

O.D.O.T. DISTRICT 2 SURVEY OFFICE

PERSONNEL

REFERENCE NO. 54-A

SHEET 10 OF 17

NOTES LOENRKE
 H.C. CORDES W
 R.C. HUSS
F MOSEZ

DATE 5-21-97
 WEATHER SUN
 TEMP. +50°F

ROUTE 20
 COUNTY WILLIAMS
 TOWNSHIP MILLCREEK
 SECTION 21
 T 9 S R L W

Set P.K. / WASHCO
 7-1-97

TYPE MONUMENT LG IR SPIKE
 ON SURFACE - BELOW YES
~~LEFT~~ - PAV'T. - RIGHT YES
12.1 TO RT. EDGE PAVEMENT
 S.L.M. 10814 10

