

SUMMARY OF ADDITIONAL RIGHT OF WAY REQUIRED

2 of 5

STATE JOB NO.	FED. RD. DIVISION	STATE	PROJECT
	2	OHIO	




WIL-34 (1.48-2.48)

PARCEL NO.	OWNER	TOTAL NO. OWNERS-			TOTAL NO. COMPLETE TAKES-				TOTAL OWNERS WITH STRUCTURES INVOLVED-				SHEET NO.	REMARKS	OTHER DESIGNATED EASEMENTS	TYPE FUND			
		DEED RECORD			DEED AREA	TOTAL TAKE		PRO IN TAKE		NET TAKE		NET RES. LT.					NET RES. RT.		
		BOOK	PAGE	DATE		Acres	Sq.Ft.	Acres	Sq.Ft.	Acres	Sq.Ft.	Acres					Sq.Ft.	Acres	Sq.Ft.
28 WA	Harold F. & Ruth E. Lasch	187	477		0.201									53	378 Sq. Ft., 0.009 Act, Repair drive and sidewalk				
29	Ernest & Gladys Held				0.141									53	No Take				
30	Melvin N. & Willene M. Held				0.144									53	No Take				
31	William & Thelma Herman				0.156									53, 54	No Take				
32 WA	Board of Education, Village of Edon	145 140	905 332		1.190									53	80 Sq. Ft., 0.002 Act, Repair sidewalk				
32 WA-1		119 42	543 347											53	75 Sq. Ft., 0.002 Act, Repair sidewalk				
33 WA	Burl J. Knapp	126	410		0.200									53	75 Sq. Ft., 0.002 Act, Repair sidewalk				
34	Otto L. & Cora Caskey				0.182									53, 54	No Take				
35	Freeman R. & Irma I. Imhof	133	171		0.633									54	No Take				
35A WA					0.200									54	50 Sq. Ft., 0.001 Act, Repair sidewalk				
36 WA	Ronald & Judith Long	219	569		0.221									54	12.5 Sq. Ft., 0.001 Act, Repair sidewalk				
37 WA	Herman G. & Esther Kaltenbach	218	679		0.200									54	12.5 Sq. Ft., 0.001 Act, Repair sidewalk				
38	Helen L. Knepper				0.200									54	No Take				
39	Cretors & Kundard Funeral Service				0.200									54	No Take				
40 WA	Cameron Hospitals, Inc.	179	118		0.200									54	50 Sq. Ft., 0.001 Act, Repair sidewalk				
41 WA	Marvin Silas Beach	191	373		0.248									54	50 Sq. Ft., 0.001 Act, Repair sidewalk				
42	Lenora Foster				0.218									54	No Take				
43 WA	William M. Dewire	205 196 196 155	812 64 33 131		0.200									54	12.5 Sq. Ft., 0.001 Act, Repair sidewalk				
44	James R. & Cardlyn Van De Voorde				0.200									54	No Take				
45	Richard L. Alwood				0.173									54	No Take				
46 WA	Thelma Reas	222	254 258		0.227									54	200 Sq. Ft., 0.005 Act, Repair sidewalk and grade yard				
47 WA	Cardinal & Blanche E. Wolff	196	433		0.400									54	1620 Sq. Ft., 0.037 Act, Repair sidewalk and grade yard				
47A	Cardinal & Blanche E. Wolff				0.036									54	No Take				
47B WA	Cardinal Wolff	178	67		0.200									54	50 Sq. Ft., 0.001 Act, Grade yard				

SUMMARY OF ADDITIONAL RIGHT OF WAY REQUIRED

4 of 5

STATE JOB NO.	FED. RD. DIVISION	STATE	PROJECT
	2	OHIO	

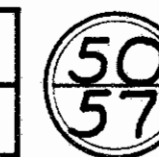

WIL-34 (1.48-2.48)


Returned 1/24/69

PARCEL NO.	OWNER	TOTAL NO. OWNERS-			TOTAL NO. COMPLETE TAKES-						TOTAL OWNERS WITH STRUCTURES INVOLVED-						REMARKS	OTHER DESIGNATED EASEMENTS	TYPE FUND
		DEED BOOK	RECORD PAGE	DATE	DEED AREA	TOTAL PRO	TOTAL TAKE	PRO IN TAKE	NET TAKE	NET RES. LT.	NET RES. RT.	BLDG'S TO BE ACQ'D	SHEET NO.						
70 WA	Gertrude A. & Garnet E. Houk	195	309		0.059											55	351 Sq. Ft., 0.008 Ac., Repair drive & sidewalk and grade yard		
71 WA	Paul Joseph Fry & Mary Ida Fry	191 223	429 219		0.164											55	358 Sq. Ft., 0.008 Ac., Repair drive & sidewalk and grade yard		
72	John H. Burkhardt				0.187											55	No Take		
73	Ramona L. Luce, % Edon State Bank				0.988											55	No Take		
74 WA	Bessie F. Burkhardt	205	313 317		0.566											55	125 Sq. Ft., 0.003 Ac., Repair sidewalk		
75	Albert Reas				1.456											55	No Take		
76	Franklin Michael, ET AL				0.448											55	No Take		
77	Dean Patterson Clark				0.582											55	No Take		
78	Eileen E. Kannel	168 168	176 208		0.464											55	No Take		
78A WA	Richard L. & Virginia Will	226	6		0.436											55	180 Sq. ft., 0.004 Ac., Repair drive & sidewalk and grade yard		
79 WA	Clair D. & Neva J. Hackett	150	459		0.450											55	660 Sq. Ft., 0.015 Ac., Repair drive & sidewalk and grade yard		
80 WA	Leroy F. & Marilyn Dee Held	190	405		0.610											55,56	990 Sq. Ft., 0.022 Ac., Repair drive & sidewalk and grade yard		
81 WA	Hazel E. Oberlin	196	445		0.546											55	175 Sq. Ft., 0.004 Ac., Repair sidewalk		
82	Melmath Earl Stokes				0.259											55	No Take		
83	K. & Luella Lautzenheiser				0.250											55	No Take		
84	Blanche L. Brown				0.489											55	No Take		
85	Lowell L. & Mildred L. Davis				0.459											55	No Take		
86 WA	Omer G. & Rachel L. Keller	218	1018		0.415											55,56	50 Sq. Ft., 0.001 Ac., Repair sidewalk		
87	James L. Mann				4.680											56	No Take		
88	Ray & Hazel Wheeler				0.250											56	No Take		
89	Donald & Juanita Kaiser				0.200											56	No Take		
90	Victor L. Friskney				0.300											56	No Take		

SEC. 17, FLORENCE TWP, T 7 N, R 1 E

HUBERT H. & MYRREL M. MYERS
120 AC.

Deed Area = 120.000 Ac±
Total P.R.O. = 1.818 Ac±
Total Take = 0.053 Ac±
P.R.O. in Take = 0.042 Ac±
Net Take = 0.011 Ac±
Residue = 118.171 Ac±

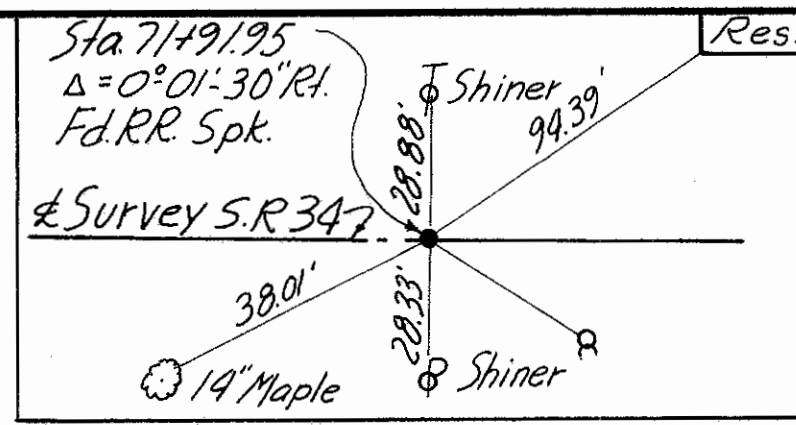

FED. RD. DIVISION	STATE	PROJECT
2	OHIO	

Wil 34-(148-2.48)

52
57

BEGIN SHEET
STA. 66+00

BEGIN SHEET
STA. 72+00

BEGIN SHEET
STA. 72+00

BEGIN SHEET
STA. 72+00

END SHEET
STA. 72+00

END SHEET
STA. 78+00

END SHEET
STA. 78+00

No.	REVISION	DATE	BY

SEC. 20, FLORENCE TWP, T 7 N, R 1 E
SEC. 17, VILLAGE OF EDON, T 7 N, R 1 E

ZELLA A. ROCKEY
44 AC.


FRANK A. & IRENE WALZ
35.43 AC.

Deed Area = 0.660 Ac±
Total P.R.O. = 0.087 Ac±
Total Take = 0.130 Ac±
P.R.O. in Take = 0.087 Ac±
Net Take = 0.043 Ac±
Residue = 0.530 Ac±

JOSEPH A. & VELVA D. WOLFF
0.66 AC±


DOROTHY KAISER
4 AC.

FRANK A. & IRENE WALZ
13 AC.

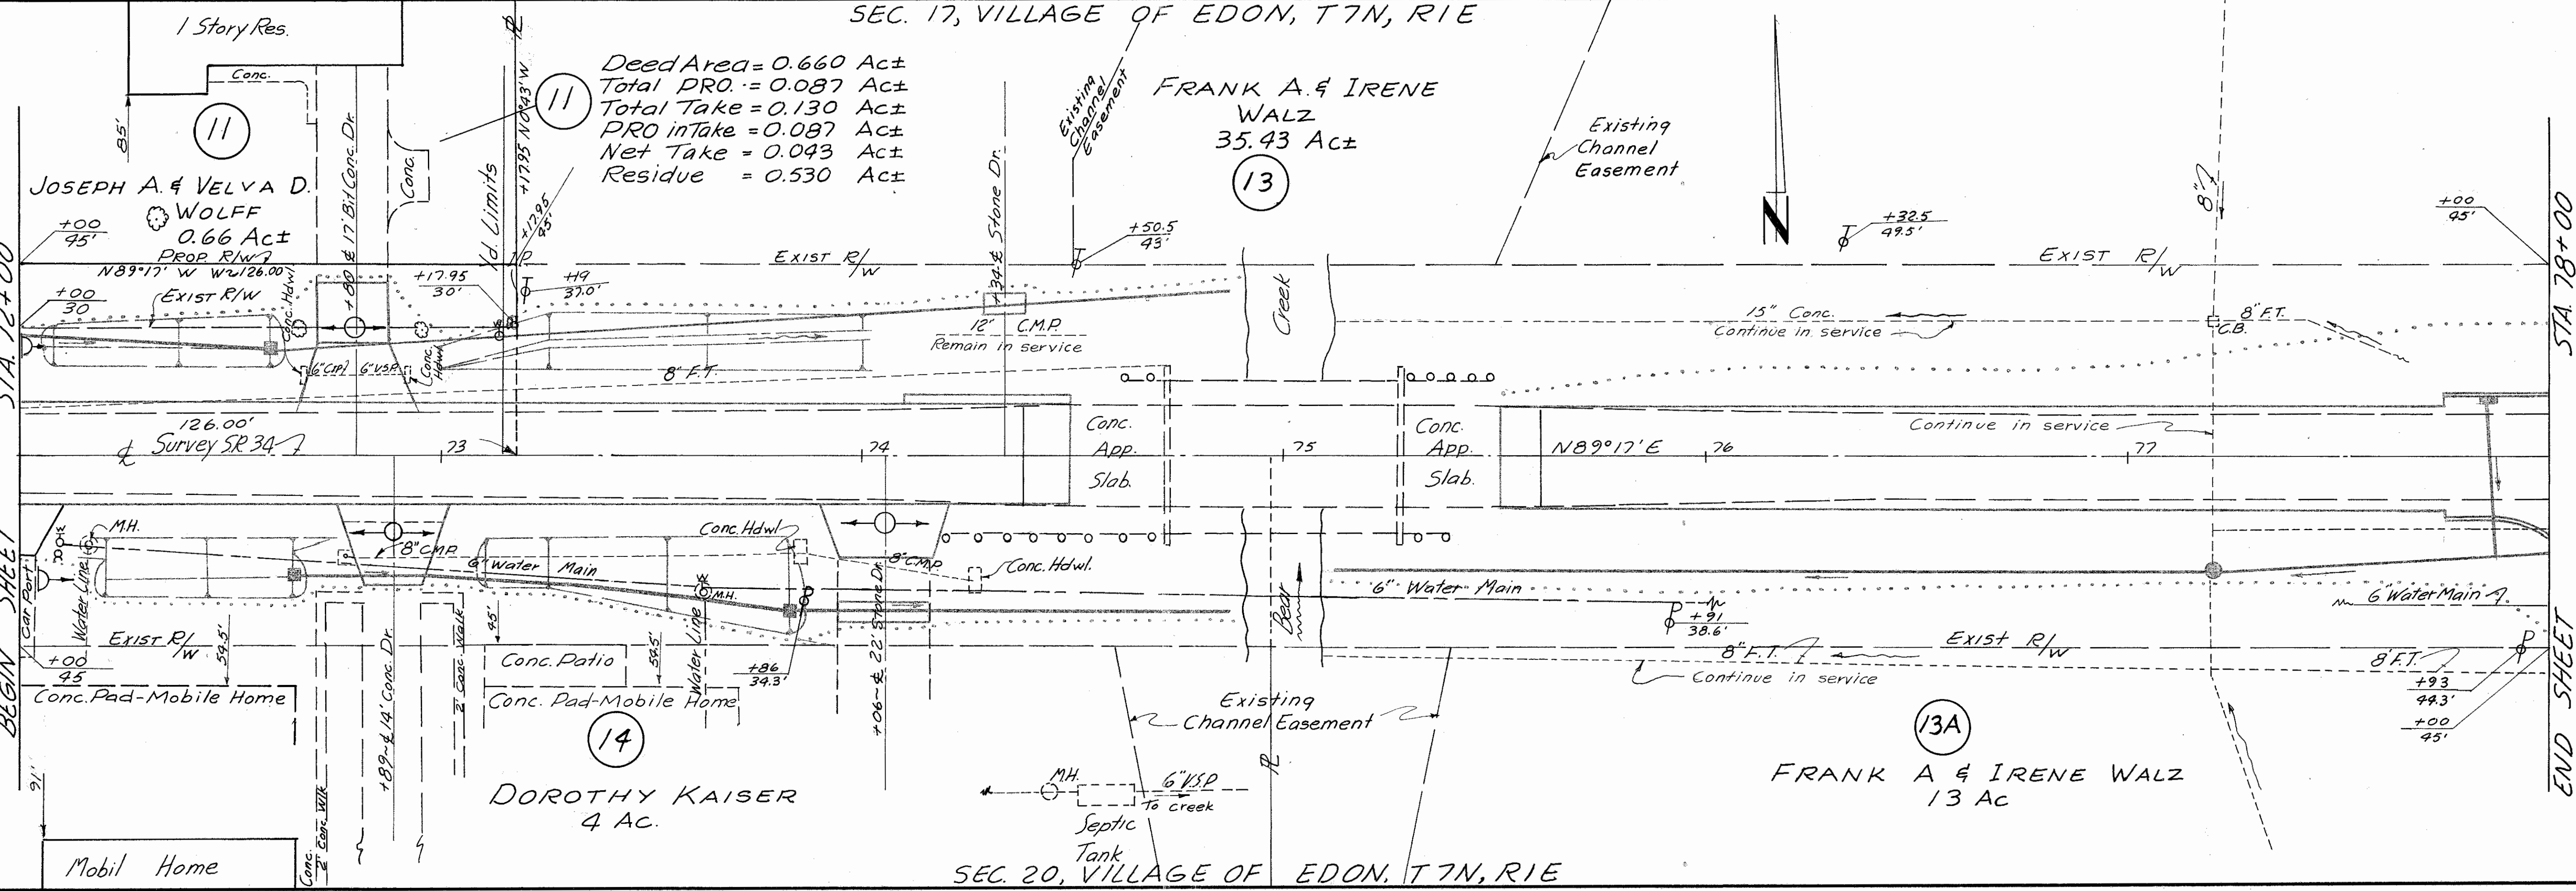

Viewed July 1977

FED. RD. DIVISION	STATE	PROJECT	53 57
2	OHIO	WIL-34-(1.48-2.48)	

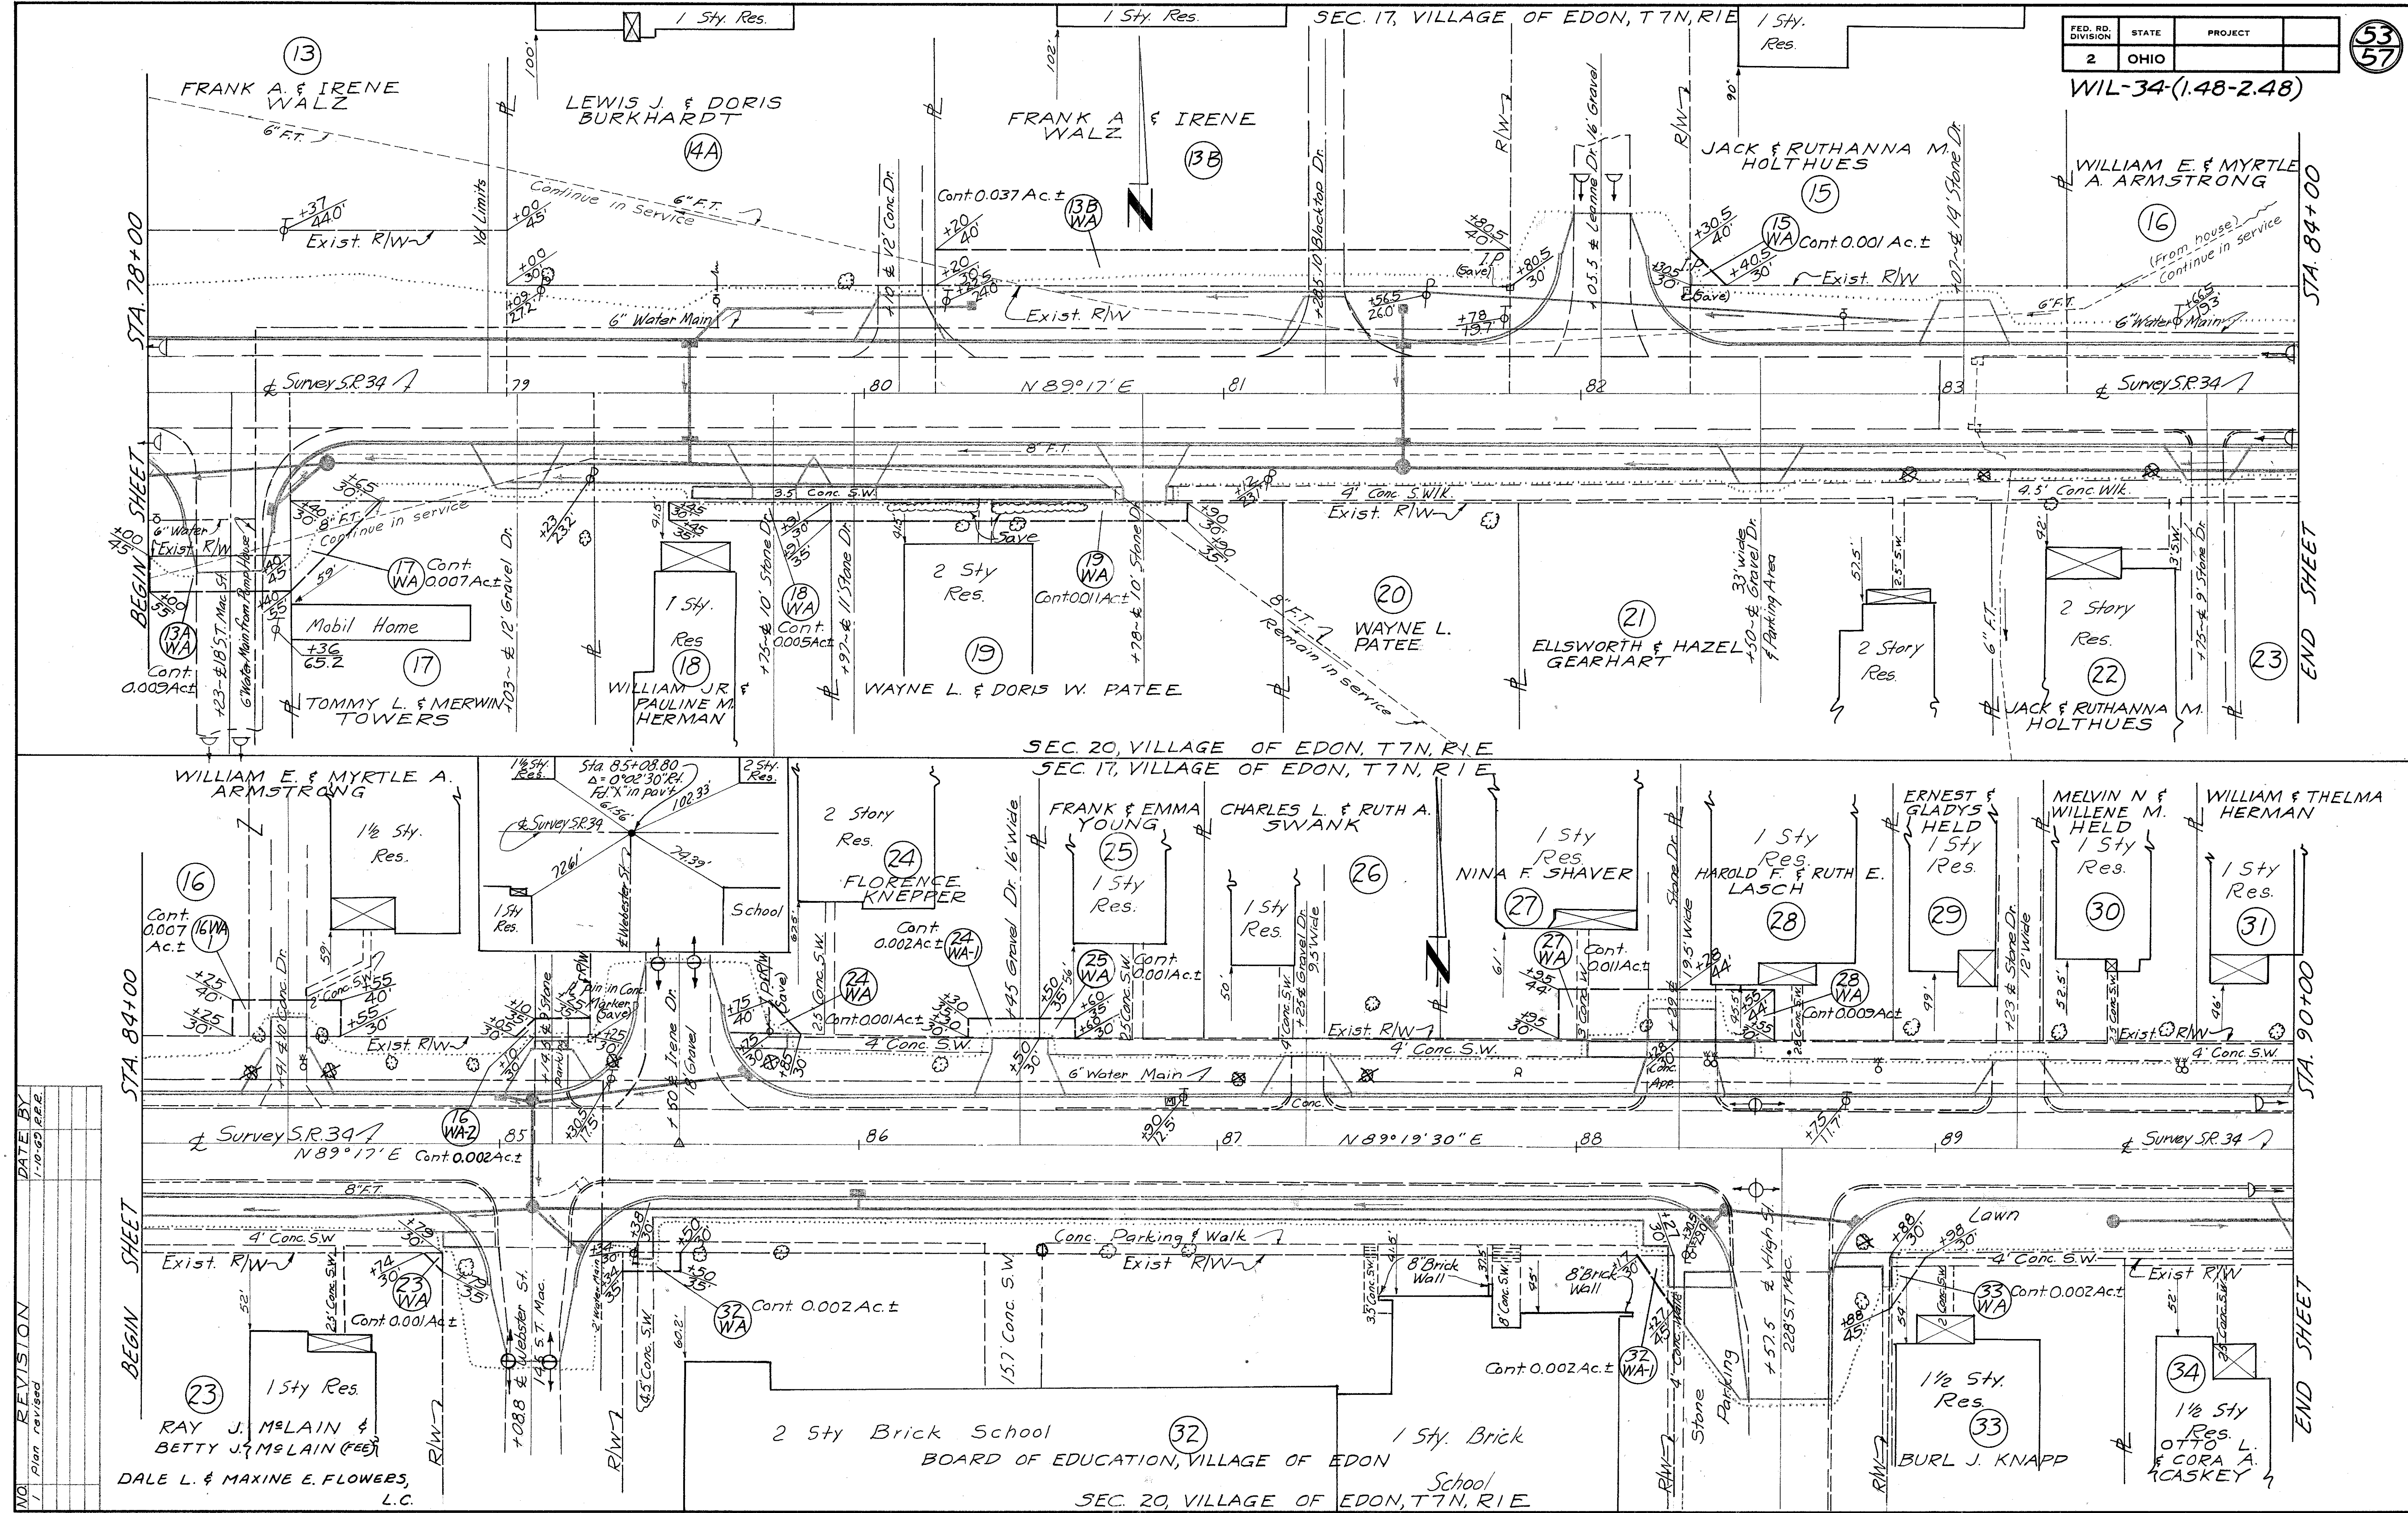

NO.	REVISION	DATE BY
1	Plan revised	1-10-01 R.E.E.

STA. 78+00

STA. 84+00

BEGIN SHEET

BEGIN SHEET

STA. 84+00

END SHEET



STA. 90+00

END SHEET

3/11/2010
10:17

FED. RD. DIVISION	STATE	PROJECT
2	OHIO	

54
57

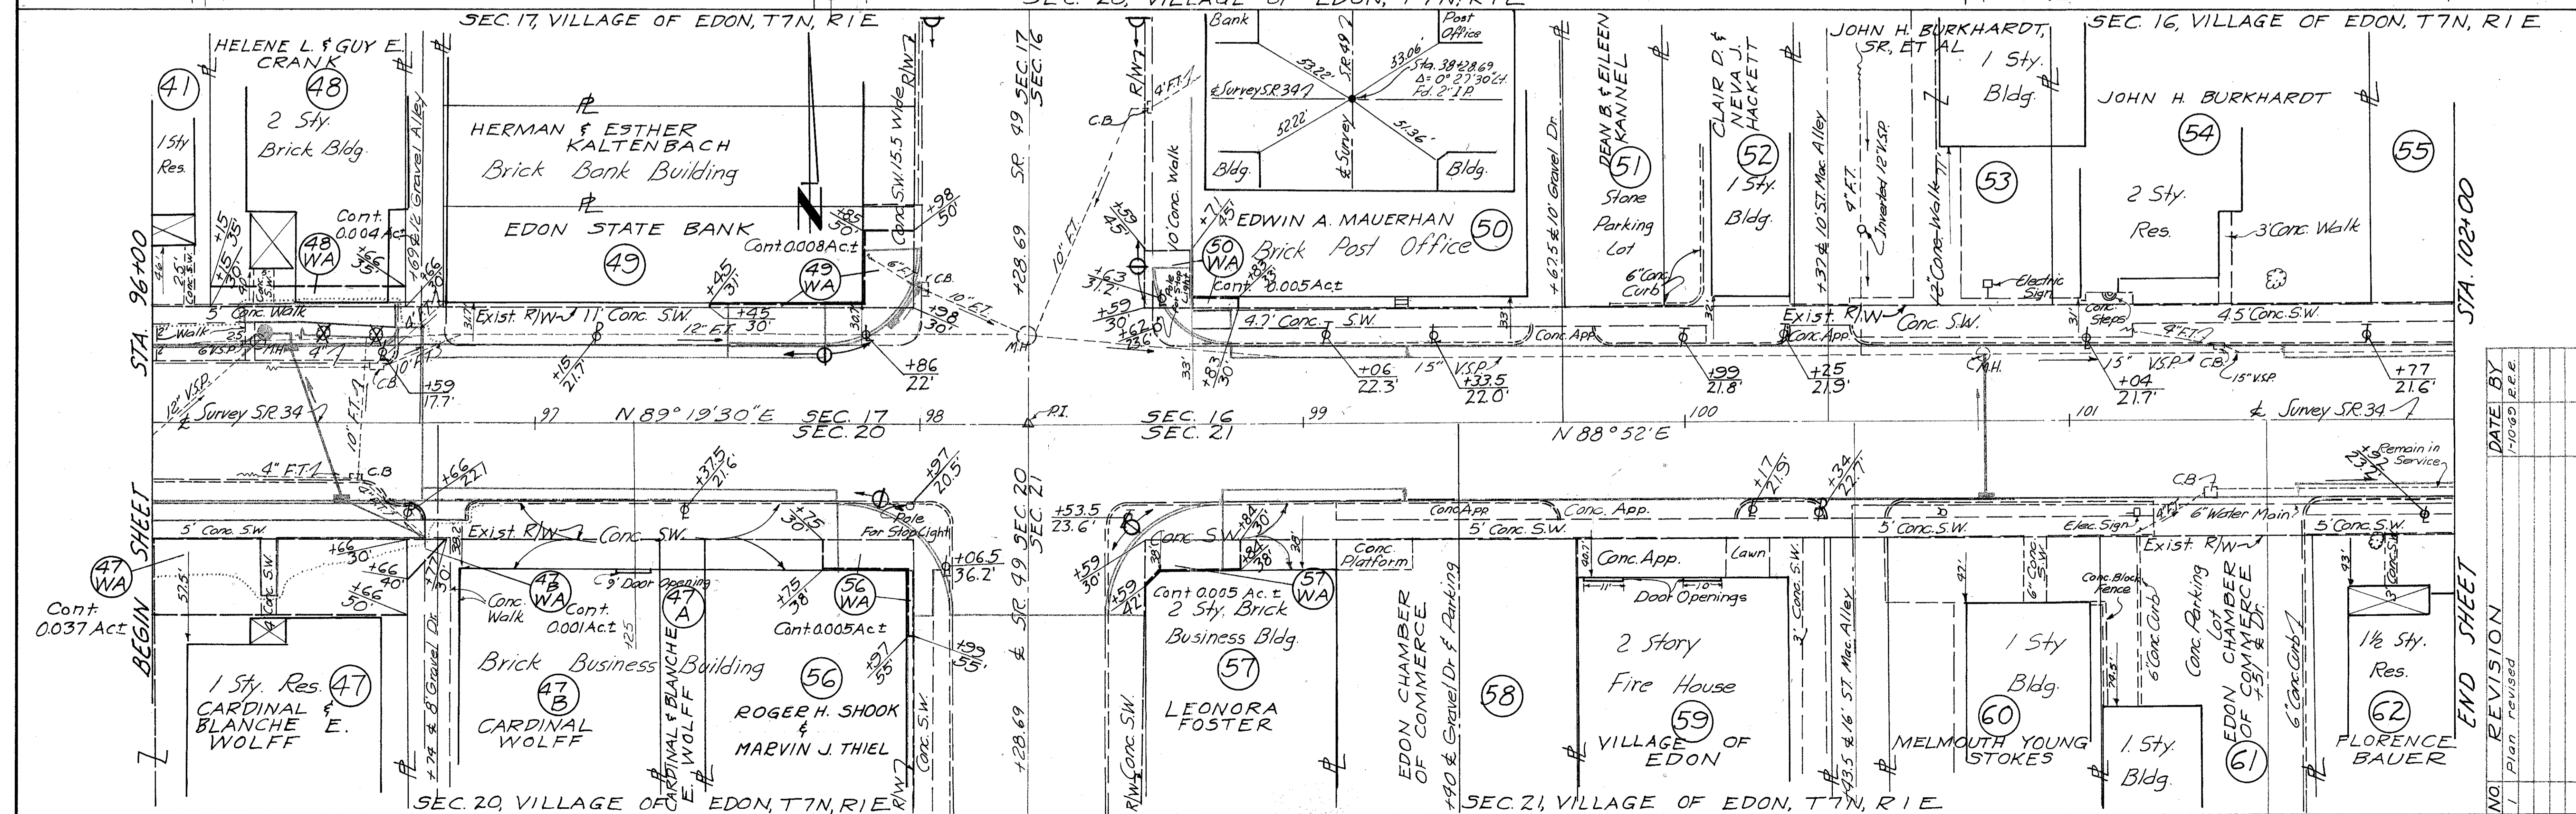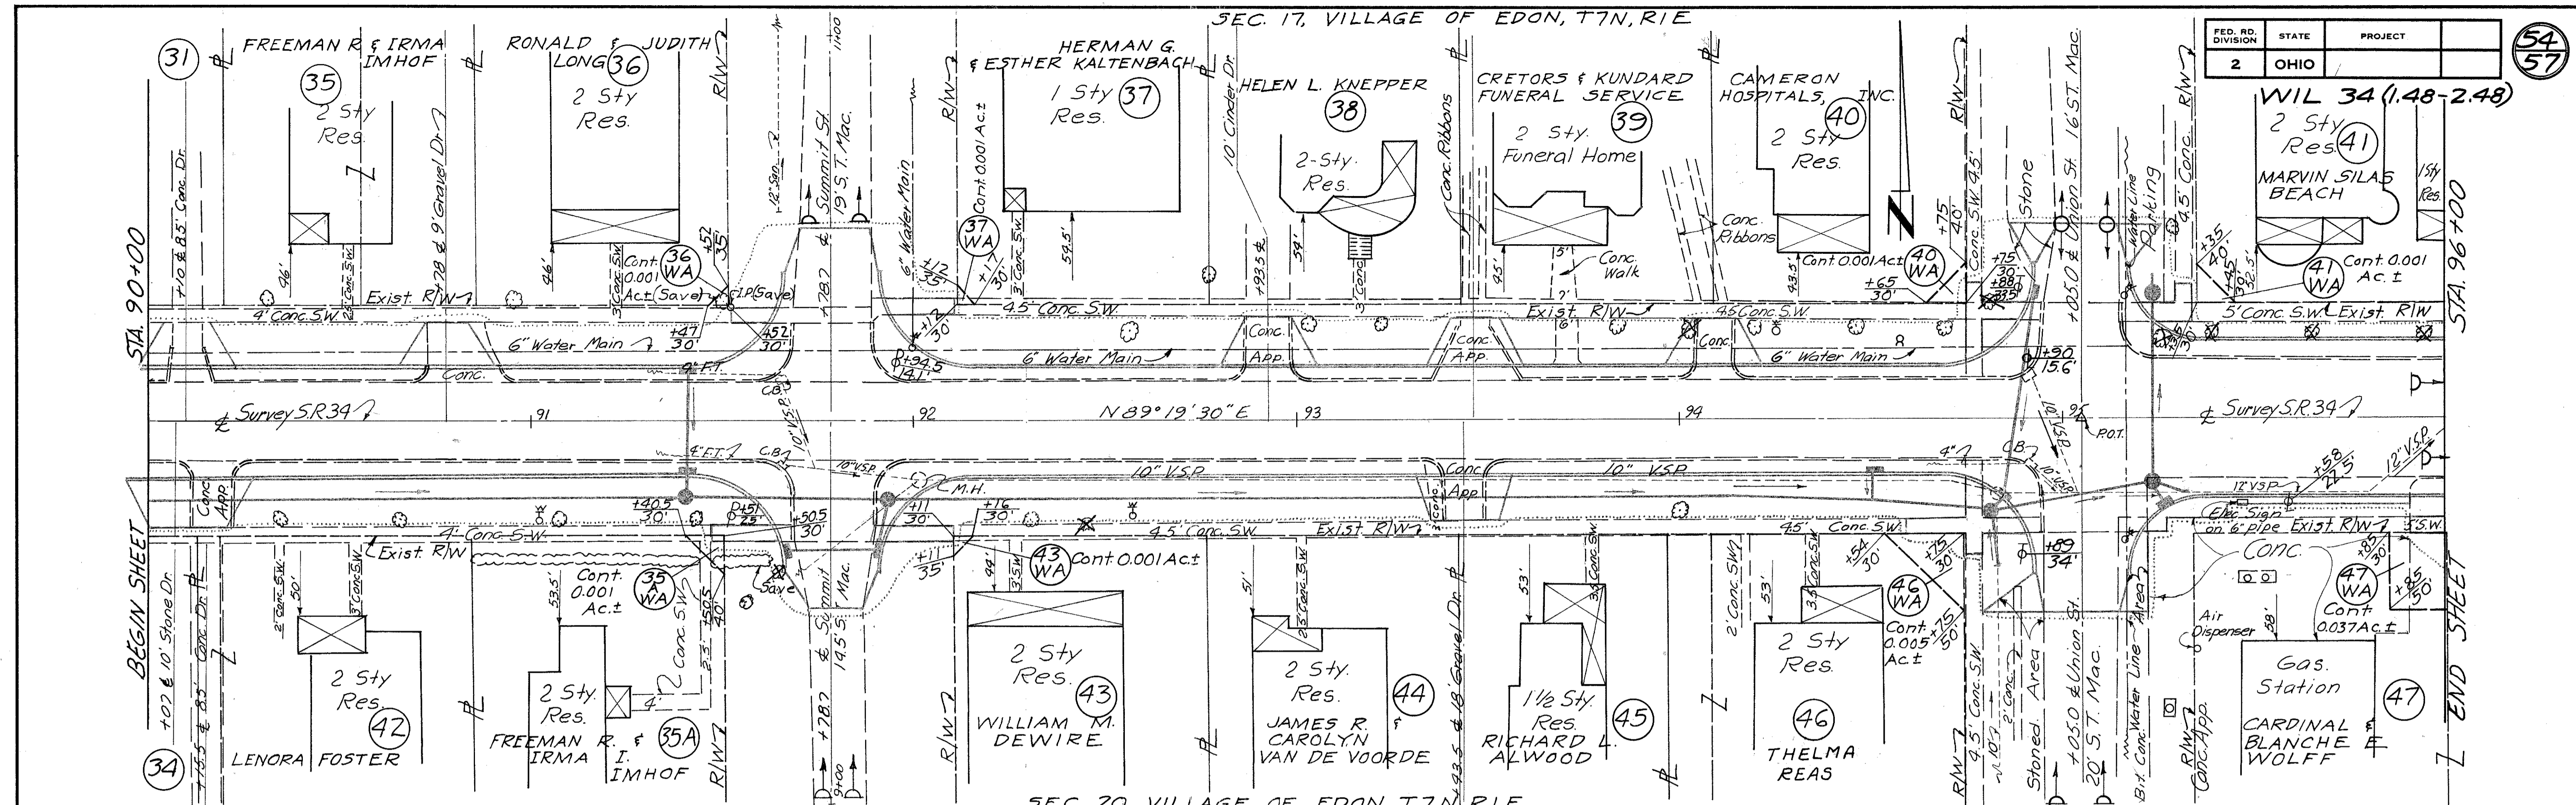


STA. 96+00
STA. 102+00

BEGIN SHEET
END SHEET

NO.	REVISION	DATE BY
1	Plan revised	7-10-60 R.C.E.

1947

FED. RD. DIVISION	STATE	PROJECT	55 57
2	OHIO		

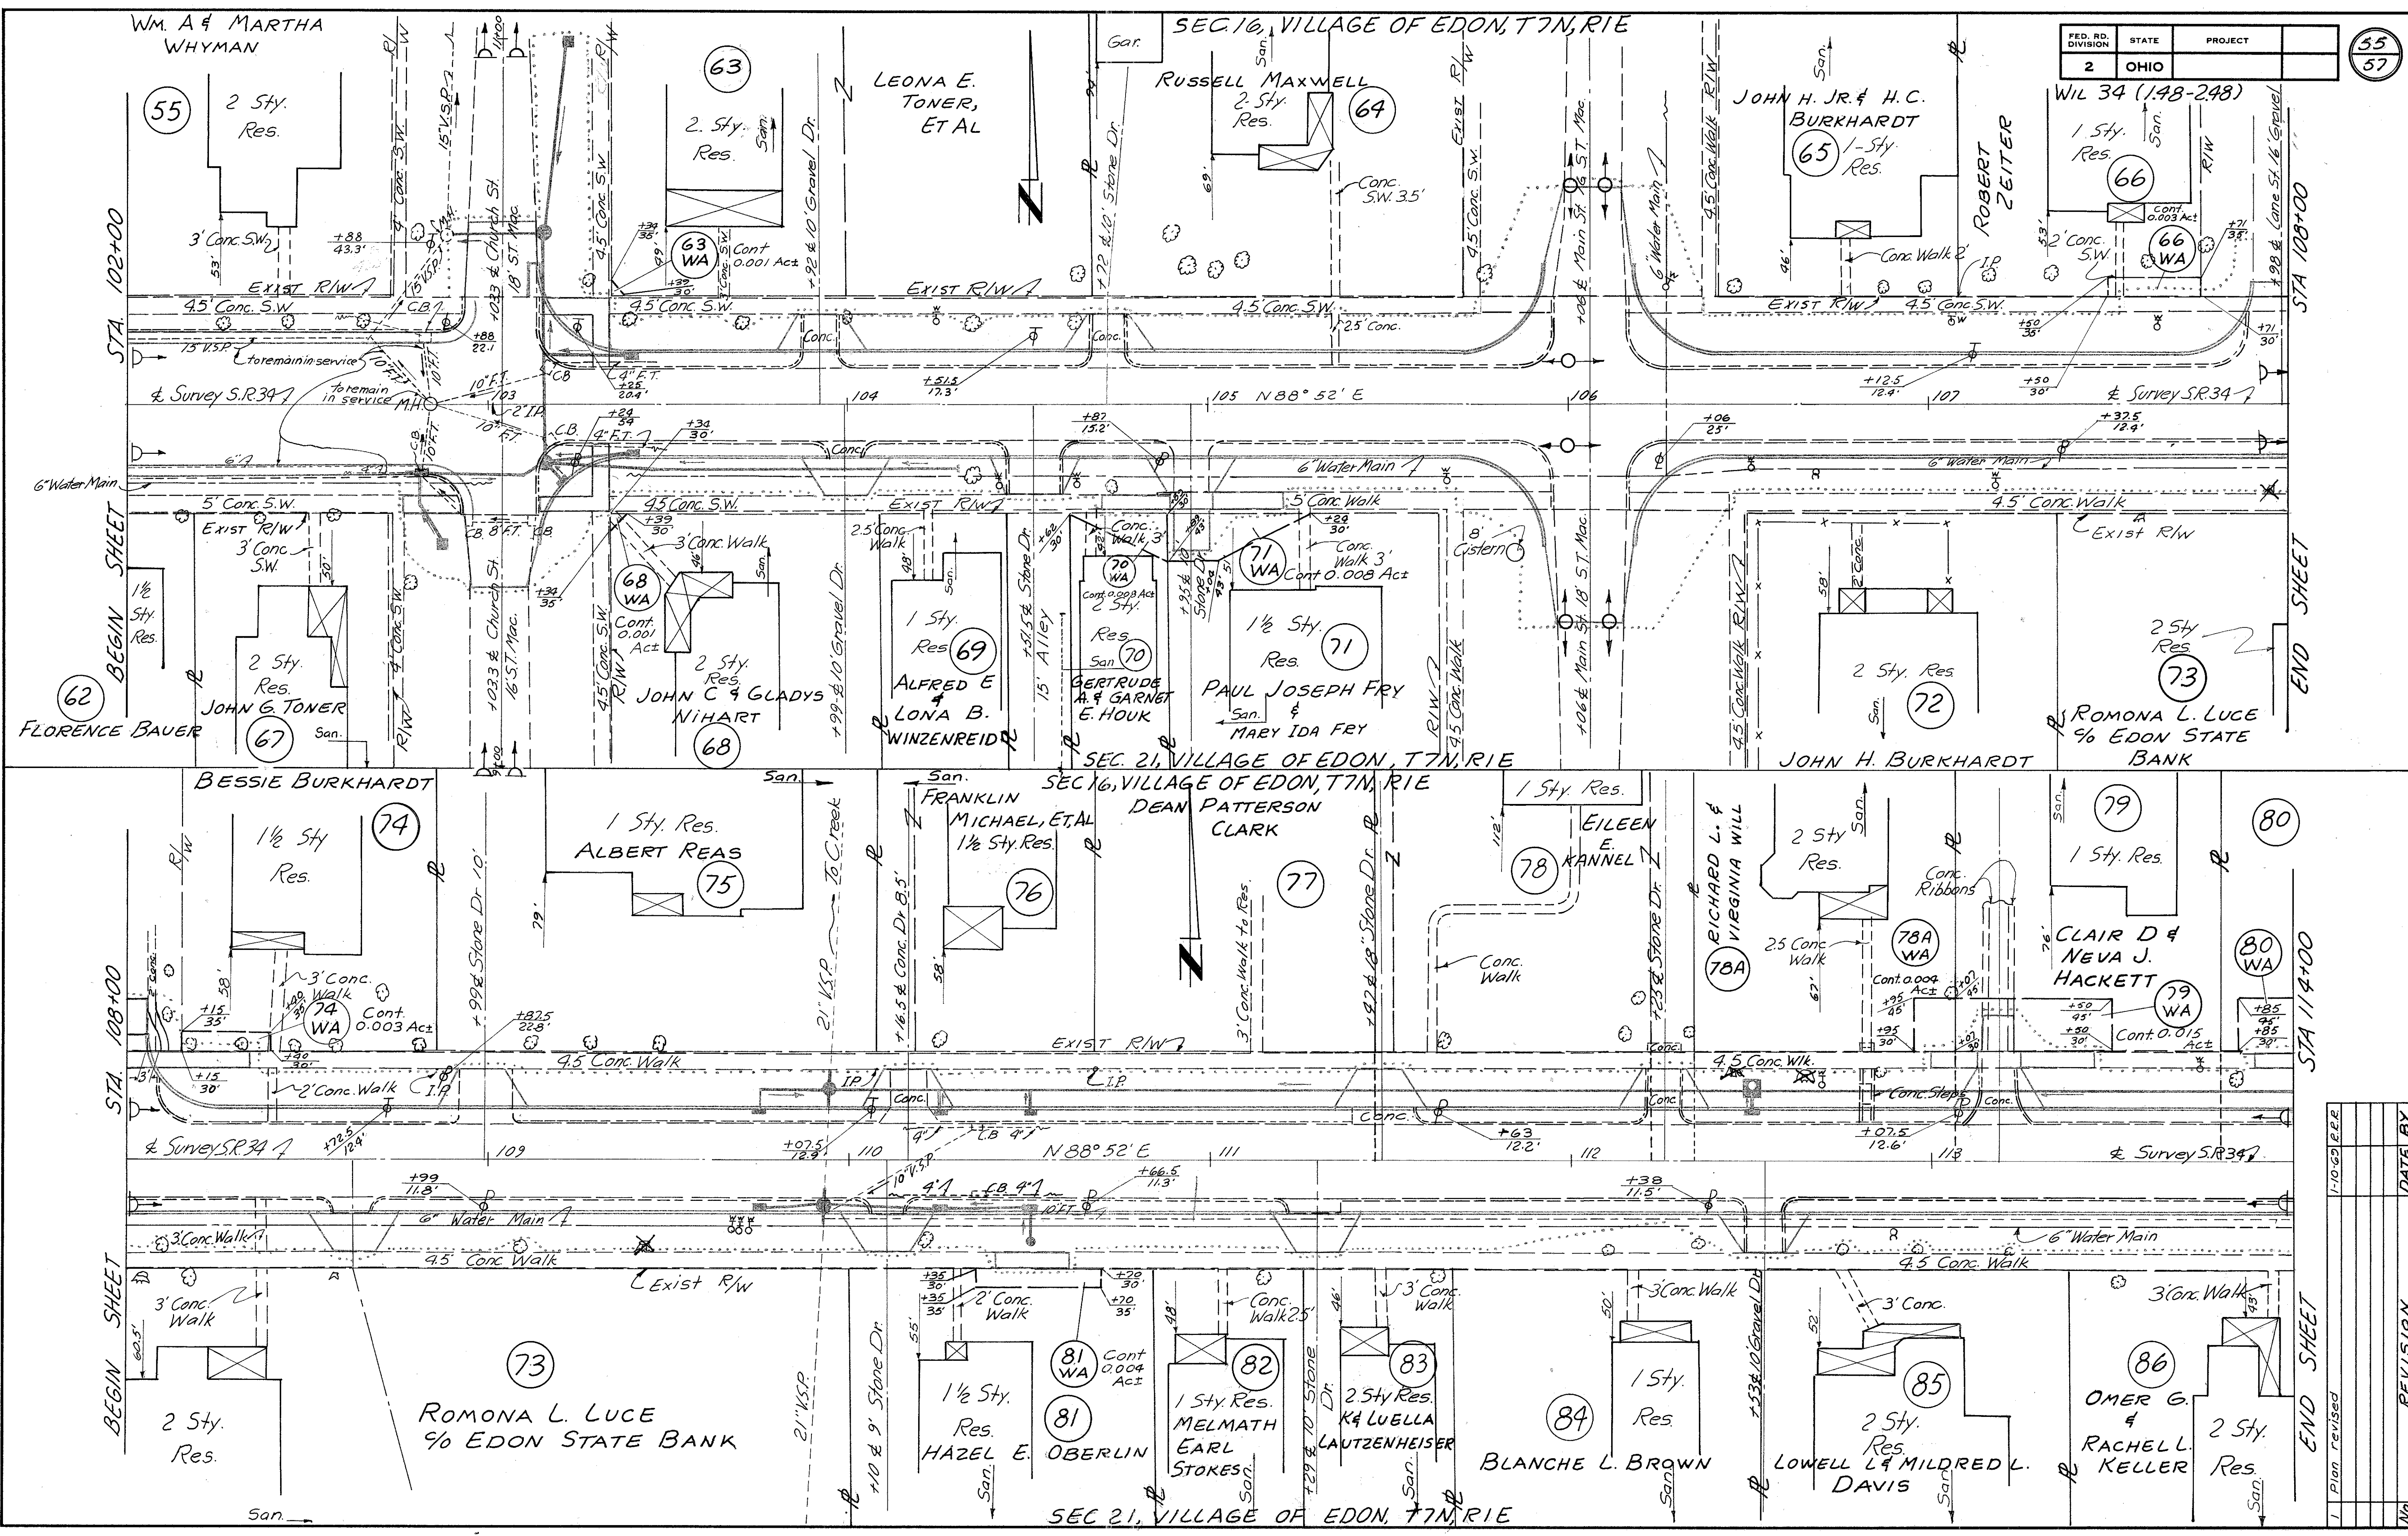

1-10-50	REVISION	DATE BY

STA 102+00

BEGIN SHEET

STA 108+00

BEGIN SHEET

STA 108+00

END SHEET


STA 114+00

END SHEET


LEROY F & MARILYN DEE HELD

SEC. 16, VILLAGE OF EDON, T7N, R1E

FED. RD. DIVISION	STATE	PROJECT	56 57
2	OHIO	Wil 34 (148-248)	

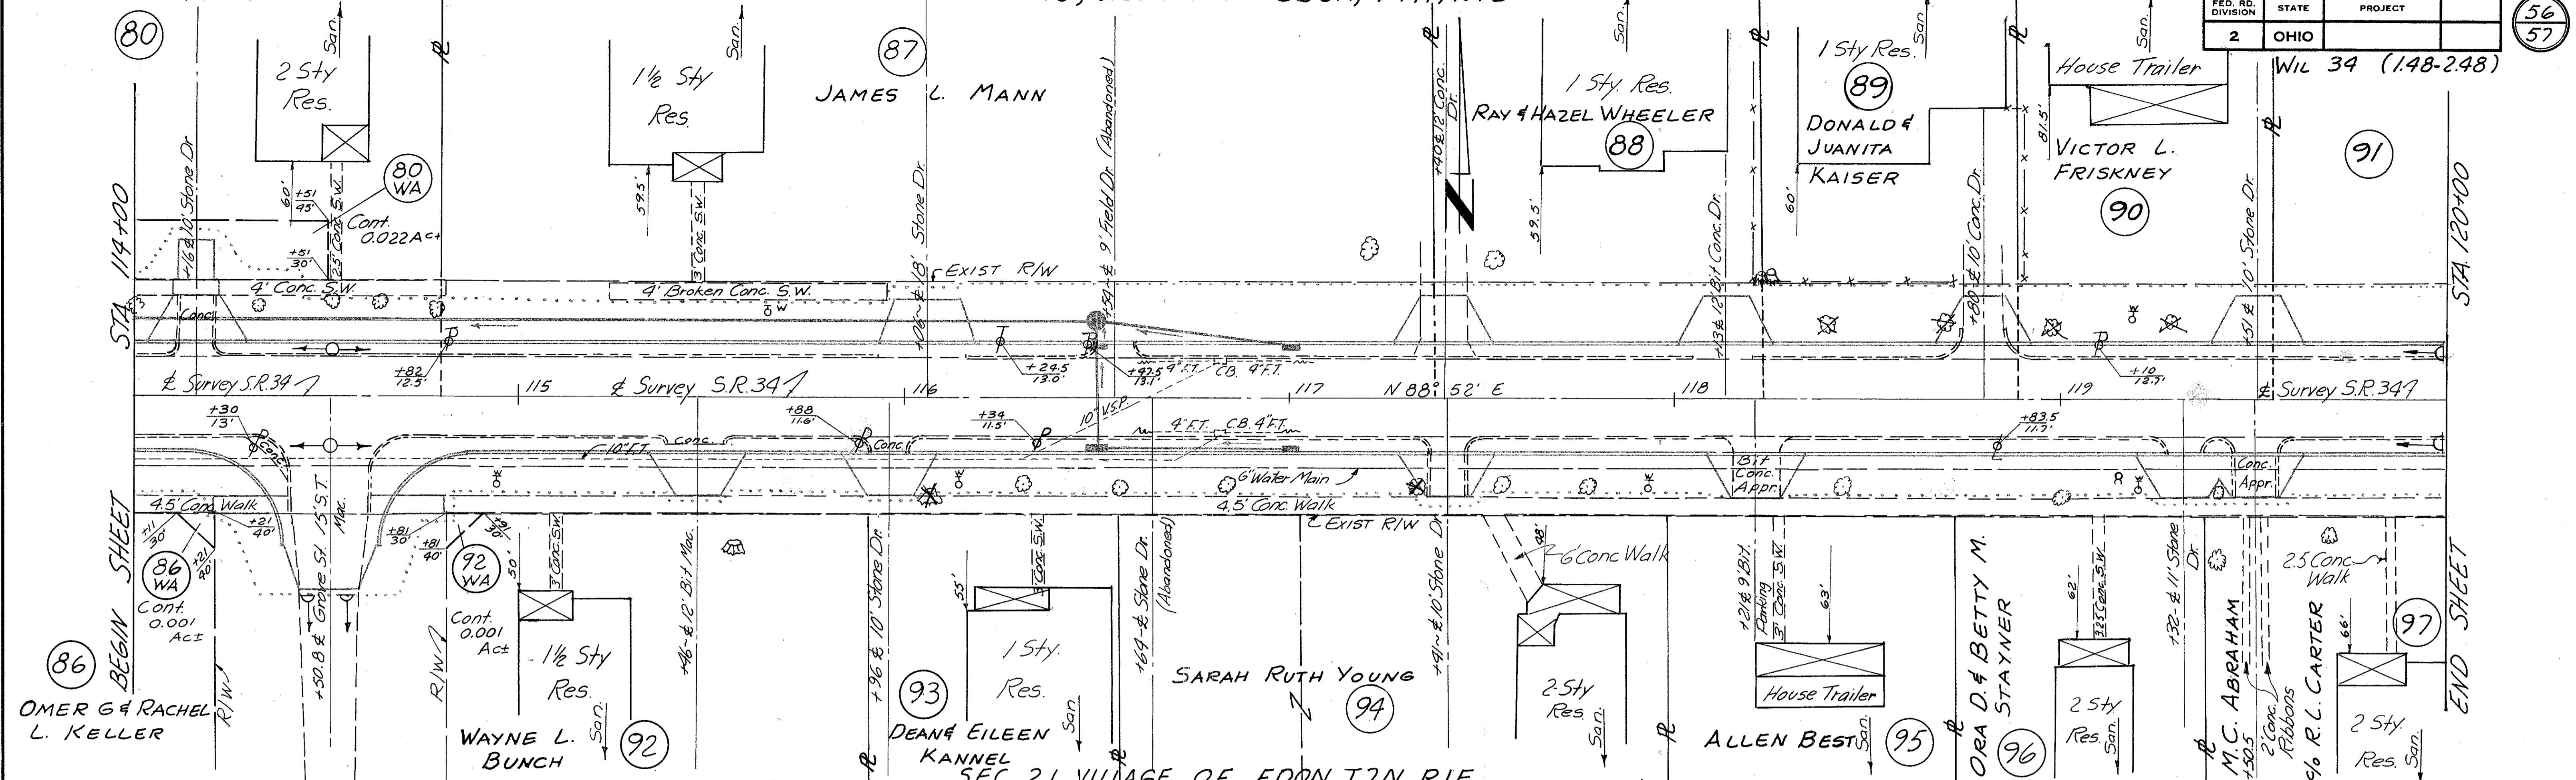

SEC. 21, VILLAGE OF EDON, T7N, R1E
SEC. 16, VILLAGE OF EDON, T7N, R1E

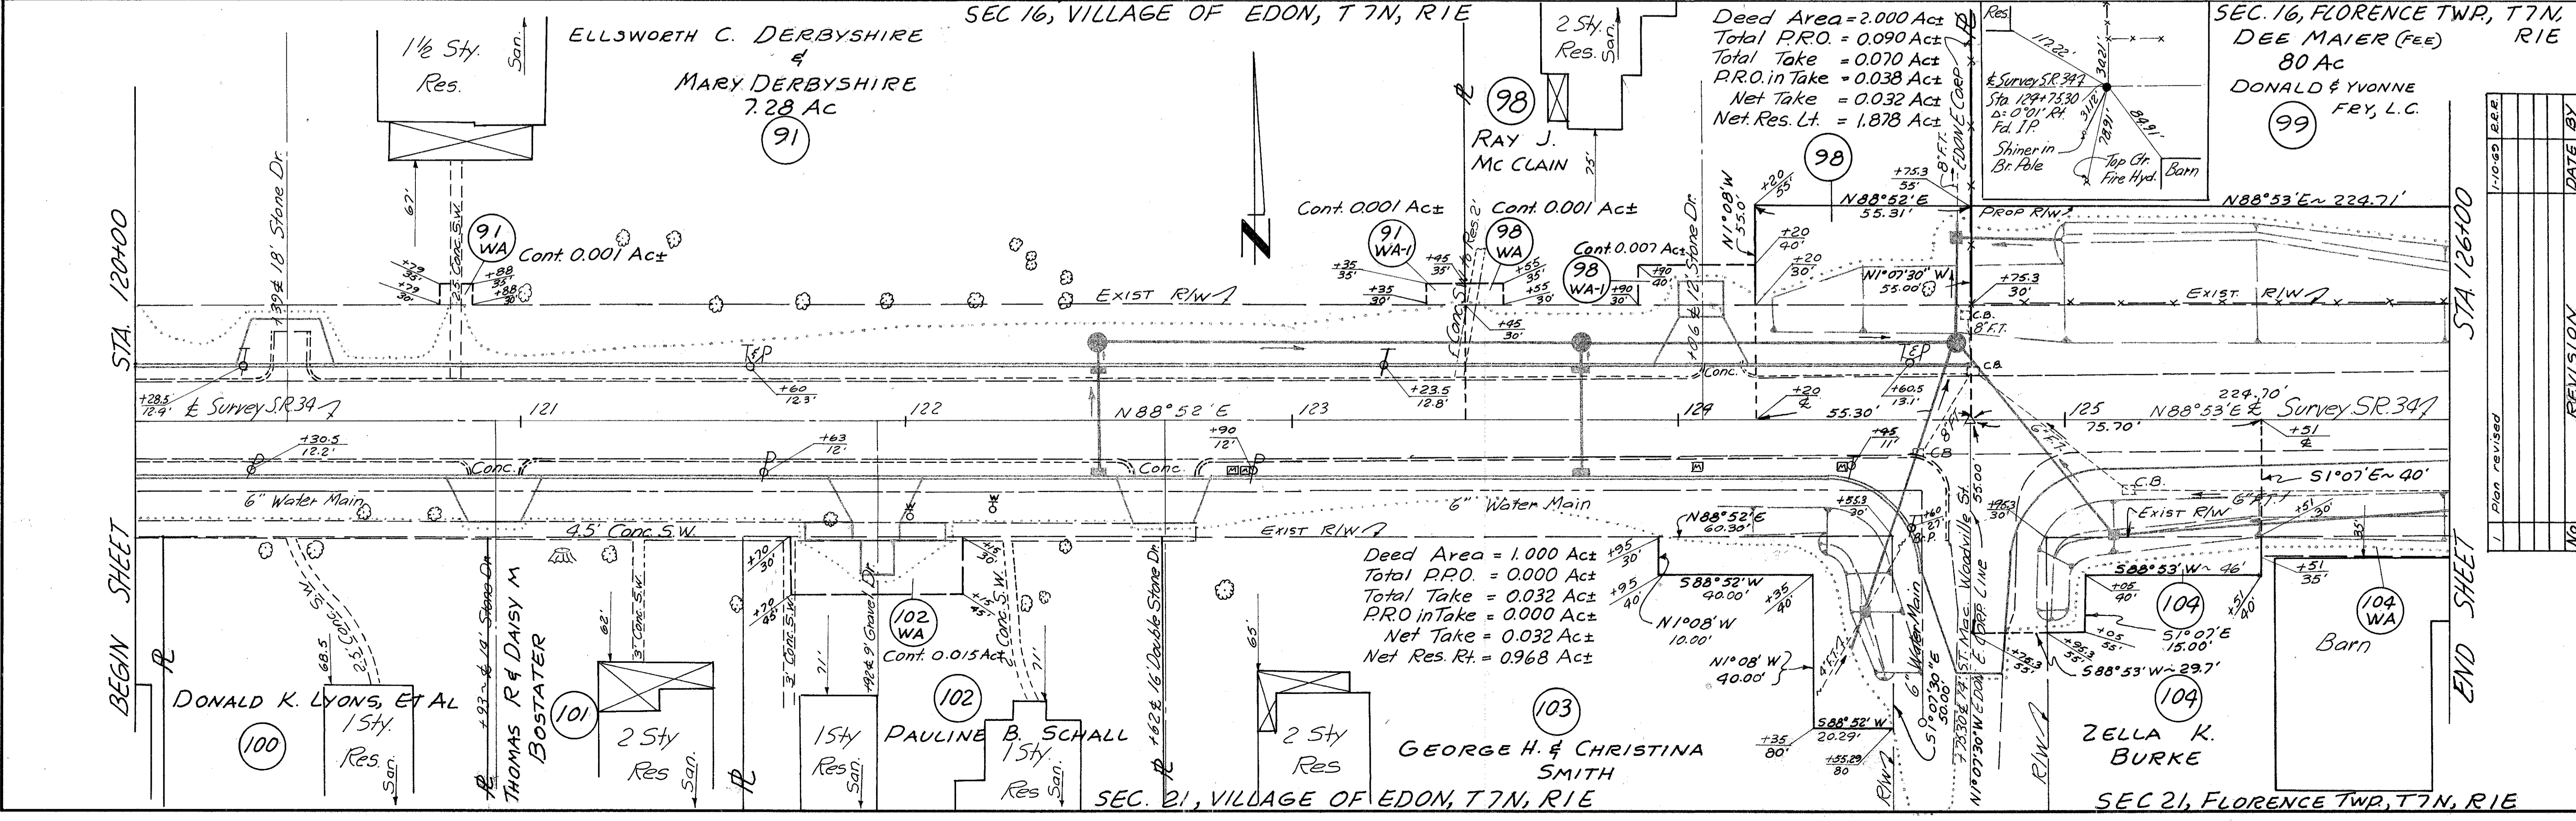

NO	REVISION	DATE BY
1	Plan Revised	1-10-69 R.R.E.

Deed Area = 80.000 Ac±
 Total P.R.O. = 0.909 Ac±
 Total Take = 0.284 Ac±
 P.R.O. in Take = 0.155 Ac±
 Net Take = 0.129 Ac±
 Net Res. Lt = 78.962 Ac±

SEC. 16, FLORENCE TWP, T7N, R1E

(99)

DEE MAIER (FEE), DONALD & YVONNE FRY, L.C.
 80 AC



FED. RD. DIVISION	STATE	PROJECT
2	OHIO	

57
57

W/L 34-(148-248)

BEGIN SHEET
 STA. 126+00

END SHEET
 STA. 132+00

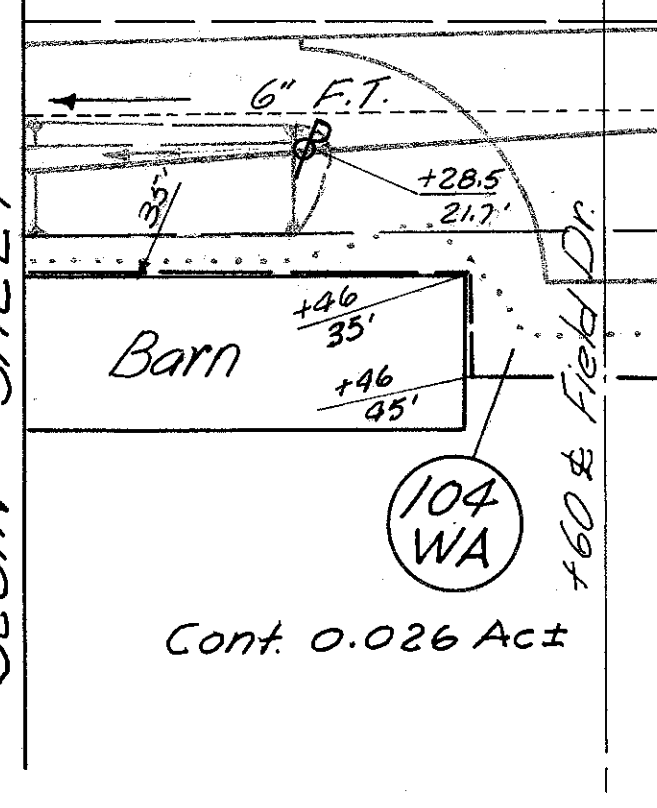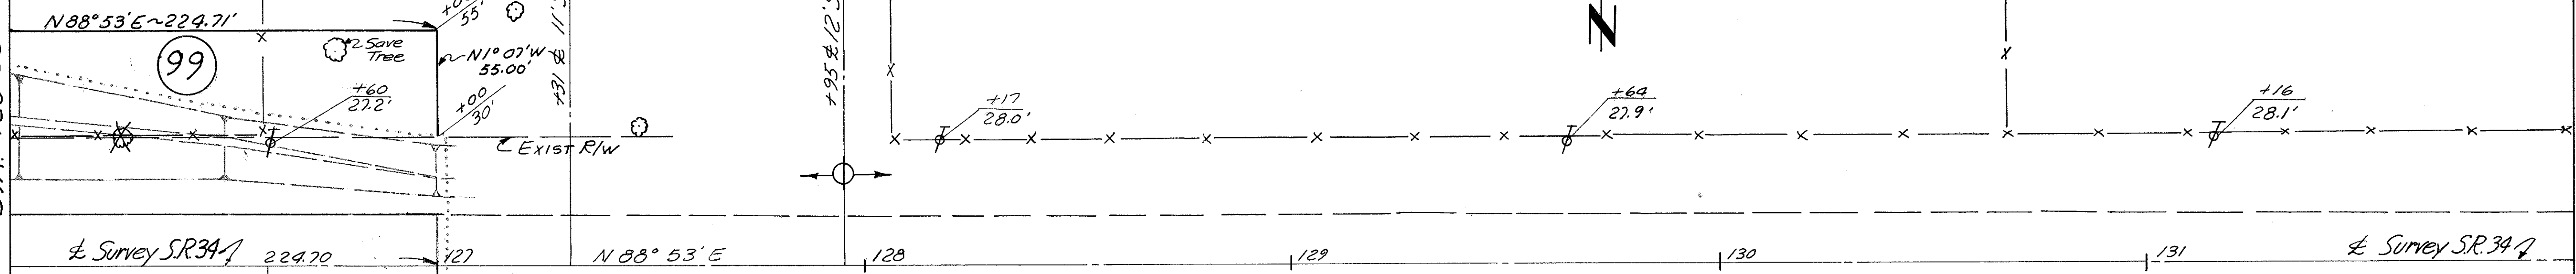

Deed Area = 87.200 Ac±
 Total P.R.O. = 0.909 Ac±
 Total Take = 0.080 Ac±
 P.R.O. in Take = 0.064 Ac±
 Net Take = 0.016 Ac±
 Net. Res. Rt = 86.275 Ac±

(104)

ZELLA K. BURKE

SEC. 21, FLORENCE TWP, T7N, R1E

No	REVISION	DATE BY
1	Plan revised	1-10-62 P.R.P.

Handwritten signature/initials.