
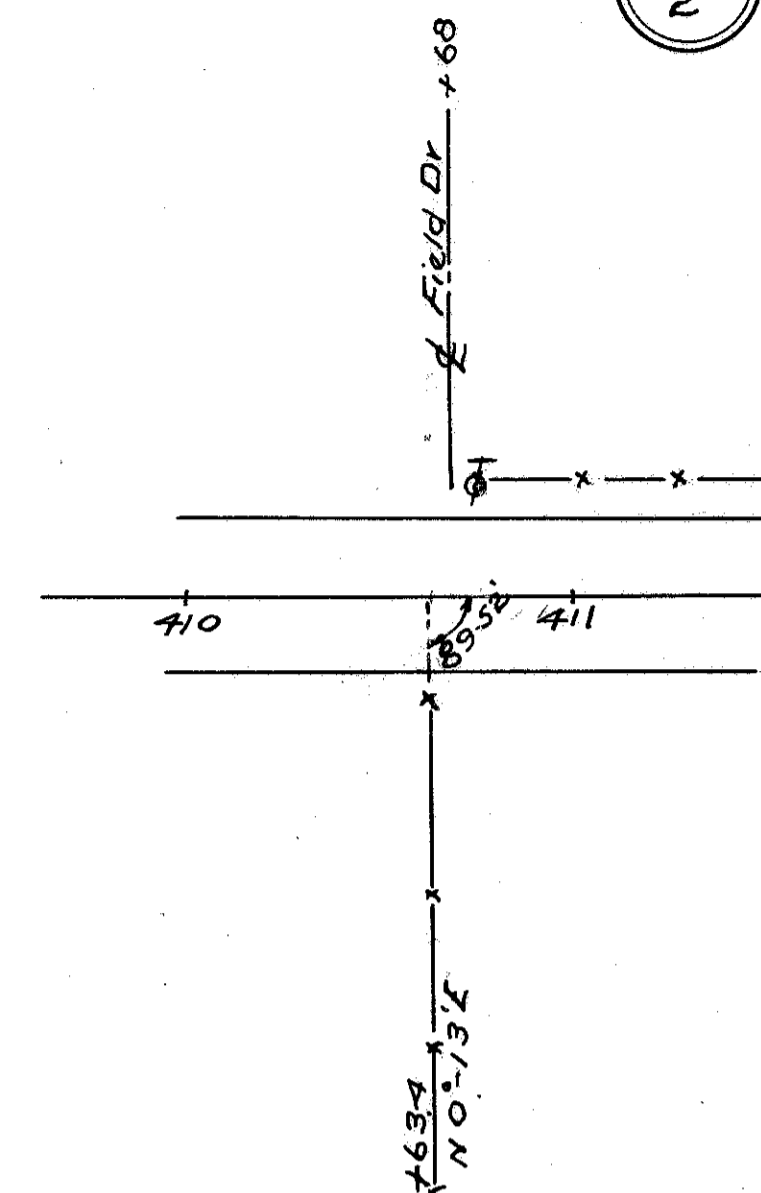


FED. RD. DIVISION	STATE	PROJECT	
2	OHIO		

28
29

WIL-34-7.83


1
2

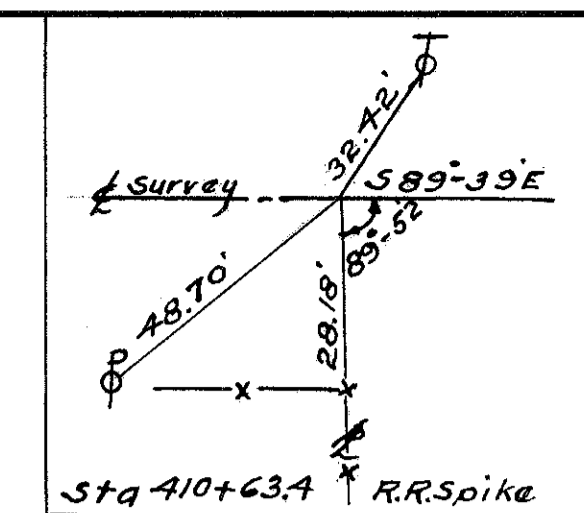

SEC 36 FLORENCE TWP T7N,R1E

OSCAR L. & ESTOLENE STRAUSBORGER

CYRIL SIEBENALER
CLARA SIEBENALER L.E.

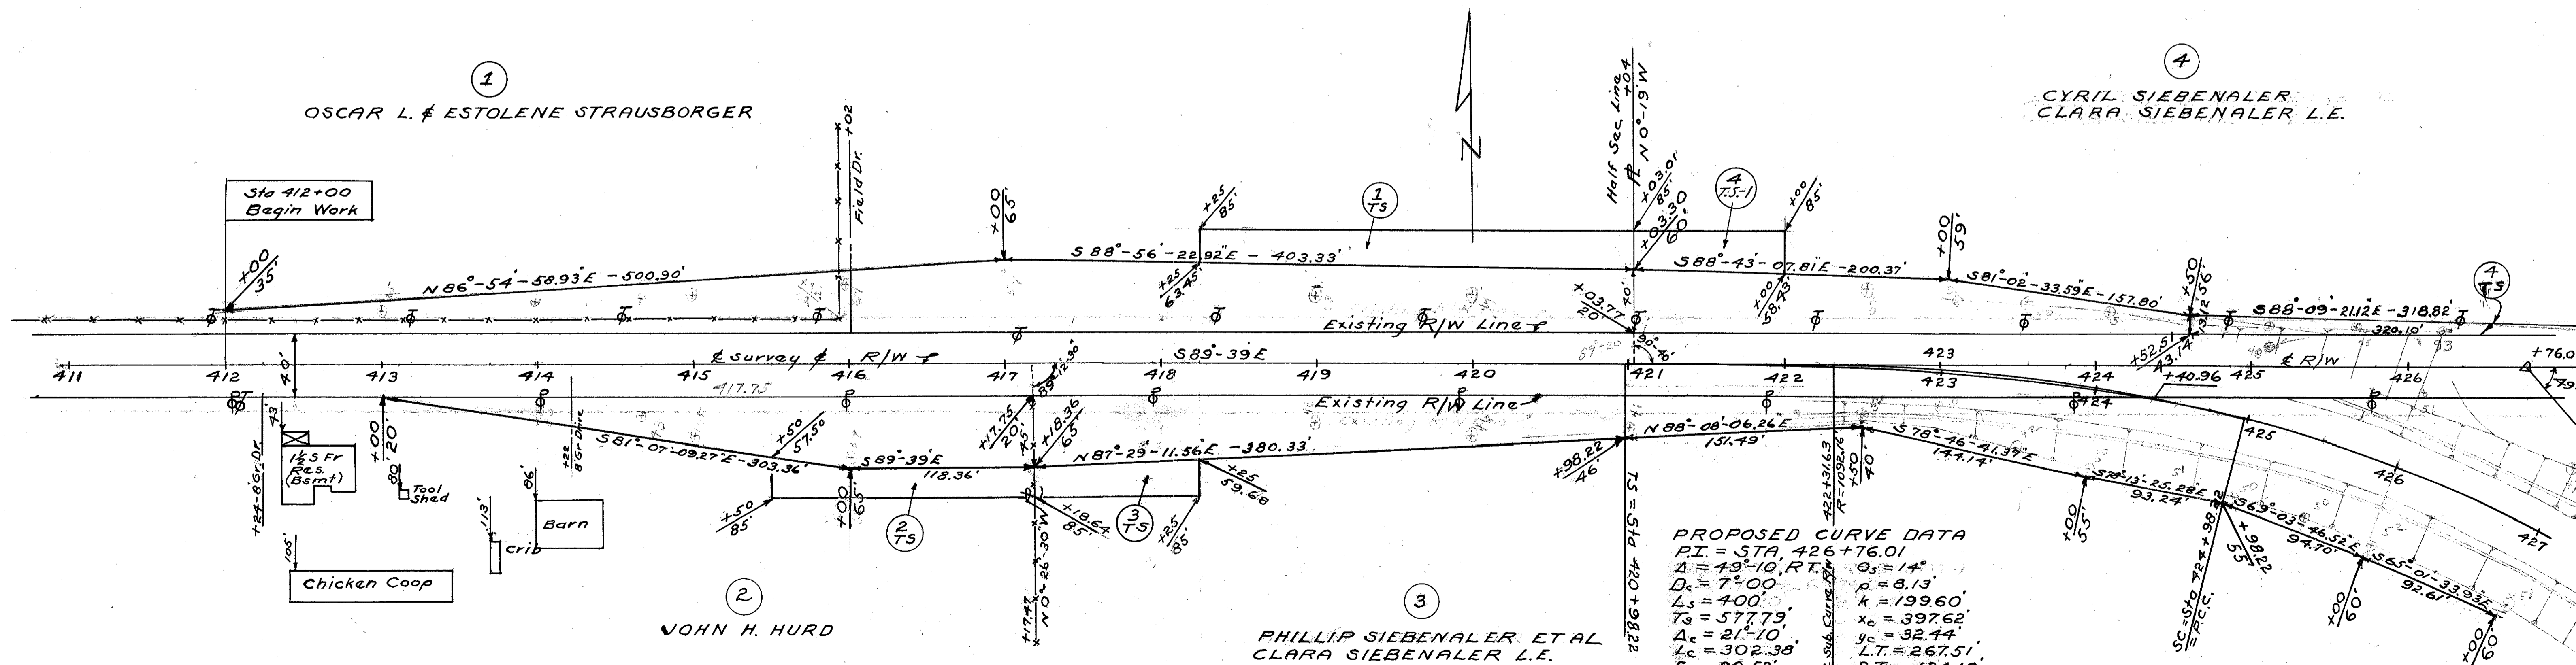

PROPOSED CURVE DATA
 P.I. = STA. 426+76.01
 $\Delta = 43^{\circ}-10'$ R.T. $\theta_s = 14^{\circ}$
 $D_c = 7^{\circ}-00'$ $p = 8.13$
 $L_s = 400'$ $k = 199.60$
 $T_s = 577.73$ $x_c = 397.62$
 $\Delta_c = 21^{\circ}-10'$ $y_c = 32.44$
 $L_c = 302.38'$ $L.T. = 267.51'$
 $E_s = 90.52'$ $S.T. = 134.10'$
 $R_c = 818.51'$ $L.C. = 398.94'$
 T.S. = STA 420+98.22
 S.C. = STA 424+98.22
 C.S. = STA 428+00.60
 S.T. = STA 432+00.60

SEC 36 FLORENCE TWP T7N,R1E

10/20/61 Added Par. A-T.S.-1



R7034 3 H-54

FED. RD. DIVISION	STATE	PROJECT
2	OHIO	

WIL-34-7.83

29
29

2
2

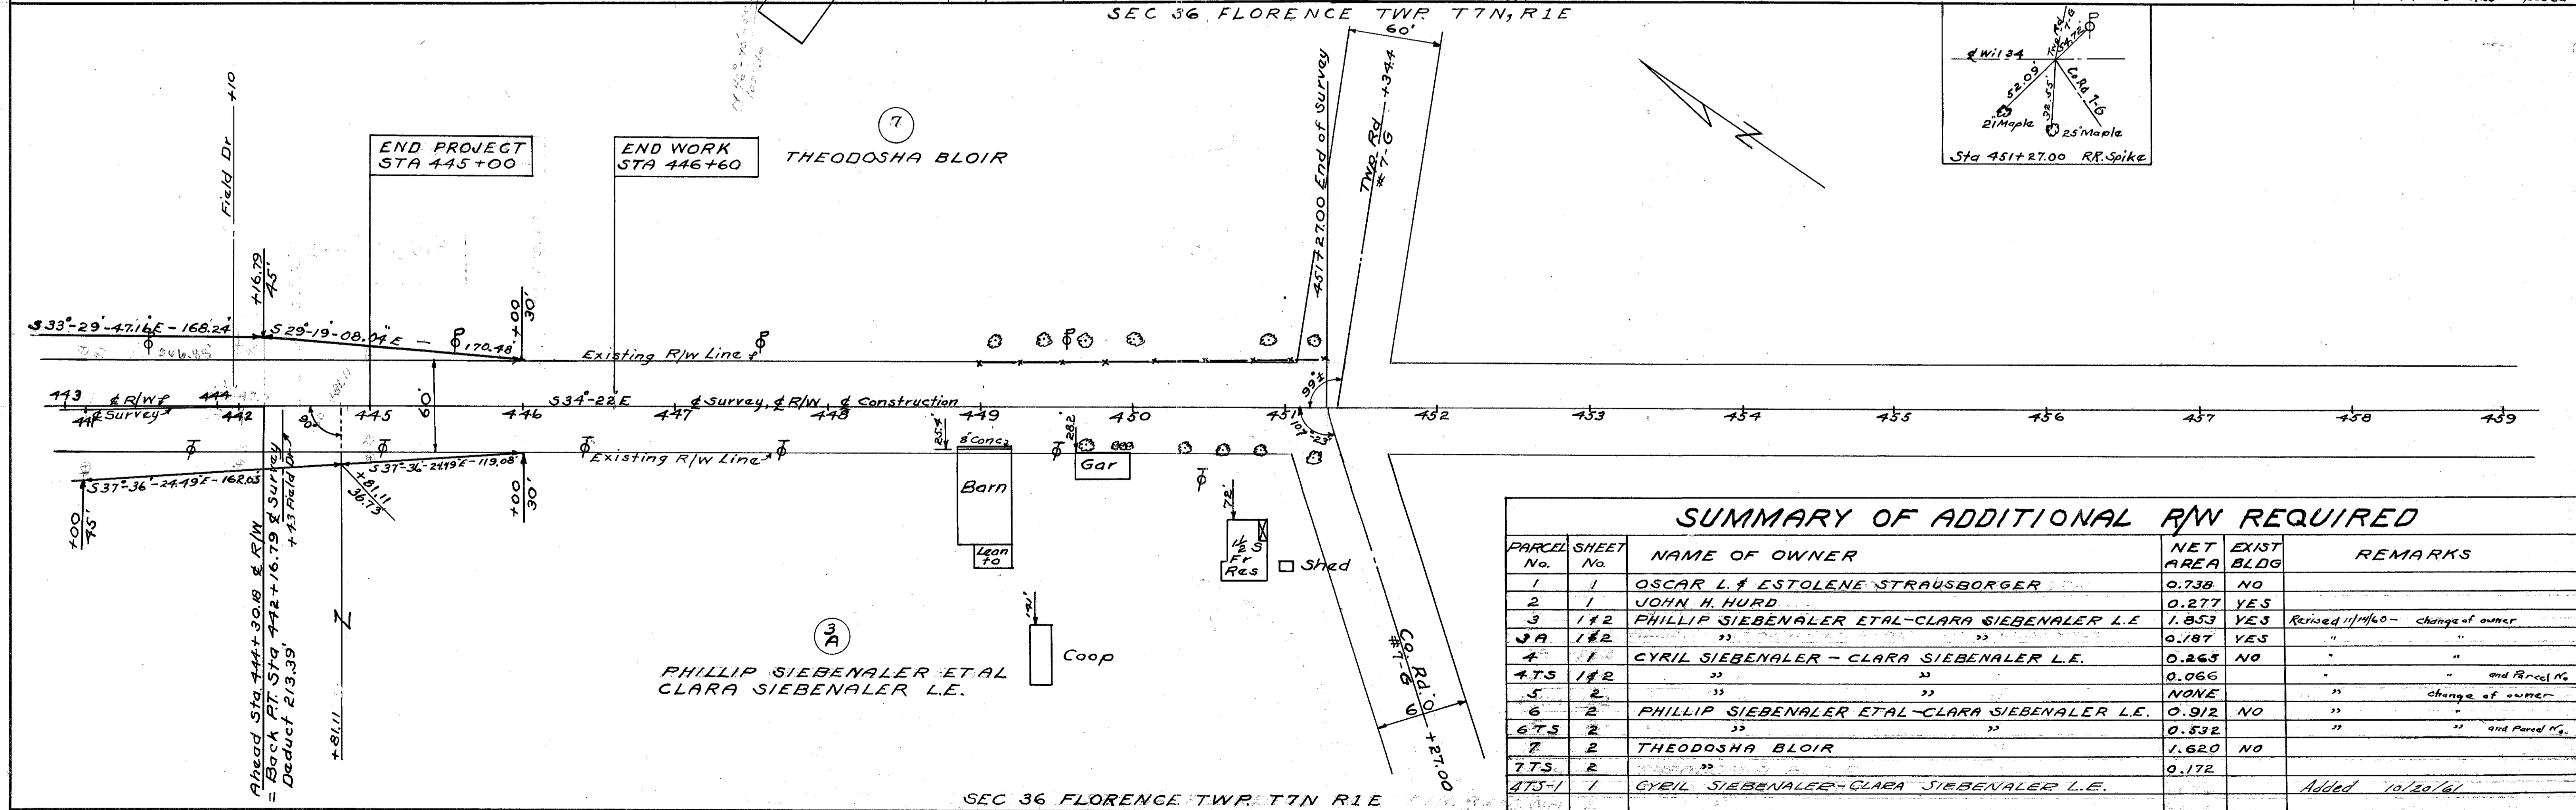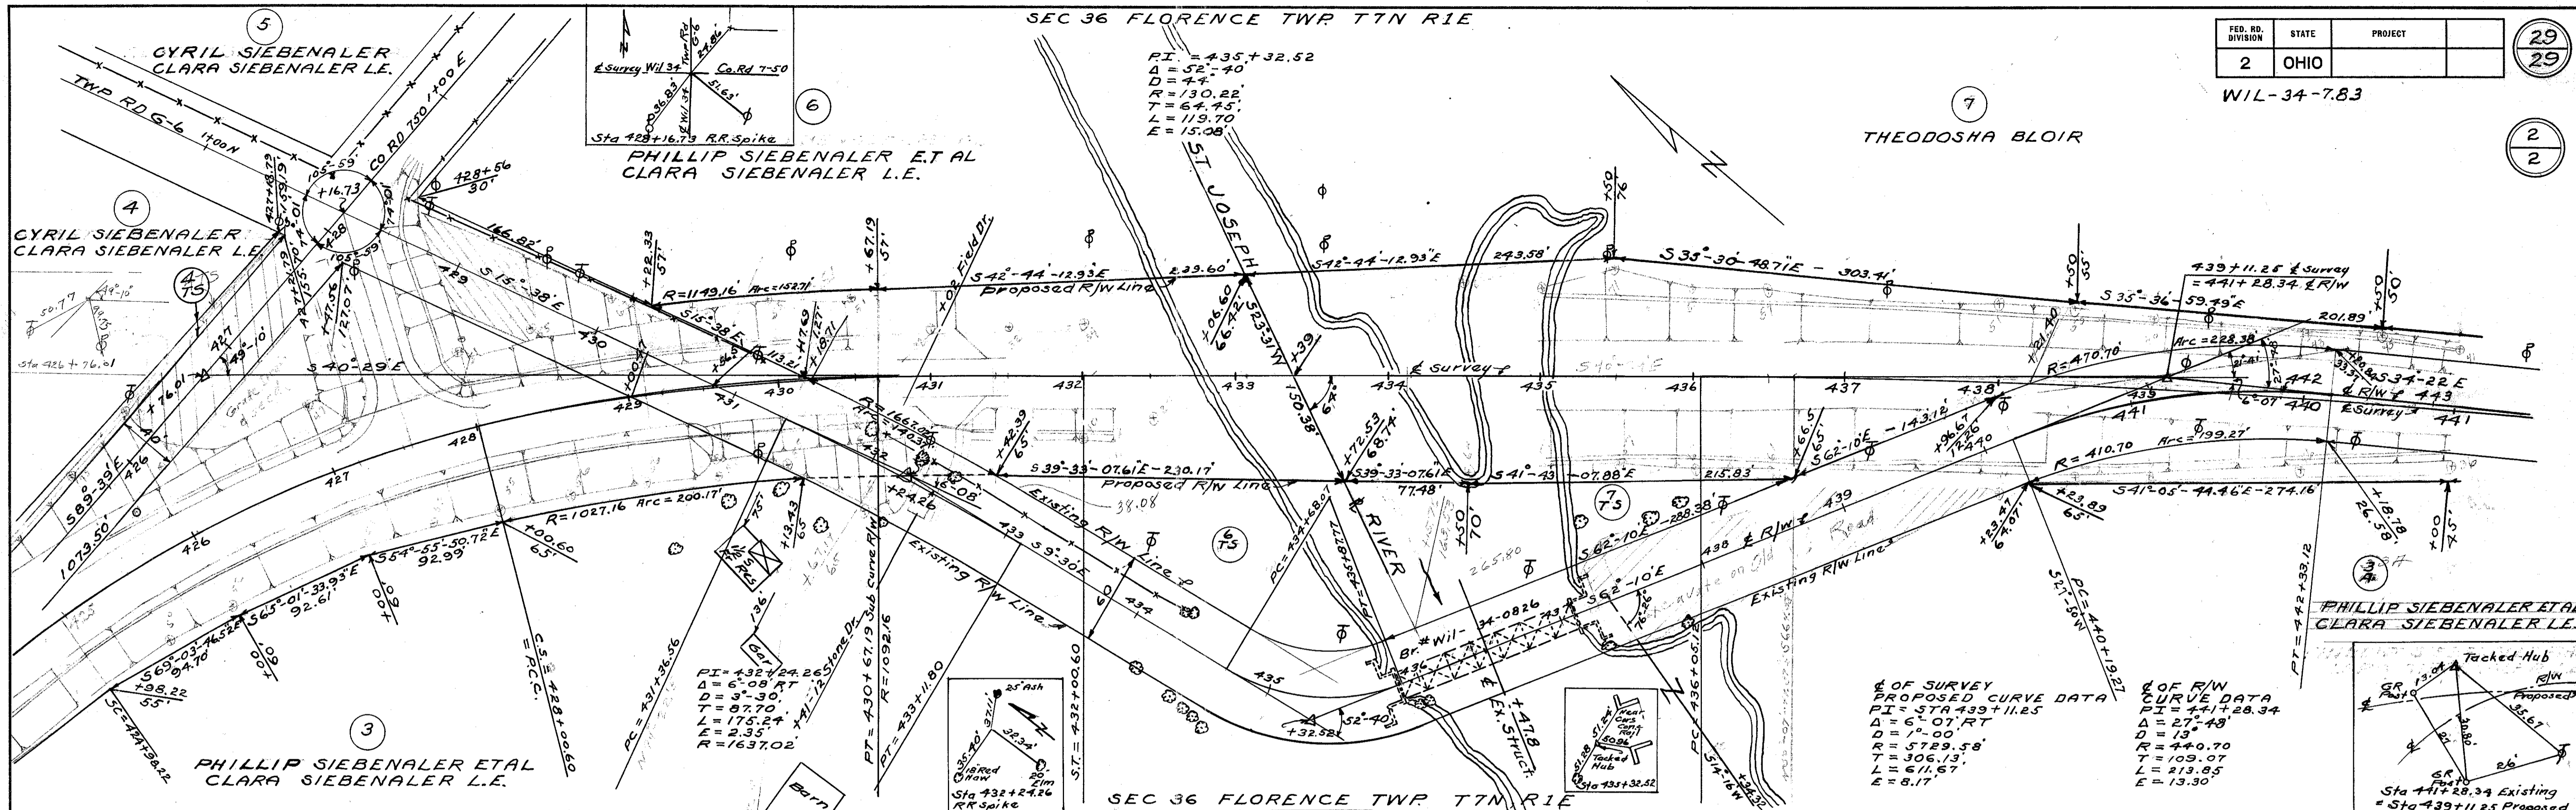

SUMMARY OF ADDITIONAL R/W REQUIRED

PARCEL No.	SHEET No.	NAME OF OWNER	NET AREA	EXIST BLDG	REMARKS
1	1	OSCAR L. & ESTOLENE STRAUSBORGER	0.738	NO	
2	1	JOHN H. HURD	0.277	YES	
3	1 & 2	PHILLIP SIEBENALER ET AL-CLARA SIEBENALER L.E.	1.853	YES	Revised 11/14/60 - change of owner
4	1 & 2	"	0.187	YES	"
4TS	1 & 2	CYRIL SIEBENALER - CLARA SIEBENALER L.E.	0.263	NO	"
5	2	"	0.066	"	" and Parcel No.
6	2	PHILLIP SIEBENALER ET AL-CLARA SIEBENALER L.E.	0.912	NO	"
6TS	2	"	0.532	"	" and Parcel No.
7	2	THEODOSHA BLOIR	1.620	NO	
7TS	2	"	0.172	"	
4TS-1	1	CYRIL SIEBENALER-CLARA SIEBENALER L.E.			Added 10/20/61