


O.D.O.T. DISTRICT 2 SURVEY OFFICE (USE ONLY)


PERSONNEL \_\_\_\_\_ REFERENCE NO. 1 SHEET 1 OF 25  
 NOTES RHOADES DATE 8/7/20 ROUTE SR 34  
 H.C. AUBLE WEATHER SUNNY COUNTY WILLIAMS  
 R.C. MAHLER TEMP. 65° TOWNSHIP FLORENCE  
 DWG BY NIESE PID PAVE TRAIN SECTION 18  
 T 7 N R 1 E

TYPE MONUMENT MAG/WASHER  
 ON SURFACE - ~~BELOW~~ ON  
 OFFSET ☉ PAVEMENT 1.8' ~~LT~~ : RT  
8.9' TO RT EDGE PAVEMENT  
 STATION: 0+00

HORZ. DATUM: NAD83 2011 GEOID: NAVD88 2012A  
 GRID: NORTHING: 696822.597 EASTING: 1337719.338

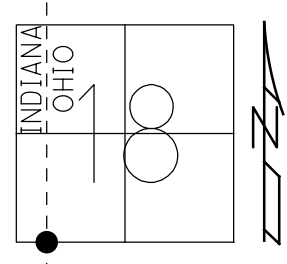

RECORD:  
 FD SM.R.R.SPIKE  
 2" BELOW SURFACE  
 6/18/96, BVD  
 FD SM.R.R.SPIKE  
 0.2' DOWN  
 1/26/11, MC  
 FD SM.R.R.SPIKE  
 5/4/12, SAH  
 SET MAG/WASHER  
 8/2/12, SAH  
 FD MAG/WASHER  
 REF1  
 8/7/20, DSA  
 8/18/21, JFO

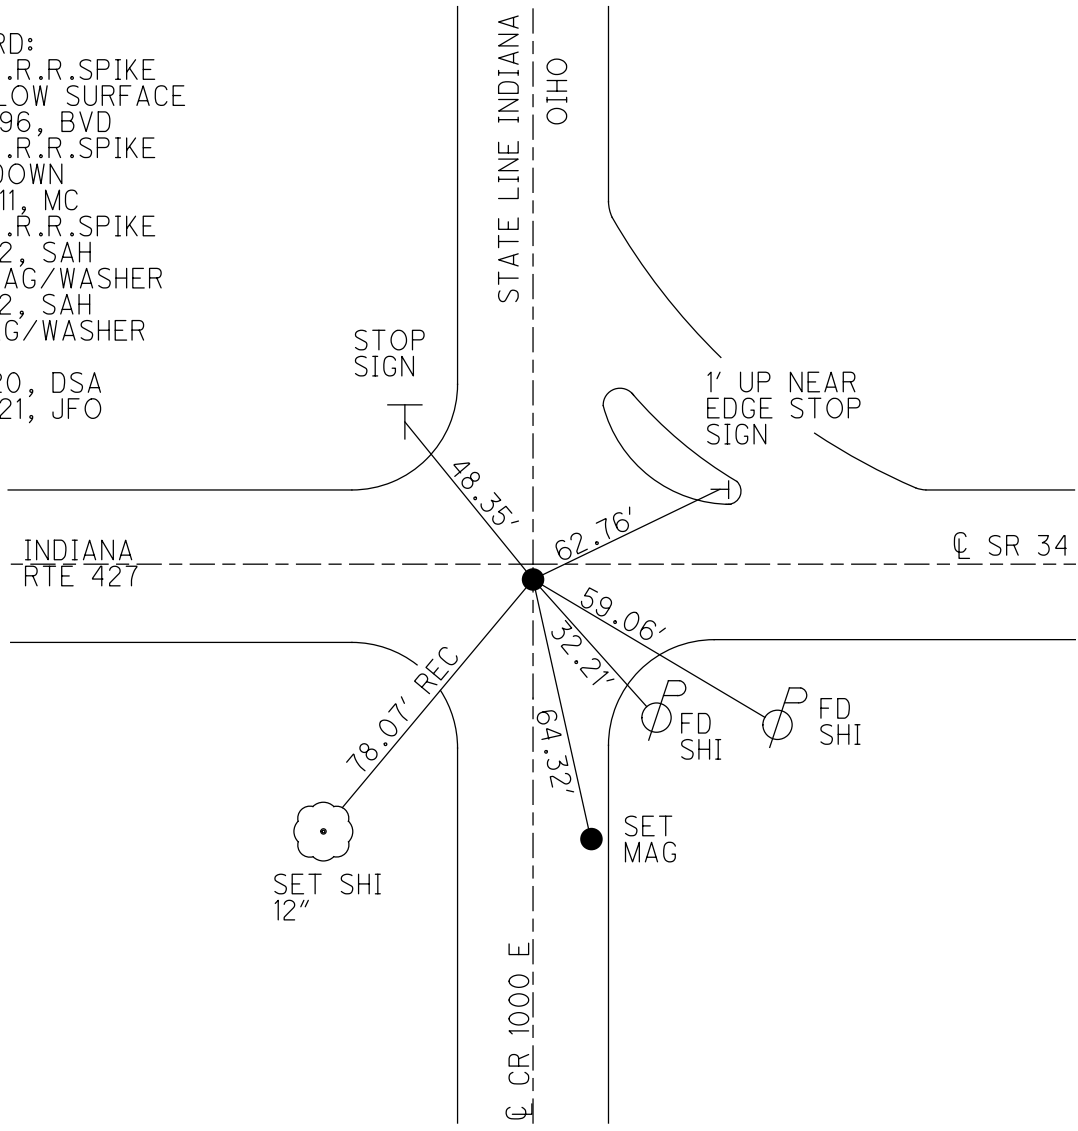

O.D.O.T. DISTRICT 2 SURVEY OFFICE (USE ONLY)

PERSONNEL

REFERENCE NO. 1

SHEET 1 OF 25

NOTES HUSS

DATE 5/4/12

ROUTE SR 34

H.C. CANTERBURY

WEATHER FAIR

COUNTY WILLIAMS

R.C. HARBAUGH

TEMP. 75°

TOWNSHIP FLORENCE

SECTION 18

T 7 N R 1 E


TYPE MONUMENT SM.R.R.SPIKE

~~ON SURFACE~~ - BELOW 0.2'

~~LEFT~~ - CL PAV'T - RIGHT 1.8'

8.9' TO RT EDGE PAVEMENT

S.L.M. 0+00

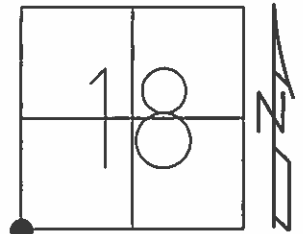

Grid: Northing: 696822.692 Easting: 1337719.294

FD SM.R.R.SPIKE  
2" BELOW SURFACE  
6/18/96, BVD

FD SM.R.R.SPIKE  
0.2' DOWN  
1/26/11, MC  
GPS, REF1  
1/27/11, MC

SET MAG/WASHER  
8/2/12, SAH

