

O.D.O.T. DISTRICT 2 SURVEY OFFICE (USE ONLY)

PERSONNEL

REFERENCE NO. 1AA

SHEET 2 OF 26

NOTES NIESE DATE 7/14/25
 H.C. MILLER WEATHER SUNNY

ROUTE SR-34
 COUNTY WILLIAMS

R.C. BARRIERE TEMP. 72°

TOWNSHIP FLORENCE
 SECTION 18

PRESTON-COLVIN, FRUCHEY, ERNST
 DWG BY NIESE PID 101288

T 7 N R 1 E

TYPE MONUMENT MONBOX W/ 1" IPIN

ON SURFACE - BELLOW ON

OFFSET OF PAVEMENT ON LT : RT


TO EDGE PAVEMENT

STATION: 0+00

HORZ.DATUM: NAD83(2011) GEOID: 18

GRID: NORTHING: 696824.139 EASTING: 1337719.367

OCCS: NORTHING: 348739.054 EASTING: 94253.102

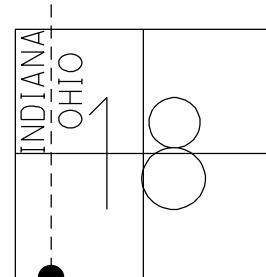

RECORD:

FND MONBOX

W/ 1" IPIN

REF1AA

10/21/24, TDN


FND MONBOX

W/ 1" IPIN,

CHECKED FND STRADDLERS,

DID NOT CROSS OVER PIN

7/14/25, TDN

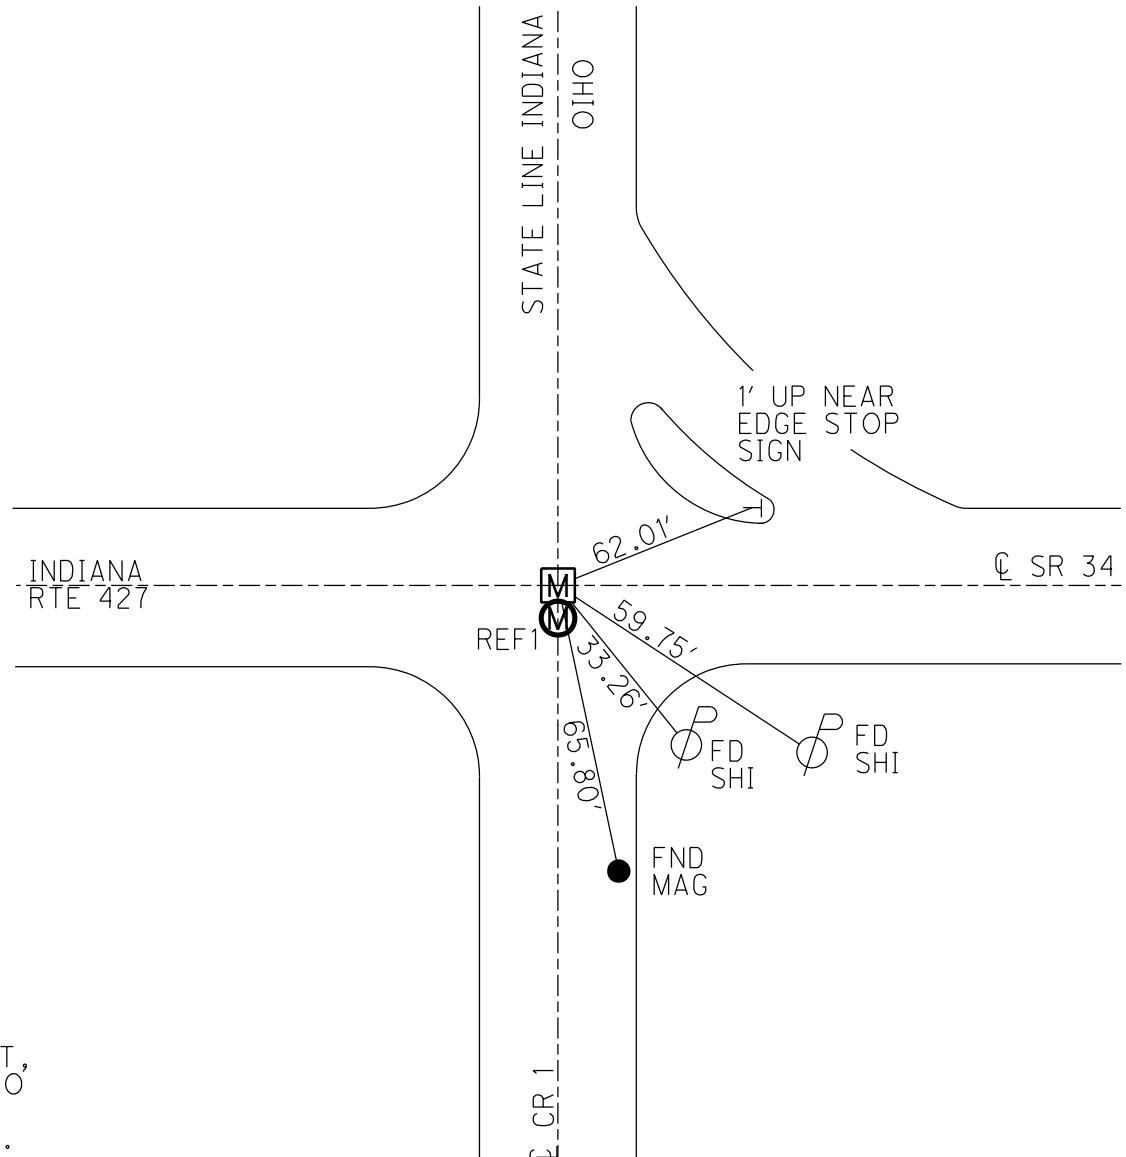

NOTE:

AFTER SPEAKING WITH INDOT,
 MONBOX WAS DETERMINED TO
 BE A P.O.T. OF INDIANA
 SR-427 ON THE STATE LINE.