

O.D.O.T. DISTRICT 2 SURVEY OFFICE (USE ONLY)

PERSONNEL

REFERENCE NO. 2

SHEET 4 OF 25

NOTES RHOADES

DATE 8/7/20

ROUTE SR 34

H.C. AUBLE

WEATHER SUNNY

COUNTY WILLIAMS

R.C. MAHLER

TEMP. 65°

TOWNSHIP FLORENCE

SECTION 18

DWG BY NIESE PID PAVE TRAIN

T 7 N R 1 E

TYPE MONUMENT MAG/WASHER

ON SURFACE - ~~BELOW~~ ON

OFFSET \bar{C} PAVEMENT 1.5' \bar{L} : RT

9.8' TO RT EDGE PAVEMENT


STATION: 45+56.40

HORZ.DATUM: NAD83 2011


GEOID: NAVD88 2012A

GRID: NORTHING: 696676.162

EASTING: 1342273.419

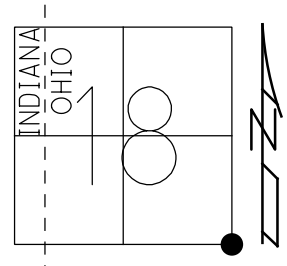


RECORD:
 SET P.K.NAIL
 6/18/96, SAH
 FD SM.R.R.SPIKE
 1/26/11, MC
 FD R.R.SPIKE
 5/4/12, SAH
 SET MAG/WASHER
 8/24/12, SAH
 FD MAG/WASHER
 REF3
 8/7/20, DSA
 8/18/21, JFO

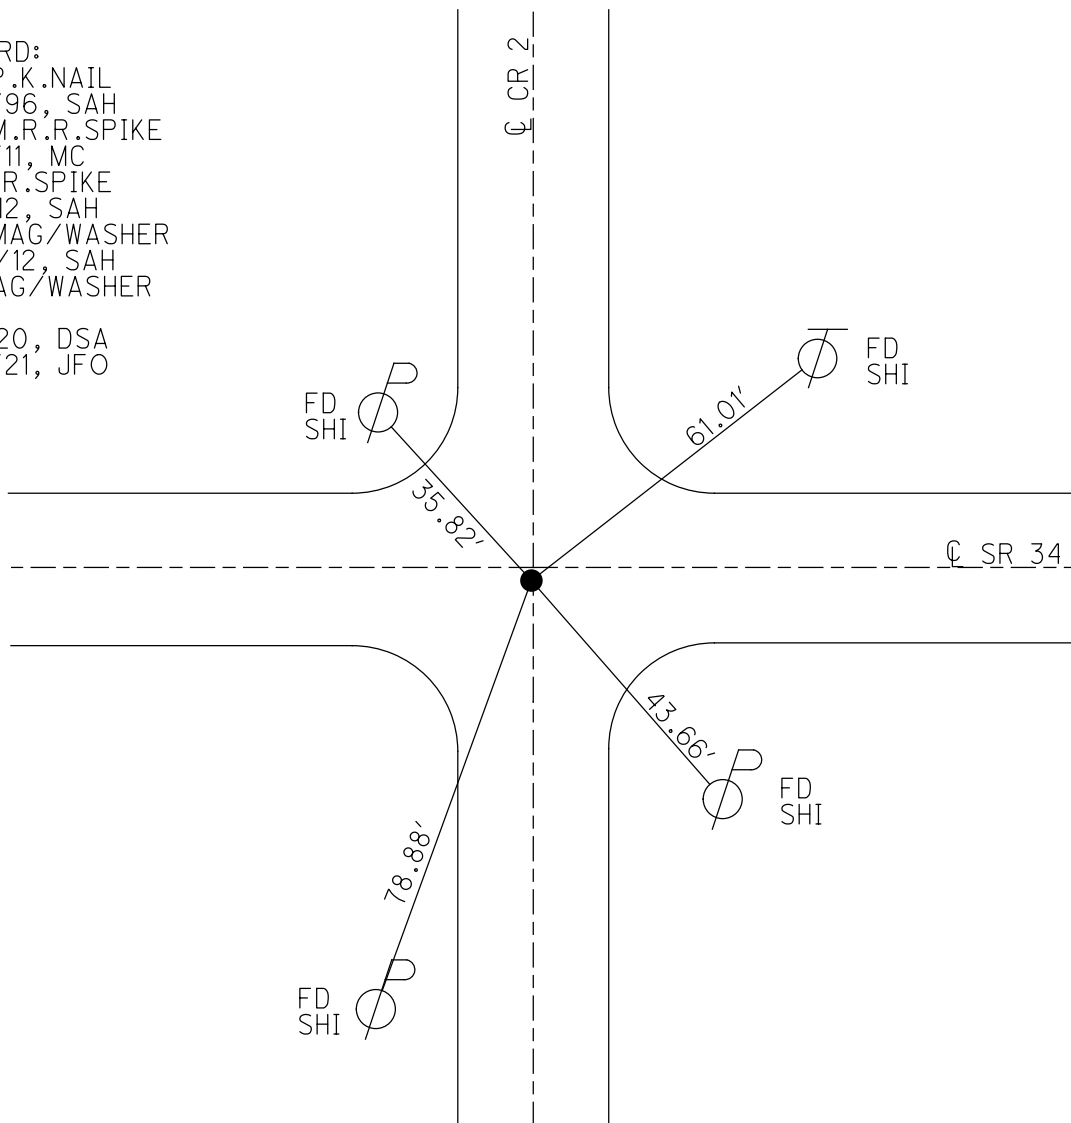

O.D.O.T. DISTRICT 2 SURVEY OFFICE (USE ONLY)

PERSONNEL	REFERENCE NO. <u>3</u>	SHEET <u>4</u> OF <u>25</u>
NOTES <u>HUSS</u>	DATE <u>5/4/12</u>	ROUTE <u>SR 34</u>
H.C. <u>CANTERBURY</u>	WEATHER <u>FAIR</u>	COUNTY <u>WILLIAMS</u>
R.C. <u>HARBAUGH</u>	TEMP. <u>75°</u>	TOWNSHIP <u>FLORENCE</u>
		SECTION <u>18</u>
		T <u>7</u> N R <u>1</u> E

TYPE MONUMENT R.R.SPIKE
~~ON SURFACE~~ - BELOW 0.15'
~~LEFT~~ - Q PAV'T - RIGHT 1'
9.8' TO RT EDGE PAVEMENT
 S.L.M. 52+07

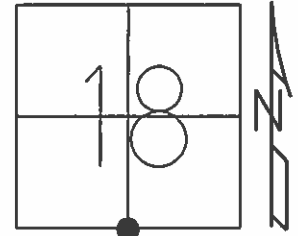

Grid: Northing: 696676.224 Easting: 1343284.264

SET P.K.NAIL
 TO SURFACE
 6/18/96, SAH

FD SM.R.R.SPIKE
 1/26/11, MC
 GPS, REF2
 1/27/11, MC

SET MAG/WASHER
 8/24/12, SAH

