



O.D.O.T. DISTRICT 2 SURVEY OFFICE (USE ONLY)

PERSONNEL _____ REFERENCE NO. 4 G SHEET 14 OF 25
 NOTES HUSS DATE 5/4/12 ROUTE SR 34
 H.C. CANTERBURY WEATHER FAIR COUNTY WILLIAMS
 R.C. HARBAUGH TEMP. 75° TOWNSHIP FLORENCE
 _____ SECTION 17
 _____ T 7 N R 1 E

TYPE MONUMENT P.K.SHANK
~~ON SURFACE~~ - BELOW 0.1'
 LEFT - ℄ PAV'T - RIGHT ON
- TO - EDGE PAVEMENT
 S.L.M. 95+06.70
 GRID: NORTHING: 696557.104 EASTING: 1347222.208

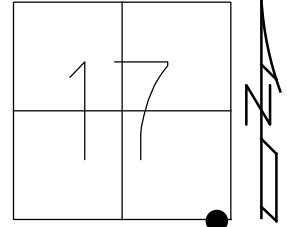

FD "4" CUT
 S.E. BOTTOM
 FLANGE OF
 HYDRANT

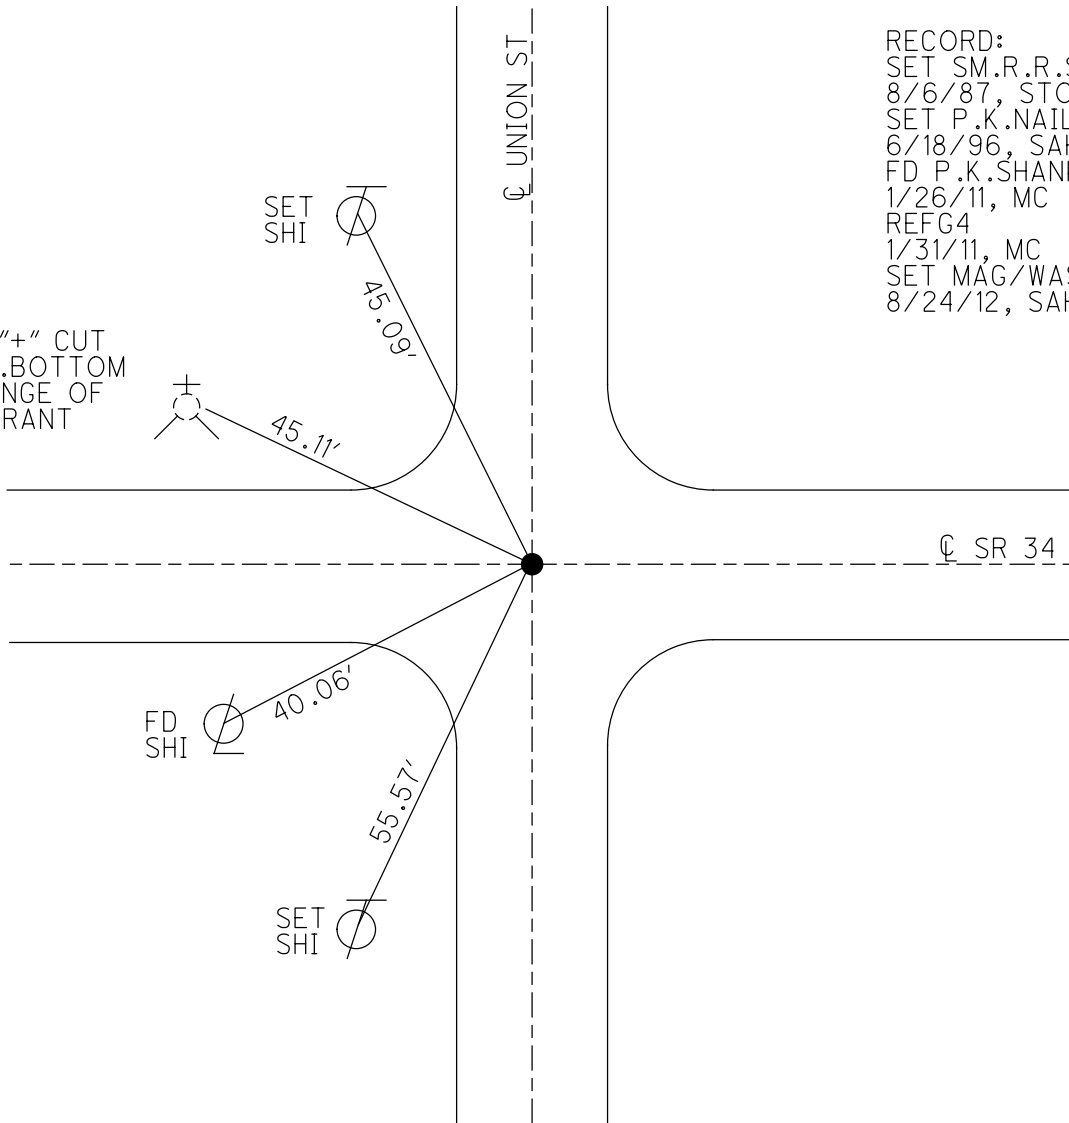

RECORD:
 SET SM.R.R.SPIKE
 8/6/87, STONE
 SET P.K.NAIL
 6/18/96, SAH
 FD P.K.SHANK
 1/26/11, MC
 REFG4
 1/31/11, MC
 SET MAG/WASHER
 8/24/12, SAH