


O.D.O.T. DISTRICT 2 SURVEY OFFICE (USE ONLY)


PERSONNEL _____ REFERENCE NO. 11 SHEET 4 OF 55
 NOTES RHOADES DATE 8/17/20 ROUTE SR 34
 H.C. AUBLE WEATHER CLOUDY COUNTY WILLIAMS
 R.C. RHOADES TEMP. 66° TOWNSHIP FLORENCE
 DWG BY NIESE PID PAVE TRAIN SECTION 26
 T 7 N R 4 W

TYPE MONUMENT MAG/WASHER
 ON SURFACE - ~~BELOW~~ ON
 OFFSET CL PAVEMENT 1.2' ~~RT~~ : RT
9.4' TO RT EDGE PAVEMENT
 STATION: 256+85.82

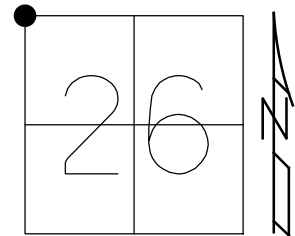

HORZ.DATUM: NAD83 2011 GEOID: NAVD88 2012A
 GRID: NORTHING: 691121.147 EASTING: 1358017.478

RECORD:
 STA.263+11.25
 $\Delta = 0^\circ 09' RT$
 FD P.K.NAIL
 5/31/11, DCH
 SET MAG/WASHER
 9/20/11, DCH
 8/18/21, JFO

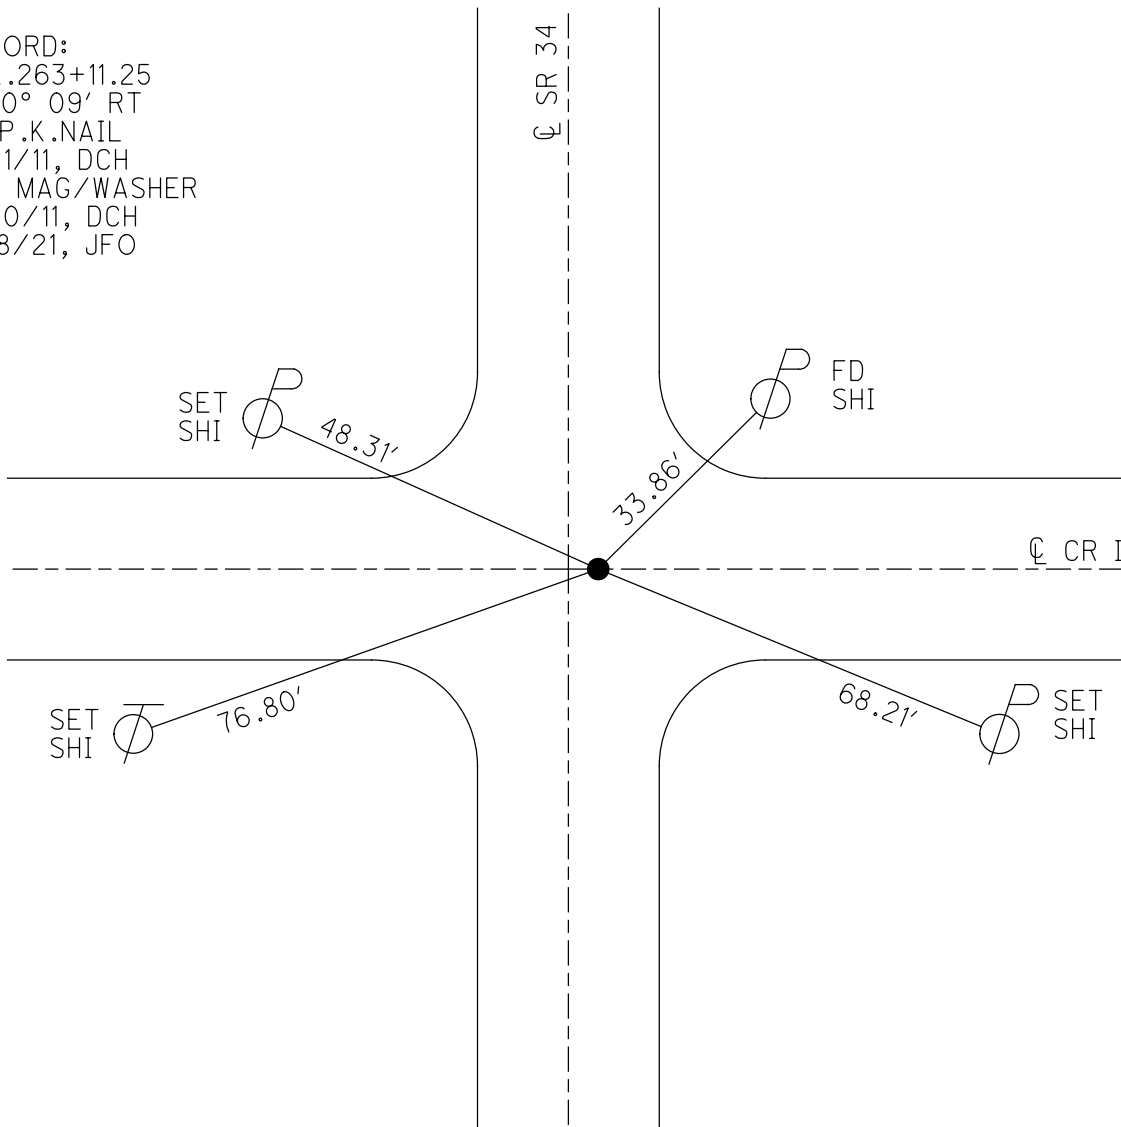

O.D.O.T. DISTRICT 2 SURVEY OFFICE (USE ONLY)

PERSONNEL _____ REFERENCE NO. 11 SHEET 4 OF 55

NOTES _____ DATE 05/31/11 ROUTE SR 34
 H.C. HOMAN WEATHER SUNNY COUNTY WILLIAMS
 R.C. ROUSOS TEMP. 85° TOWNSHIP FLORENCE
 _____ SECTION 26
 _____ T 7 N R 4 W

TYPE MONUMENT _____ PK NAIL _____


ON SURFACE - ~~BELOW~~ _____ ON _____

LEFT - ☉ PAV'T - RIGHT _____ ON, 1.2' RT. ☉ CR I

9.4' TO RT EDGE PAVEMENT

S.L.M. 263+46

GRID: NORTHING: 691121.149 EASTING: 1358017.443

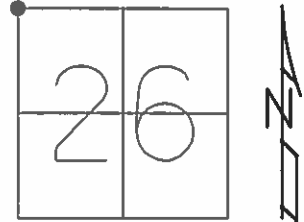

RECORD: SECTION COR.
 OLD STA. 263+11.25
 $\Delta = 0^\circ 09' \text{ RT}$
 SET MAG/WASHER
 09/20/11, DCH

