


O.D.O.T. DISTRICT 2 SURVEY OFFICE (USE ONLY)

PERSONNEL \_\_\_\_\_ REFERENCE NO. 13 SHEET 6 OF 55  
 NOTES ROUSOS DATE 05/31/11 ROUTE SR 34  
 H.C. HOMAN WEATHER SUNNY COUNTY WILLIAMS  
 R.C. ROUSOS TEMP. 85° TOWNSHIP FLORENCE  
 \_\_\_\_\_ SECTION 26  
 \_\_\_\_\_ T 7 N R 4 W

TYPE MONUMENT MON BOX  
 ON SURFACE - ~~BELOW~~ ON  
 LEFT - ☉ PAV'T - RIGHT 0.5' RT  
11.4' TO LT EDGE PAVEMENT  
 S.L.M. 316+31

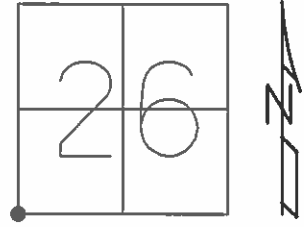

GRID: NORTHING: 685844.964 EASTING: 1357874.371

RECORD: SECTION COR.  
 OLD STA. 315+91.55  
 $\Delta = 0^\circ 14' \text{ LT}$

