


O.D.O.T. DISTRICT 2 SURVEY OFFICE (USE ONLY)

PERSONNEL _____ REFERENCE NO. 14 A SHEET 12 OF 55
 NOTES HOMAN DATE 06/07/11 ROUTE SR 34
 H.C. HOMAN WEATHER SUNNY COUNTY WILLIAMS
 R.C. ROUSOS TEMP. 85° TOWNSHIP FLORENCE
 _____ SECTION 35
 _____ T 7 N R 1 E

TYPE MONUMENT _____ PK NAIL _____
 ON SURFACE - ~~BELOW~~ _____ ON _____
~~LEFT~~ - Q PAV'T - ~~RIGHT~~ _____ ON _____
9.5' TO LT EDGE PAVEMENT
 S.L.M. 356+05
 GRID: NORTHING: 683187.802 EASTING: 1359147.475

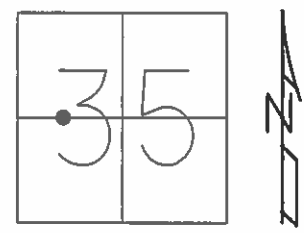

RECORD:
 SET MAG/WASHER
 09/21/11, DCH

