



O.D.O.T. DISTRICT 2 SURVEY OFFICE (USE ONLY)

PERSONNEL	REFERENCE NO.	<u>17 C</u>	SHEET	<u>21</u>	OF	<u>55</u>
NOTES	<u>HOMAN</u>	DATE	<u>06/08/11</u>	ROUTE	<u>SR 34</u>	
H.C.	<u>HOMAN</u>	WEATHER	<u>SUNNY</u>	COUNTY	<u>WILLIAMS</u>	
R.C.	<u>ROUSOS</u>	TEMP.	<u>80°</u>	TOWNSHIP	<u>FLORENCE</u>	
				SECTION	<u>36</u>	
				T	<u>7</u>	R
				E	<u>1</u>	E

TYPE MONUMENT PK NAIL
 ON SURFACE - ~~BELOW~~ ON
 LEFT - ~~C PAV'T~~ - ~~RIGHT~~ 8.7'
3.7' TO LT EDGE PAVEMENT
 S.L.M. 440+59

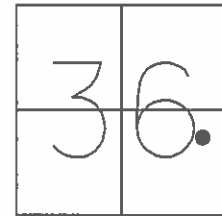

GRID: NORTHING: 682056.630 EASTING: 1367176.367

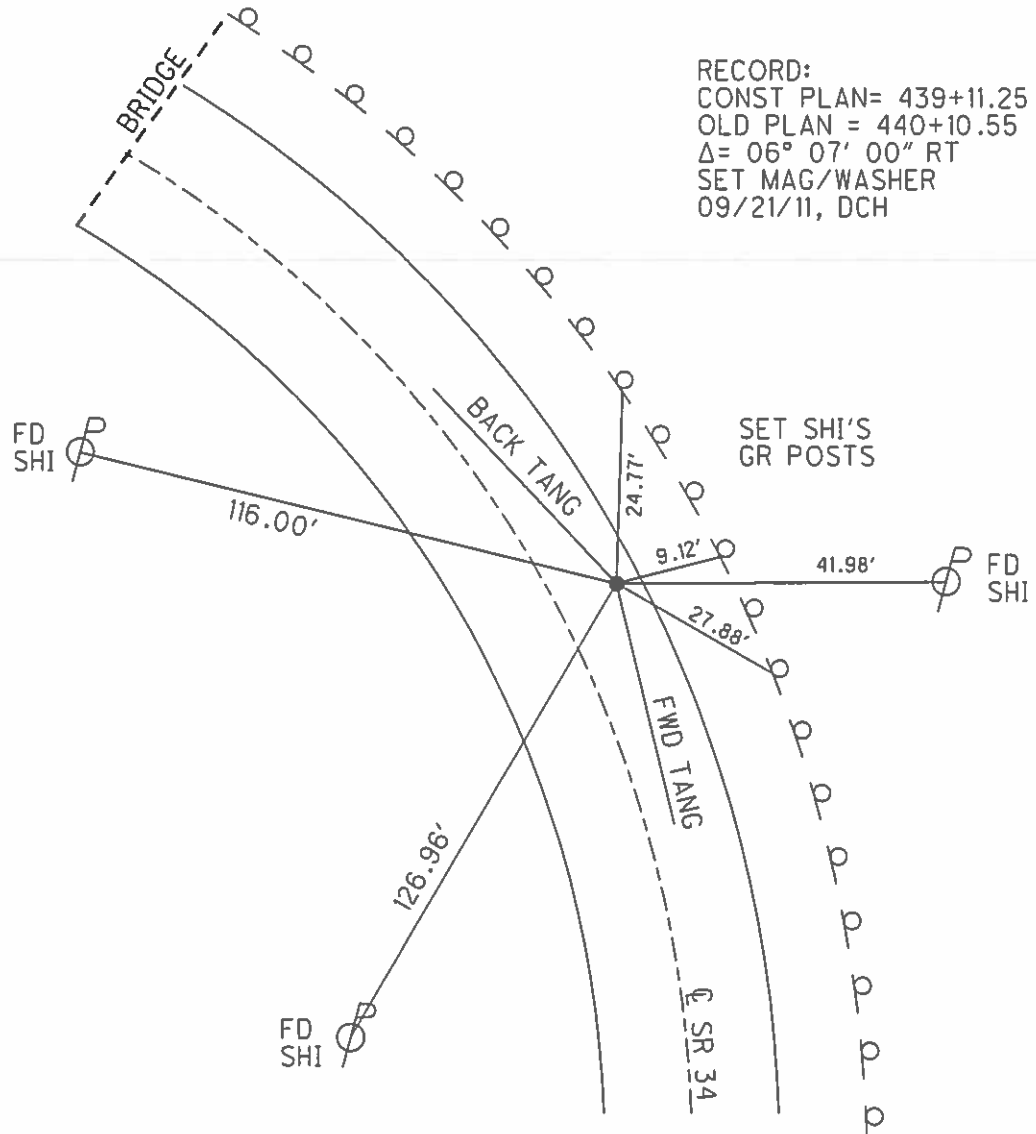

RECORD:
 CONST PLAN= 439+11.25
 OLD PLAN = 440+10.55
 $\Delta = 06^\circ 07' 00''$ RT
 SET MAG/WASHER
 09/21/11, DCH