


O.D.O.T. DISTRICT 2 SURVEY OFFICE (USE ONLY)

PERSONNEL _____ REFERENCE NO. 25 SHEET 32 OF 55
 NOTES HOMAN DATE 06/09/11 ROUTE SR 34
 H.C. HOMAN WEATHER CLOUDY COUNTY WILLIAMS
 R.C. ROUSOS TEMP. 75° TOWNSHIP CENTER
 _____ SECTION 4
 _____ T 6 N R 2 E

TYPE MONUMENT SM RR SPIKE
~~ON SURFACE~~ - BELOW 1.5"
~~LEFT - C PAV'T~~ - RIGHT 1.8'
9.1' TO RT EDGE PAVEMENT
 S.L.M. 613+82

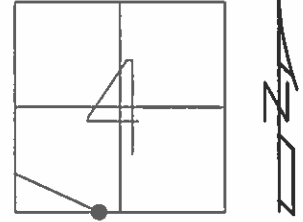

GRID: NORTHING: 675064.008 EASTING: 1381067.675

RECORD:
 SET MAG/WASHER
 09/02/11, DCH

