


O.D.O.T. DISTRICT 2 SURVEY OFFICE (USE ONLY)

PERSONNEL \_\_\_\_\_ REFERENCE NO. 28 SHEET 34 OF 55  
 NOTES HOMAN DATE 06/29/11 ROUTE SR 34  
 H.C. HOMAN WEATHER SUNNY COUNTY WILLIAMS  
 R.C. ROUSOS TEMP. 70° TOWNSHIP CENTER  
 \_\_\_\_\_ SECTION 9  
 \_\_\_\_\_ T 6 N R 2 E

TYPE MONUMENT \_\_\_\_\_ PK NAIL \_\_\_\_\_  
 ON SURFACE - ~~BELOW~~ \_\_\_\_\_ ON \_\_\_\_\_  
 LEFT - ~~C PAV'T~~ - ~~RIGHT~~ \_\_\_\_\_ 0.5' \_\_\_\_\_  
8.4' TO RT EDGE PAVEMENT  
 S.L.M. 644+55

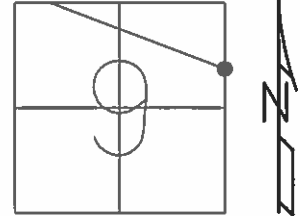

GRID: NORTHING: 673591.668 EASTING: 1384314.465

RECORD:  
 SET MAG/WASHER  
 09/02/11, DCH

