


O.D.O.T. DISTRICT 2 SURVEY OFFICE (USE ONLY)

PERSONNEL _____ REFERENCE NO. 30 SHEET 41 OF 55

NOTES	<u>LEU</u>	DATE	<u>04/08/16</u>	ROUTE	<u>SR 34</u>
H.C.	<u>HOMAN</u>	WEATHER	<u>CLOUDY</u>	COUNTY	<u>WILLIAMS</u>
R.C.	<u>LEU</u>	TEMP.	<u>32°</u>	TOWNSHIP	<u>CENTER</u>
				SECTION	<u>11</u>
				<u>T 6 N R 2 E</u>	

TYPE MONUMENT SMALL RR SPIKE
 ON SURFACE - ~~BELOW~~ ON
 LEFT - ~~C PAV'T~~ - ~~RIGHT~~ 0.3'
10.1' TO LT EDGE PAVEMENT
 S.L.M. 737+19

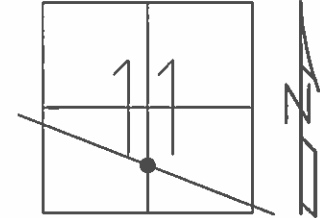

GRID: NORTHING: 669979.188 EASTING: 1392303.187

RECORD:
 SET PK/WASHER
 07/30/01
 UNCOVERED PK NAIL
 09/09/16, DCH
 FD PK/WASHER
 REF30

