

O.D.O.T. DISTRICT 2 SURVEY OFFICE (USE ONLY)

PERSONNEL

REFERENCE NO. 35 CD

SHEET 4 OF 17

NOTES LOEHRKE

DATE 4/20/94

ROUTE SR 34

H.C. CANTERBURY

WEATHER NICE

COUNTY WILLIAMS

R.C. HERMILLER
VOGEL

TEMP. 55°

TOWNSHIP PULOSKI

DWG BY RHOADES PID _____

SECTION 18

T 6 N R 3 E

TYPE MONUMENT 1/2" IPIN

~~ON SURFACE~~ - BELOW 1"


OFFSET Q PAVEMENT ON _____ LT : RT

31.1' TO RT EDGE PAVEMENT


STATION: 858+48

HORZ. DATUM: _____ GEOID: _____

GRID: NORTHING: _____ EASTING: _____

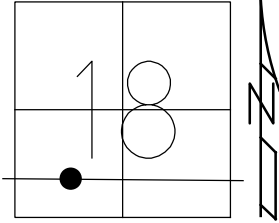

RECORD:
FD 1/2" IPIN
1" DOWN
4/20/94, CL
SET P.K./WASHER
6/21/94, CL

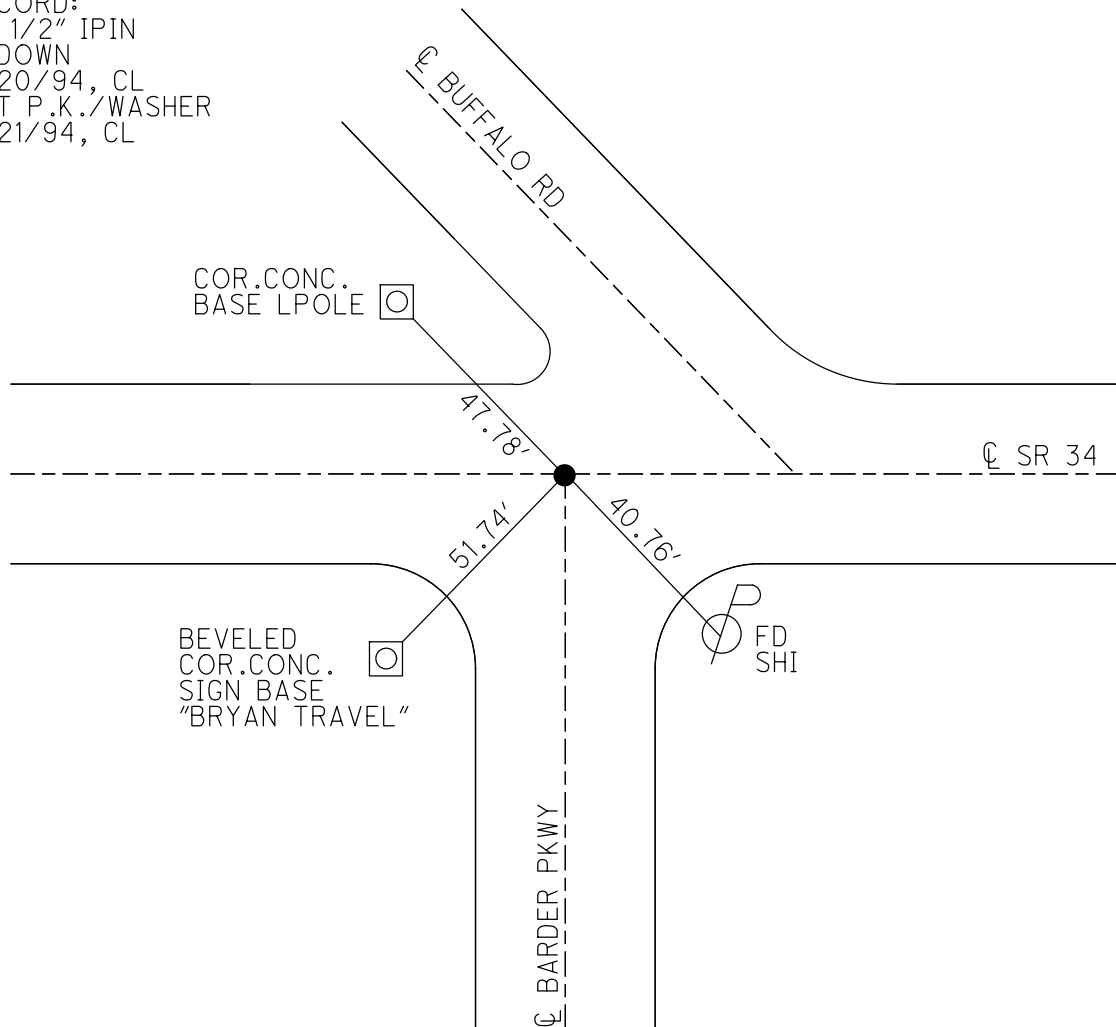

O.D.O.T. DISTRICT 2 SURVEY OFFICE

PERSONNEL _____

REFERENCE NO. 35 CD

SHEET 7 OF 19

NOTES LOEHRKE

H.C. CANTONBUR

R.C. HERRMILLER

VOGEL

DATE 4-20-94

WEATHER Nice

TEMP. +58

ROUTE S. R. 34

COUNTY WILLIAMS

TOWNSHIP PULASKI

SECTION 18

T 6 N R 3 E

Set P.K./WASHER
6-21-94



TYPE MONUMENT 1/2" IRON PIN

ON SURFACE - BELOW 1"

LEFT - & PAV'T. - RIGHT _____

31.1 TO RT EDGE PAVEMENT

S.L.M. 858 +48

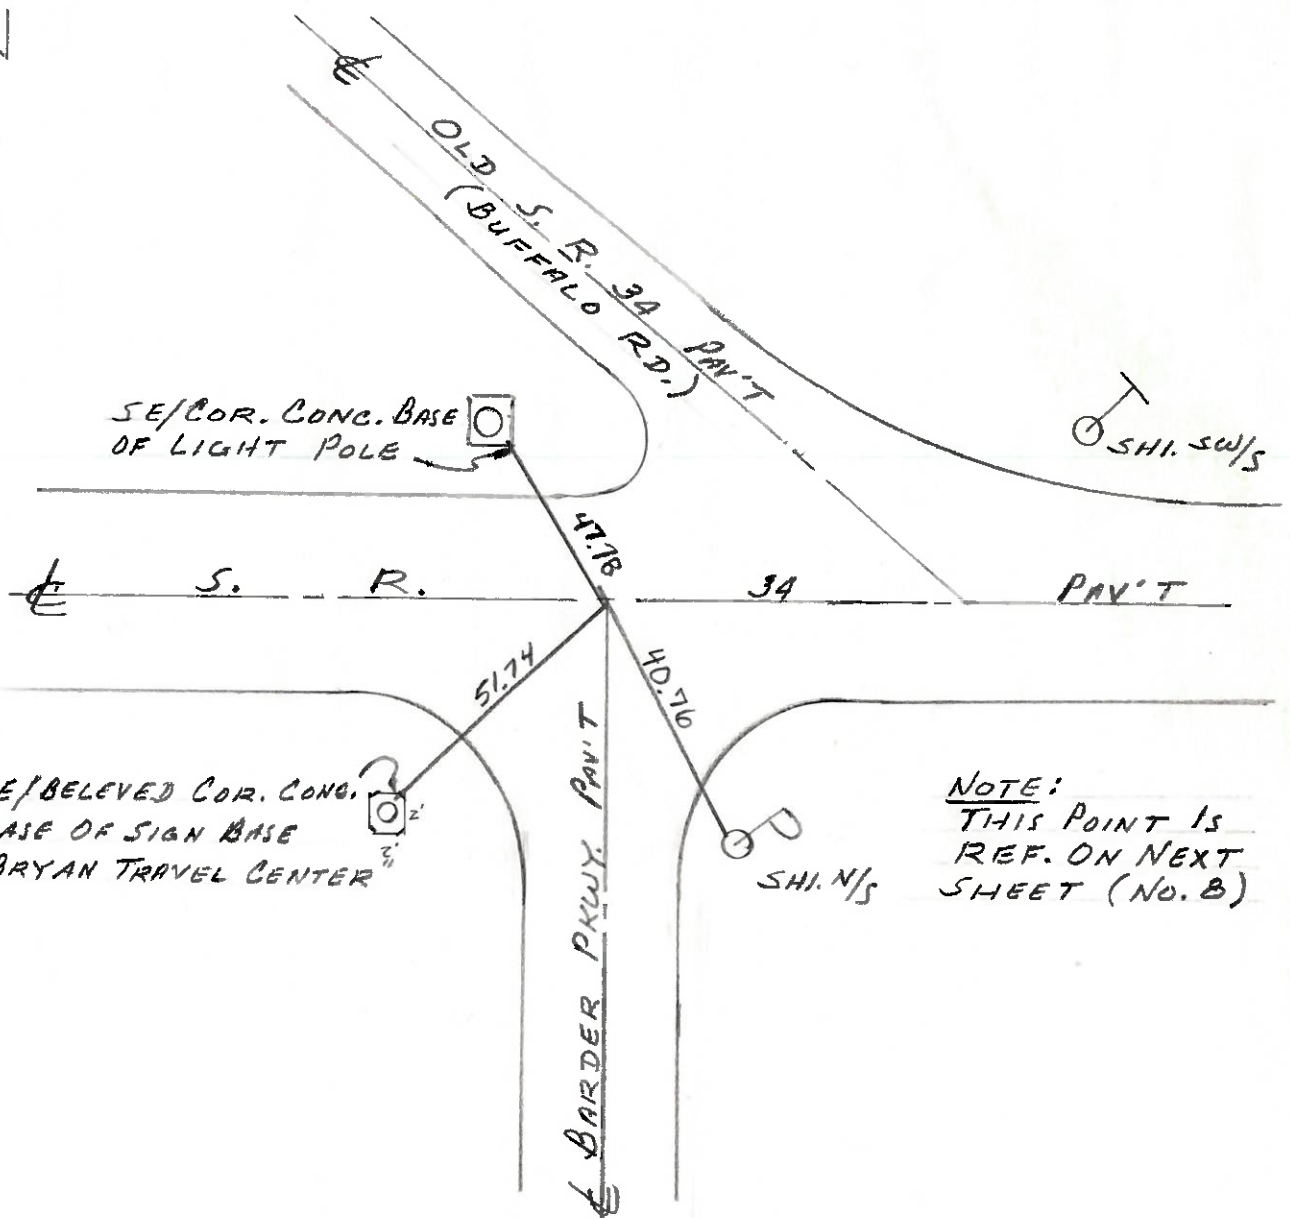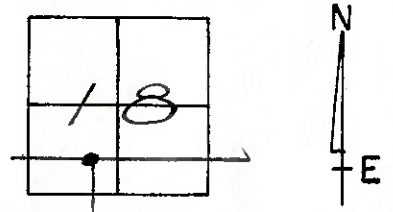

NOTE:
THIS POINT IS
REF. ON NEXT
SHEET (NO. 8)