

O.D.O.T. DISTRICT 2 SURVEY OFFICE (USE ONLY)

PERSONNEL

REFERENCE NO. 35 J

SHEET 11 OF 17

NOTES LOEHRKE

DATE 4/27/94

ROUTE SR 34

H.C. CANTERBURY

WEATHER WINDY

COUNTY WILLIAMS

R.C. HERMILLER

TEMP. 68°

TOWNSHIP PULOSKI

VOGEL

SECTION 18

DWG BY RHOADES PID \_\_\_\_\_

T 6 N R 3 E

TYPE MONUMENT TABLET

~~ON SURFACE~~ - BELOW 1/2"


OFFSET Q PAVEMENT 7.8' ~~RT~~ : RT

14.1' TO RT EDGE PAVEMENT


STATION: 873+39

HORZ. DATUM: \_\_\_\_\_ GEOID: \_\_\_\_\_

GRID: NORTHING: \_\_\_\_\_ EASTING: \_\_\_\_\_

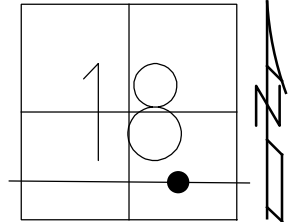

RECORD:  
FD TABLET  
1/2" DOWN  
4/27/94, CL  
SET P.K./WASHER  
6/21/94, CL

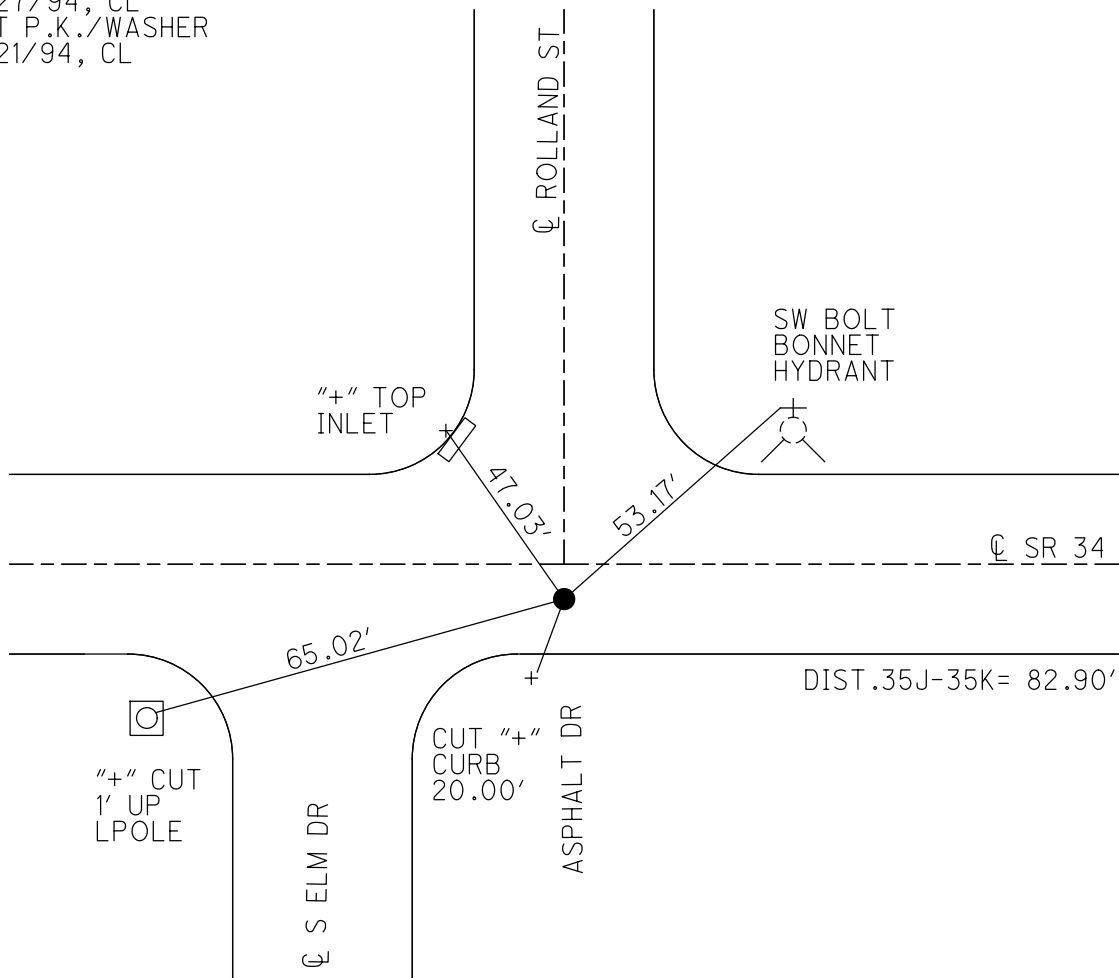

# O.D.O.T. DISTRICT 2 SURVEY OFFICE

PERSONNEL

REFERENCE NO. 35J

SHEET 13 OF 19

NOTES LOEHRKE

H.C. CANTERBURY

DATE 4-27-94

ROUTE S. R. 34

R.C. HERMILLER

WEATHER WINDY

COUNTY WILLIAMS

VOGEL

TEMP. +68

TOWNSHIP PULASKI

SECTION 18

T. 6 N R. 3 E

TYPE MONUMENT TABLET

Set P.K./WASHER  
6-21-94

ON SURFACE - BELOW 1/2" Below

LEFT - 6 PAV'T. - RIGHT 7.8

14.1 TO R+ EDGE PAVEMENT

S.L.M. 873+ 39

