

O.D.O.T. DISTRICT 2 SURVEY OFFICE (USE ONLY)

PERSONNEL

REFERENCE NO. 35 M

SHEET 14 OF 17

NOTES LOEHRKE

DATE 4/25/94

ROUTE SR 34

H.C. VOGEL

WEATHER NICE

COUNTY WILLIAMS

R.C. LOEHRKE

TEMP. 78°

TOWNSHIP PULOSKI

DWG BY RHOADES

PID \_\_\_\_\_

SECTION 18

T 6 N R 3 E

TYPE MONUMENT D.N.F.

ON SURFACE - BELOW \_\_\_\_\_

OFFSET  $\odot$  PAVEMENT \_\_\_\_\_ LT : RT

\_\_\_\_\_ TO \_\_\_\_\_ EDGE PAVEMENT


STATION: 881+65

HORIZ.DATUM: \_\_\_\_\_


GEOID: \_\_\_\_\_

GRID: NORTHING: \_\_\_\_\_

EASTING: \_\_\_\_\_

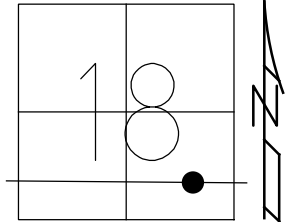

RECORD: P.I.  
STA. 873+99.55  
1970  
D.N.F.  
4/25/94, CL

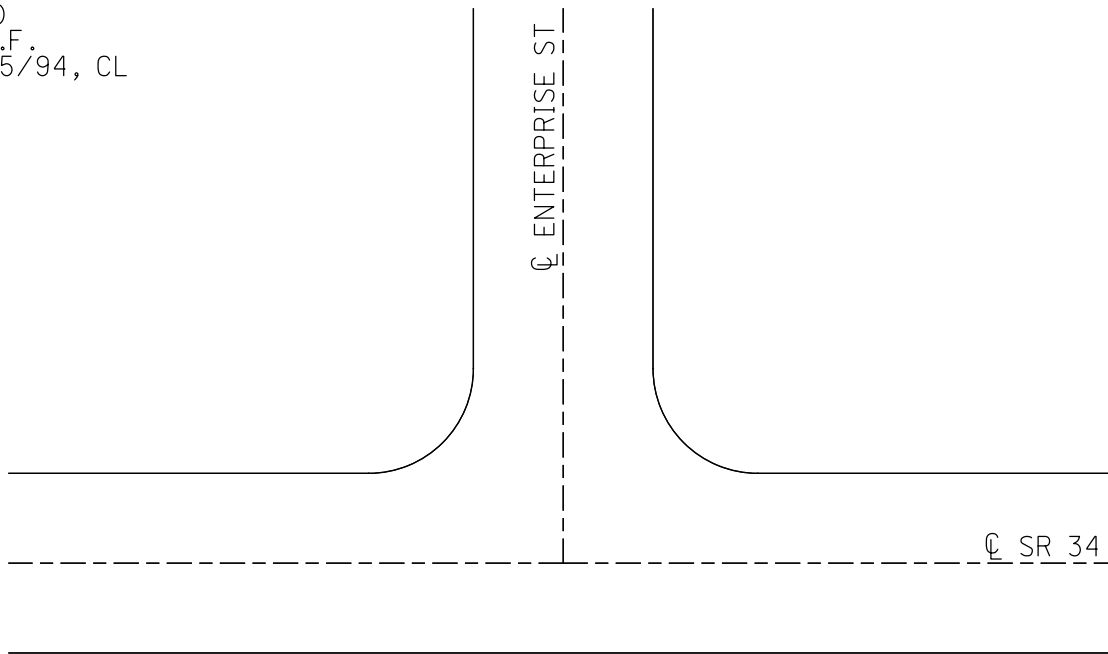

# O.D.O.T. DISTRICT 2 SURVEY OFFICE

PERSONNEL \_\_\_\_\_

REFERENCE NO. 35 M

SHEET 16 OF 19

NOTES LOEHRKE

H.C. \_\_\_\_\_

DATE 4-25-94

ROUTE S.R. 34

R.C. \_\_\_\_\_

WEATHER Nice

COUNTY WILLIAMS

\_\_\_\_\_

TEMP. +78

TOWNSHIP PULASKI

\_\_\_\_\_

SECTION 18

T 6 N R 3 E

TYPE MONUMENT DID NOT FIND

ON SURFACE - BELOW \_\_\_\_\_

LEFT -  $\odot$  PAV'T. - RIGHT \_\_\_\_\_

\_\_\_\_\_ TO \_\_\_\_\_ EDGE PAVEMENT

S.L.M. \_\_\_\_\_

