


O.D.O.T. DISTRICT 2 SURVEY OFFICE (USE ONLY)

PERSONNEL _____ REFERENCE NO. 38 A SHEET 4 OF 17
 NOTES HOMAN DATE 2/6/2013 ROUTE SR 34
 H.C. ROUSOS WEATHER SUNNY COUNTY WILLIAMS
 R.C. HOMAN TEMP. 16° TOWNSHIP PULASKI
 _____ SECTION 15
 _____ T 6 N R 3 E


TYPE MONUMENT PK/WASHER
 ON SURFACE - ~~BELOW~~ ON _____
 LEFT - ☉ PAV'T - ~~RIGHT~~ 0.4'
10.7' TO LT. EDGE PAVEMENT
 S.L.M. 1024+76

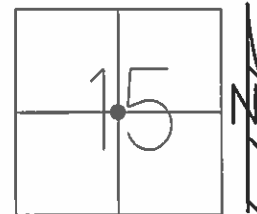

GRID: NORTHING: 666290.415 EASTING: 1418778.585

RECORD:
 FD R.R. SPIKE
 3" DEEP
 1983
 FD P.K./WASHER
 5/3/94
 SET P.K./WASHER
 6/22/94

NOTE:
 SR 2 REF39

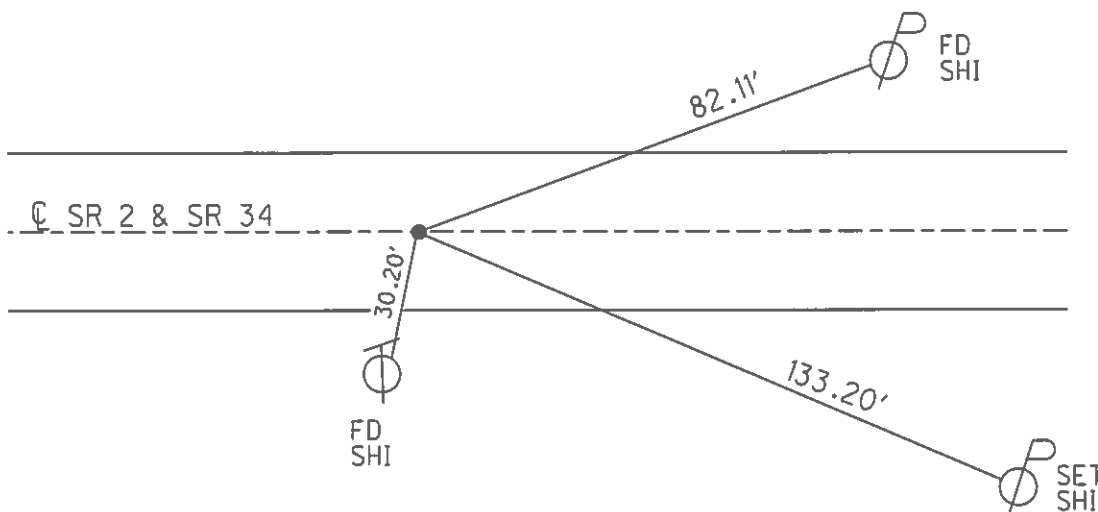

PERSONNEL

TITLE

PERSONNEL

TITLE

COUNTY *W.V.*

DATE

S. R. *34 & E*

WEATHER

SEC. *15 Pulaski TWP*

TEMP

DESCRIPTION

LEFT

CENTER LINE

RIGHT

JOB NO.

