


O.D.O.T. DISTRICT 2 SURVEY OFFICE (USE ONLY)


PERSONNEL _____ REFERENCE NO. 45 SHEET 12 OF 17
 NOTES RHOADES DATE 3-25-16 ROUTE SR 34
 H.C. O'DONNELL WEATHER CLOUDY COUNTY WILLIAMS
 R.C. RHOADES TEMP. 30° TOWNSHIP SPRINGFIELD
 _____ SECTION 18
 _____ T6 N R4 E

TYPE MONUMENT _____ MAG NAIL _____
 ON SURFACE - ~~BELOW~~ _____ ON _____
~~LEFT~~ - CL PAV'T - RIGHT 0.5' _____
 _____ TO _____ EDGE PAVEMENT _____
 S.L.M. 1169+32 _____
 GRID: NORTHING: 665928.971 EASTING: 1432850.852

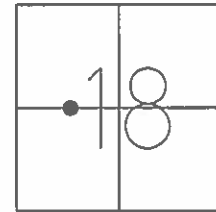

RECORD:
 DNF MAG NAIL
 SET MAG/WASHER
 W/TIES, REFA47
 3-25-15, JFO

NOTE:
 SR 2 REF47A

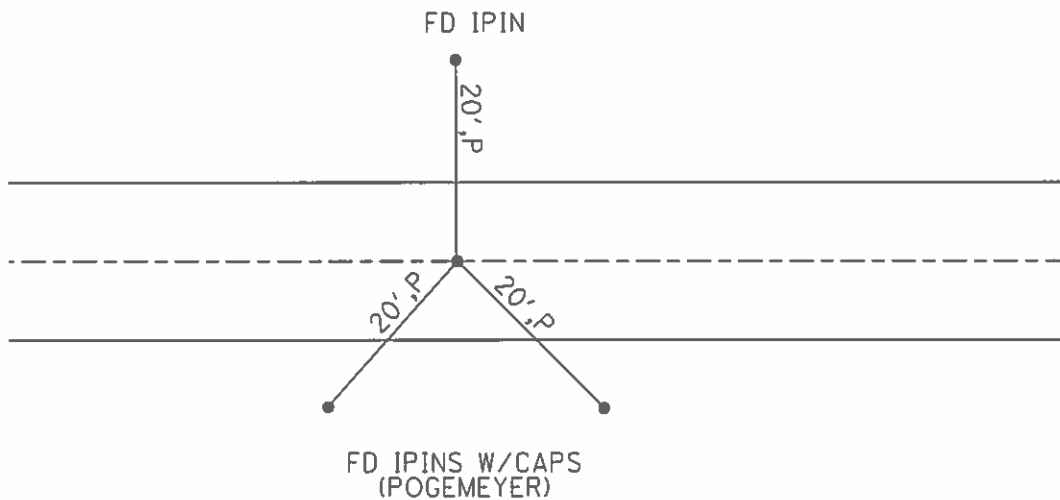

PERSONNEL	TITLE	PERSONNEL	TITLE	COUNTY <u>W.V.</u>	DATE _____
				S. R. <u>311 F 2</u>	WEATHER _____
				SEC. <u>13 Spring Mt. W.V.</u>	TEMP. _____

DESCRIPTION	LEFT	CENTER LINE	RIGHT	JOB NO. _____
-------------	------	-------------	-------	---------------

