


O.D.O.T. DISTRICT 2 SURVEY OFFICE (USE ONLY)


PERSONNEL \_\_\_\_\_ REFERENCE NO. 48 SHEET 15 OF 17  
 NOTES HOMAN DATE 2/6/2013 ROUTE SR 34  
 H.C. ROUSOS WEATHER SUNNY COUNTY WILLIAMS  
 R.C. HOMAN TEMP. 75° TOWNSHIP SPRINGFIELD  
 \_\_\_\_\_ SECTION 17  
 \_\_\_\_\_ T 6 N R 4 E

TYPE MONUMENT 1" IPIPE  
~~ON SURFACE~~ - BELOW 18"  
 LEFT - ☉ PAV'T - ~~RIGHT~~ 100'  
 \_\_\_\_\_ TO \_\_\_\_\_ EDGE PAVEMENT  
 S.L.M. 1218+95  
 GRID: NORTHING: 666362.691 EASTING: 1437752.097

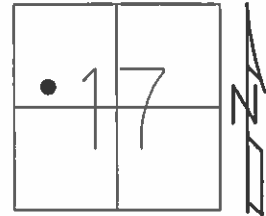

RECORD: P.I.  
 STA. 61+03.86  
 $\Delta = 35^\circ 54''$   
 $D = 3^\circ 00''$   
 $T = 618.72$   
 $R = 1909.86$   
 $L = 1196.67$   
 1935 R/W PLANS

NOTE:  
 SR 2 REF 48

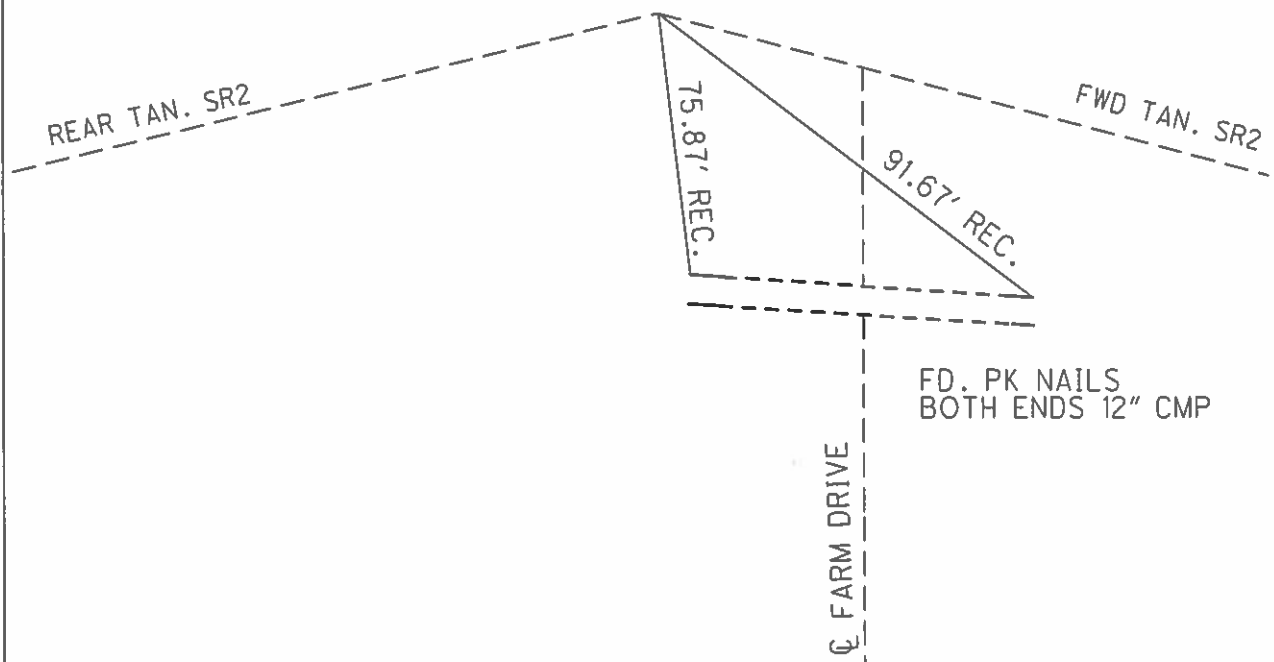

PERSONNEL TITLE PERSONNEL TITLE

COUNTY W.I. DATE \_\_\_\_\_

S. R. 34 & 2 WEATHER \_\_\_\_\_

SEC. 17 Springville Twp. TEMP \_\_\_\_\_

DESCRIPTION LEFT CENTER LINE RIGHT JOB NO.

