


O.D.O.T. DISTRICT 2 SURVEY OFFICE (USE ONLY)

PERSONNEL \_\_\_\_\_ REFERENCE NO. 50 SHEET 1 OF 16

NOTES HOMAN \_\_\_\_\_ DATE 6/29/11 ROUTE SR 34  
 H.C. HOMAN \_\_\_\_\_ WEATHER SUNNY COUNTY WILLIAMS  
 R.C. ROUSOS \_\_\_\_\_ TEMP. 75° TOWNSHIP SPRINGFIELD  
 \_\_\_\_\_ SECTION 16  
 \_\_\_\_\_ T 6 N R 4 E


TYPE MONUMENT SM.R.R.SPIKE  
 ON SURFACE - ~~BELOW~~ ON \_\_\_\_\_  
 LEFT - ☉ PAV'T - RIGHT ON \_\_\_\_\_  
 - TO - EDGE PAVEMENT  
 S.L.M. 1283+91.6

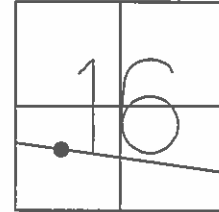

GRID: NORTHING: 665203.124 EASTING: 1444149.821

RECORD:  
 FD R.R.SPIKE  
 10/13/88, DC  
 SET SM.R.R.SPIKE  
 10/31/89, IRS  
 SET MAG/WASHER  
 12-8-11, DCH

NOTE:  
 REF 6 - SR 191  
 REF 50 - SR 2

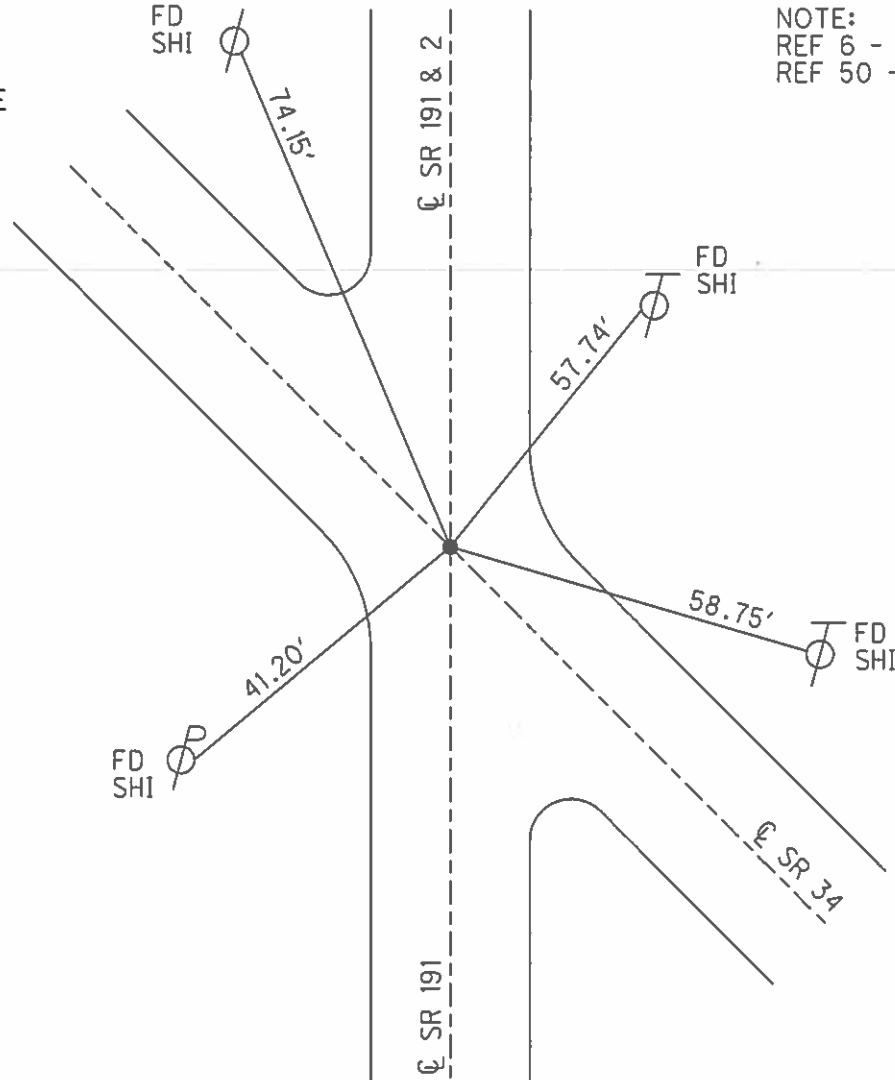

| PERSONNEL | TITLE | PERSONNEL | TITLE | COUNTY                  | DATE           |
|-----------|-------|-----------|-------|-------------------------|----------------|
| Louys     |       |           |       | Wi.                     | 4-1-20         |
| Eriksen   |       |           |       | S. R. 34                | WEATHER Cloudy |
| Rau       |       |           |       | SEC 16 Springfield Twp. | TEMP 35°       |
| Stichney  |       |           |       |                         |                |

| DESCRIPTION | LEFT | CENTER LINE | RIGHT | JOB NO. |
|-------------|------|-------------|-------|---------|
|-------------|------|-------------|-------|---------|

