


O.D.O.T. DISTRICT 2 SURVEY OFFICE (USE ONLY)


PERSONNEL _____ REFERENCE NO. 54 SHEET 2 OF 16
 NOTES HOMAN DATE 6/29/11 ROUTE SR 34
 H.C. HOMAN WEATHER SUNNY COUNTY WILLIAMS
 R.C. ROUSOS TEMP. 75° TOWNSHIP SPRINGFIELD
 _____ SECTION 23
 _____ T 6 N R 4 E

TYPE MONUMENT P.K.NAIL
~~ON SURFACE~~ - BELOW 2"
 LEFT - ☉ PAV'T - RIGHT ON
- TO - EDGE PAVEMENT
 S.L.M. 1371+97

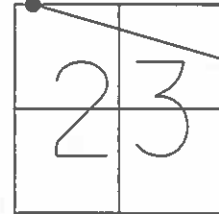

GRID: NORTHING: 662892.249 EASTING: 1453604.473

RECORD:
 FD P.K.NAIL
 8/14/89, IRS
 SET P.K.NAIL
 10/27/89, DJC
 SET MAG/WASHER
 12-8-11, DCH

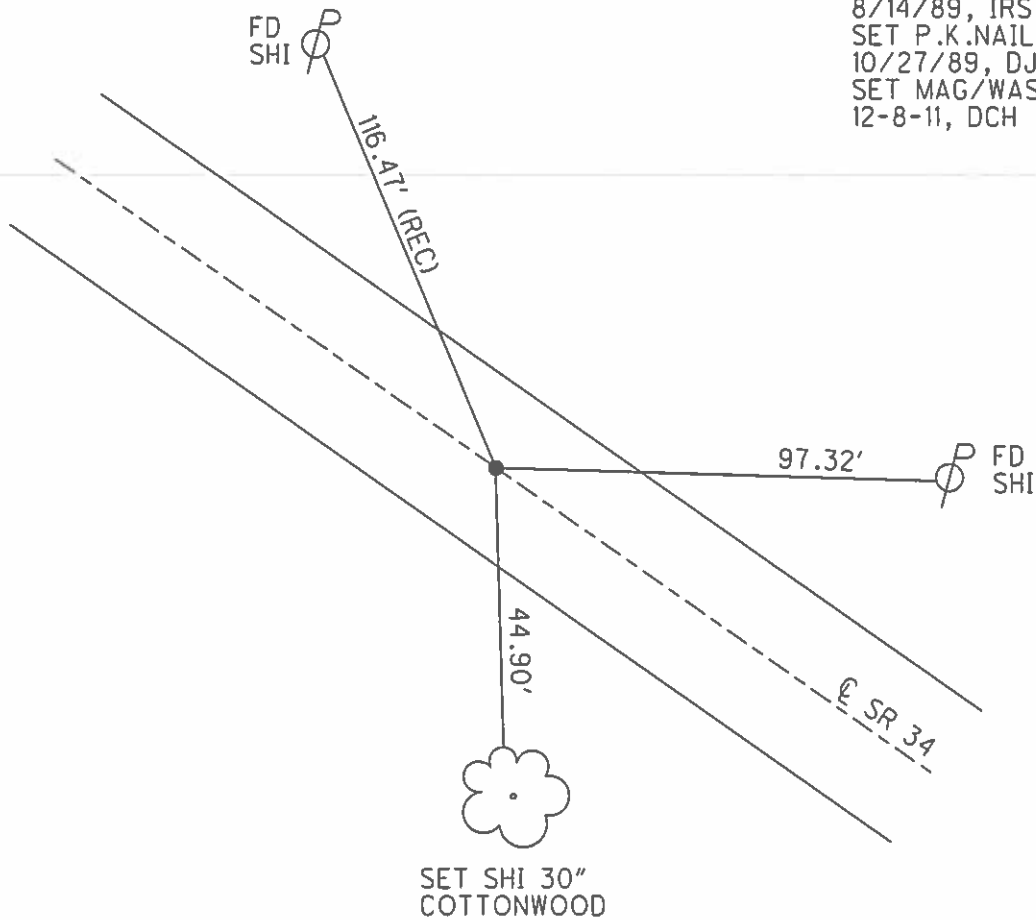

PERSONNEL TITLE PERSONNEL TITLE

COUNTY

DATE

S. R.

WEATHER

SEC. 15 Springfield Twp

TEMP.

DESCRIPTION

LEFT

CENTER LINE

RIGHT

JOB NO.

