


O.D.O.T. DISTRICT 2 SURVEY OFFICE (USE ONLY)

PERSONNEL _____ REFERENCE NO. 56 A SHEET 10 OF 16

NOTES HOMAN DATE 9/22/11 ROUTE SR 34
 H.C. ROUSOS WEATHER CLOUDY COUNTY WILLIAMS
 R.C. HOMAN TEMP. 55° TOWNSHIP SPRINGFIELD
 _____ SECTION 24
 _____ T 6 N R 4 E


TYPE MONUMENT P.K.NAIL
 ON SURFACE - ~~BELOW~~ ON _____
 LEFT - ☉ PAV'T - RIGHT _____
 - TO - _____ EDGE PAVEMENT
 S.L.M. 1449+90

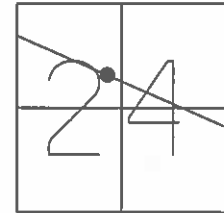

GRID: NORTHING: _____ EASTING: _____


RECORD:
 FD P.K.NAIL
 CTR OF CURVE
 8/14/89, IRS
 SET P.K.NAIL
 11/27/89, DJC
 DNF PNT
 9/22/11, DCH

NOTE:
 RECORD DISTANCE
 ON 8/14/89, DC

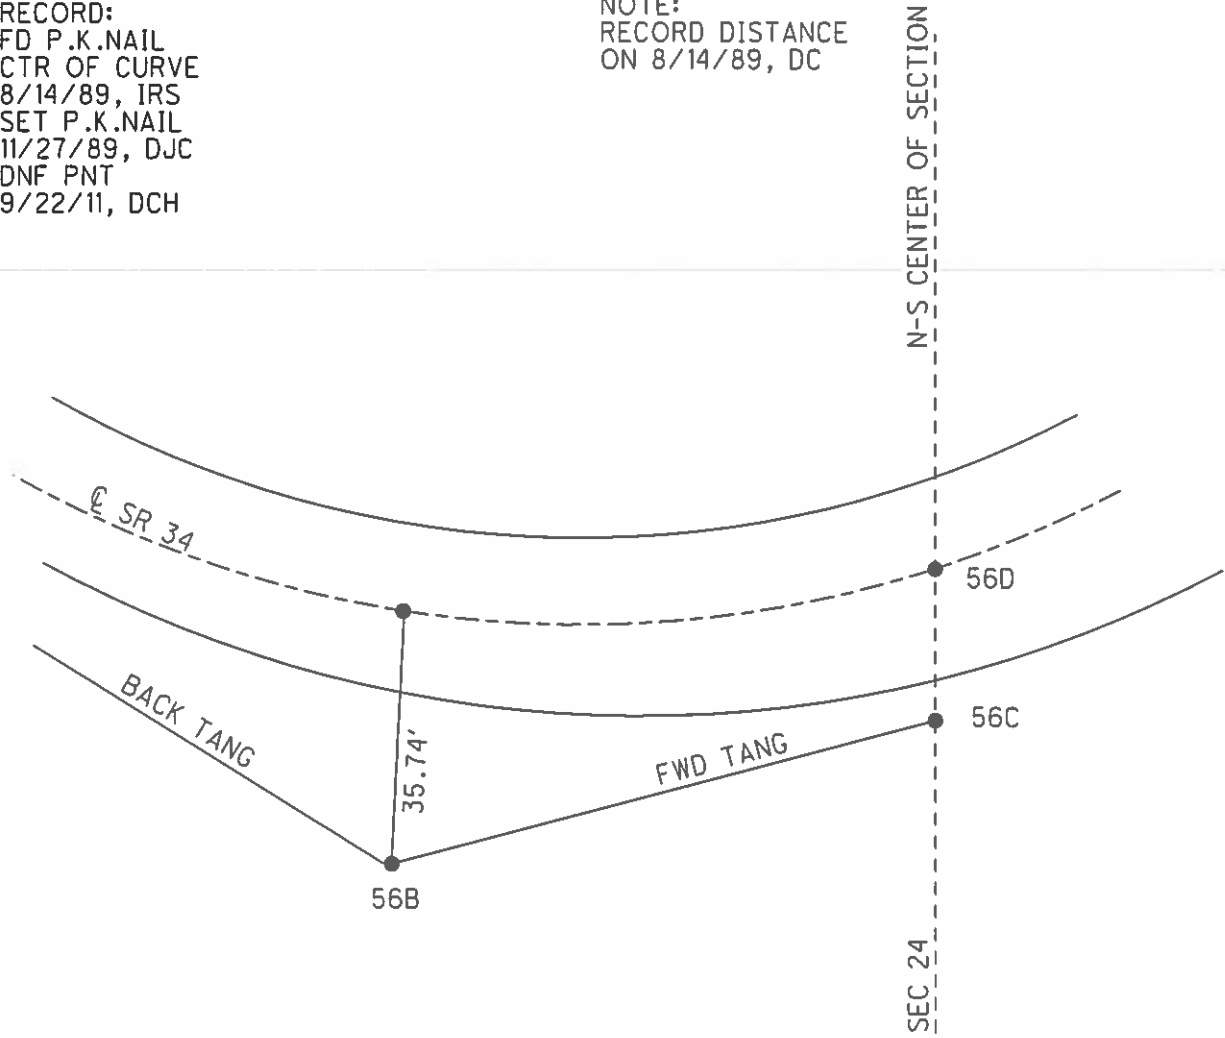

PERSONNEL	TITLE	PERSONNEL	TITLE	COUNTY	DATE
Longs				WI	7-2-68
Erickson				S. R. 34	WEATHER Fair
Rau				SEC. 24 Springfield Twp	TEMP.

DESCRIPTION 1/2" P.I. Survey of Rt #34 JOB NO. _____

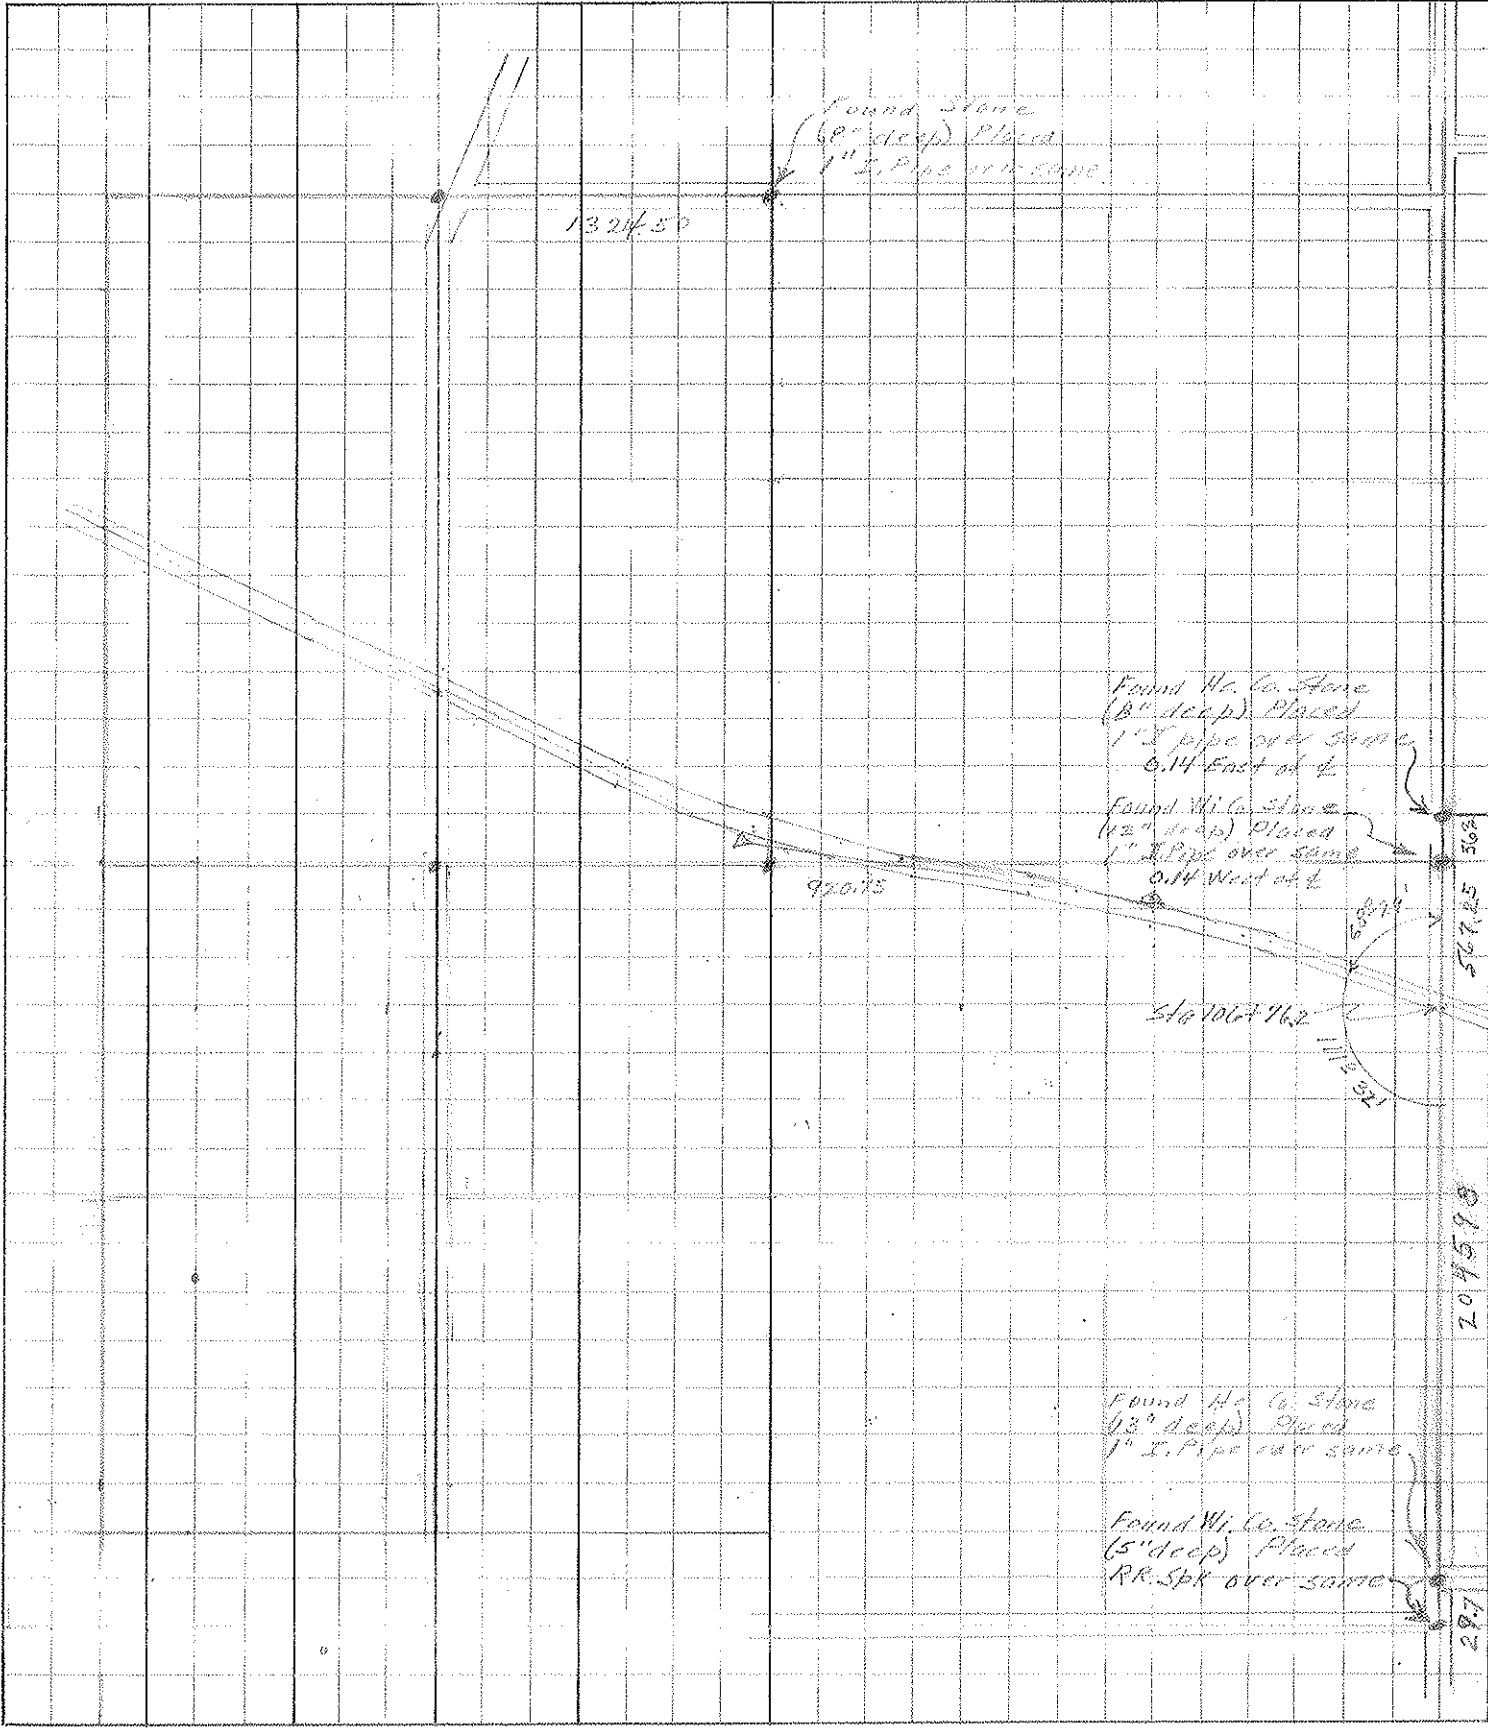

PERSONNEL TITLE PERSONNEL TITLE

COUNTY WV DATE 2-3-71

S. R. 34 WEATHER Cloudy

SEC. 14 23 Springfield Twp TEMP. 20°

DESCRIPTION LEFT CENTER LINE RIGHT JOB NO.

DESCRIPTION	LEFT	CENTER LINE	RIGHT	JOB NO.

*Found 4" I. Pipe (6" deep)
allegedly over stone*