


O.D.O.T. DISTRICT 2 SURVEY OFFICE (USE ONLY)

PERSONNEL _____ REFERENCE NO. 57 A SHEET 15 OF 16

NOTES HOMAN _____ DATE 9/22/11 _____ ROUTE SR 34
 H.C. ROUSOS _____ WEATHER SUNNY _____ COUNTY WILLIAMS
 R.C. HOMAN _____ TEMP. 60° _____ TOWNSHIP SPRINGFIELD
 _____ SECTION 24
 _____ T 6 N R 4 E


TYPE MONUMENT _____ IPIPE _____
~~ON SURFACE~~ - BELOW _____ 6"
 LEFT - ☉ PAV'T - ~~RIGHT~~ _____ 15'
 _____ TO _____ EDGE PAVEMENT
 S.L.M. _____ 1466+41.05

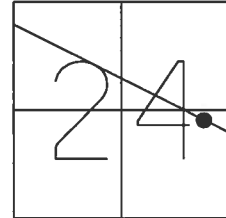

GRID: NORTHING: 660003.503 EASTING: 1462572.747

RECORD: P.I.
 $\Delta = 9^\circ 58'$ RT REC
 $D = 1^\circ 00'$
 $T = 499.59'$
 $L = 996.67'$
 $E = 21.74$
 $R = 5729.58$
 STA. 94+45.14
 1989


RECORD:
 FD IPIPE
 8/14/89, IRS
 RESET 3/4" IPIPE
 10/2/89, IRS
 FD IPIPE
 9/22/11, DCH
 FD 1" IPIPE
 9" DOWN
 REF1
 3/1/16, JFO

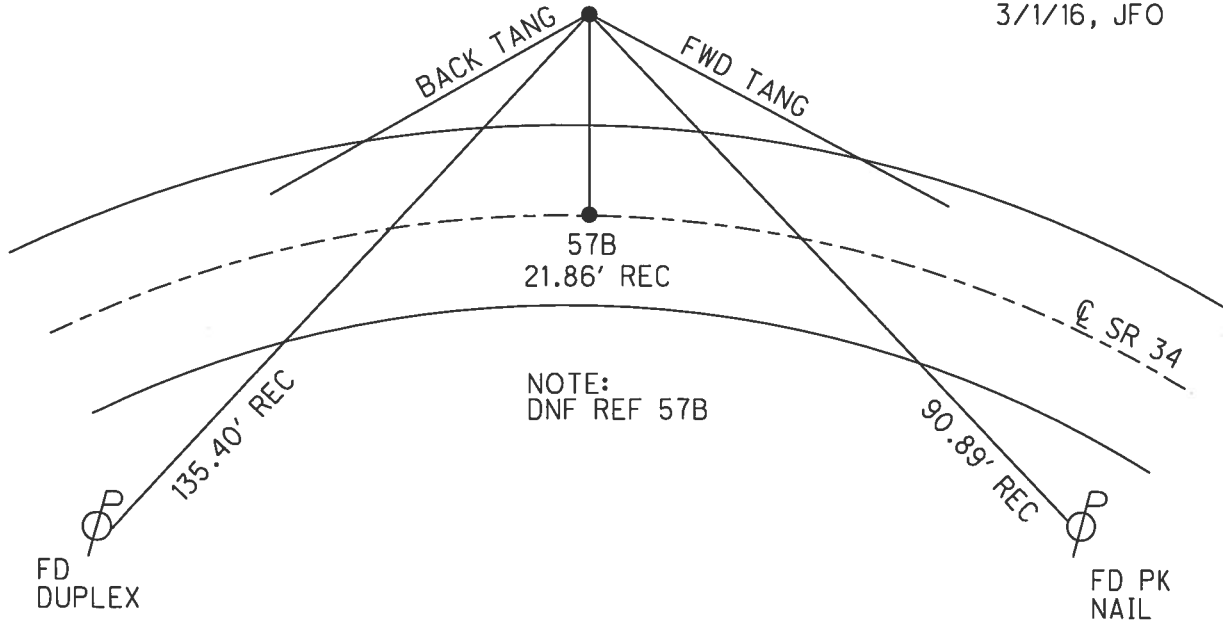

O.D.O.T. DISTRICT 2 SURVEY OFFICE (USE ONLY)

PERSONNEL _____ REFERENCE NO. 57 A SHEET 15 OF 16
 NOTES HOMAN _____ DATE 9/22/11 ROUTE SR 34
 H.C. ROUSOS _____ WEATHER SUNNY COUNTY WILLIAMS
 R.C. HOMAN _____ TEMP. 60° TOWNSHIP SPRINGFIELD
 _____ SECTION 24
 _____ T 6 N R 4 E


TYPE MONUMENT _____ IPIPE
~~ON SURFACE~~ - BELOW _____ 6"
 LEFT - \odot PAV'T - ~~RIGHT~~ _____ 15'
 _____ TO _____ EDGE PAVEMENT
 S.L.M. _____ 1466+41.05

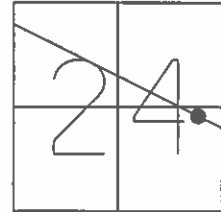

GRID: NORTHING: 660003.465 EASTING: 1462572.669

RECORD: P.I.
 $\Delta = 9^\circ 58'$ RT REC
 $D = 1^\circ 00'$
 $T = 499.59'$
 $L = 996.67'$
 $E = 21.74$
 $R = 5729.58$
 STA. 94+45.14
 1989

RECORD:
 FD IPIPE
 8/14/89, IRS
 RESET 3/4" IPIPE
 10/2/89, IRS
 FD IPIPE
 9/22/11, DCH


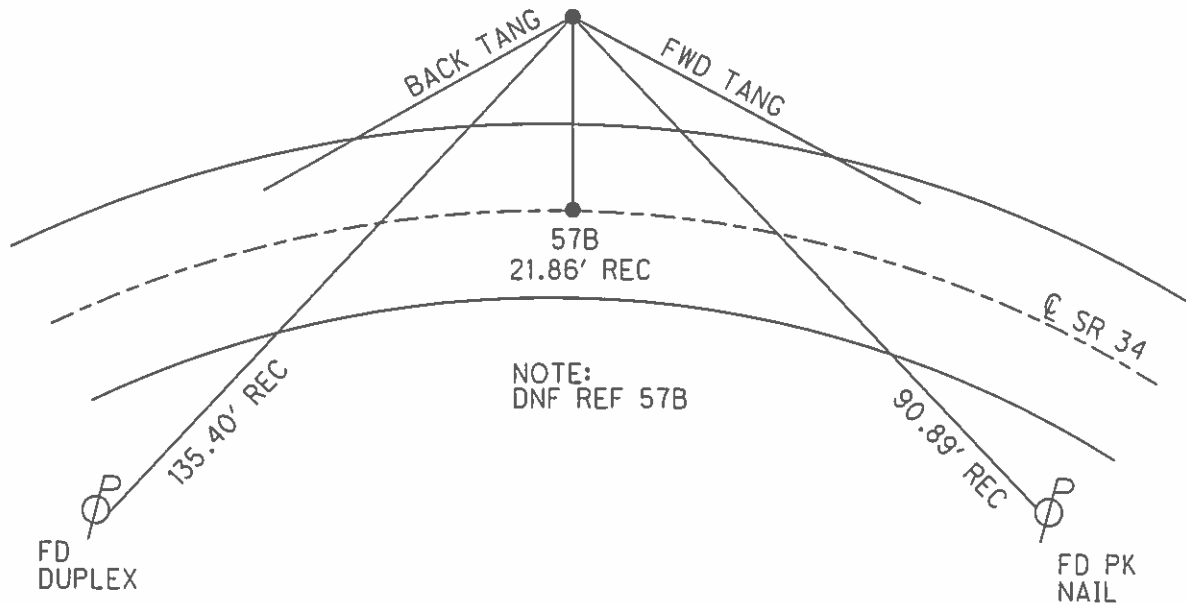


PERSONNEL	TITLE	PERSONNEL	TITLE
Red Beach			
W. Knape			

COUNTY Williams DATE 23 May '77
 S. R. 34 Springfield Twp WEATHER _____
 SEC. 24 County Line Park TEMP. _____

DESCRIPTION CONTROL POINTS JOB NO. _____

Reconstruction of the centerline of the old Bryan-Napoleon road through County Line Park #2-15 as per 1934 Easements of Record, i.e.; parcel #6 Vol. 139 p. 38 and parcel #8 Vol. 139 p. 7 Williams Co Recorders Office.

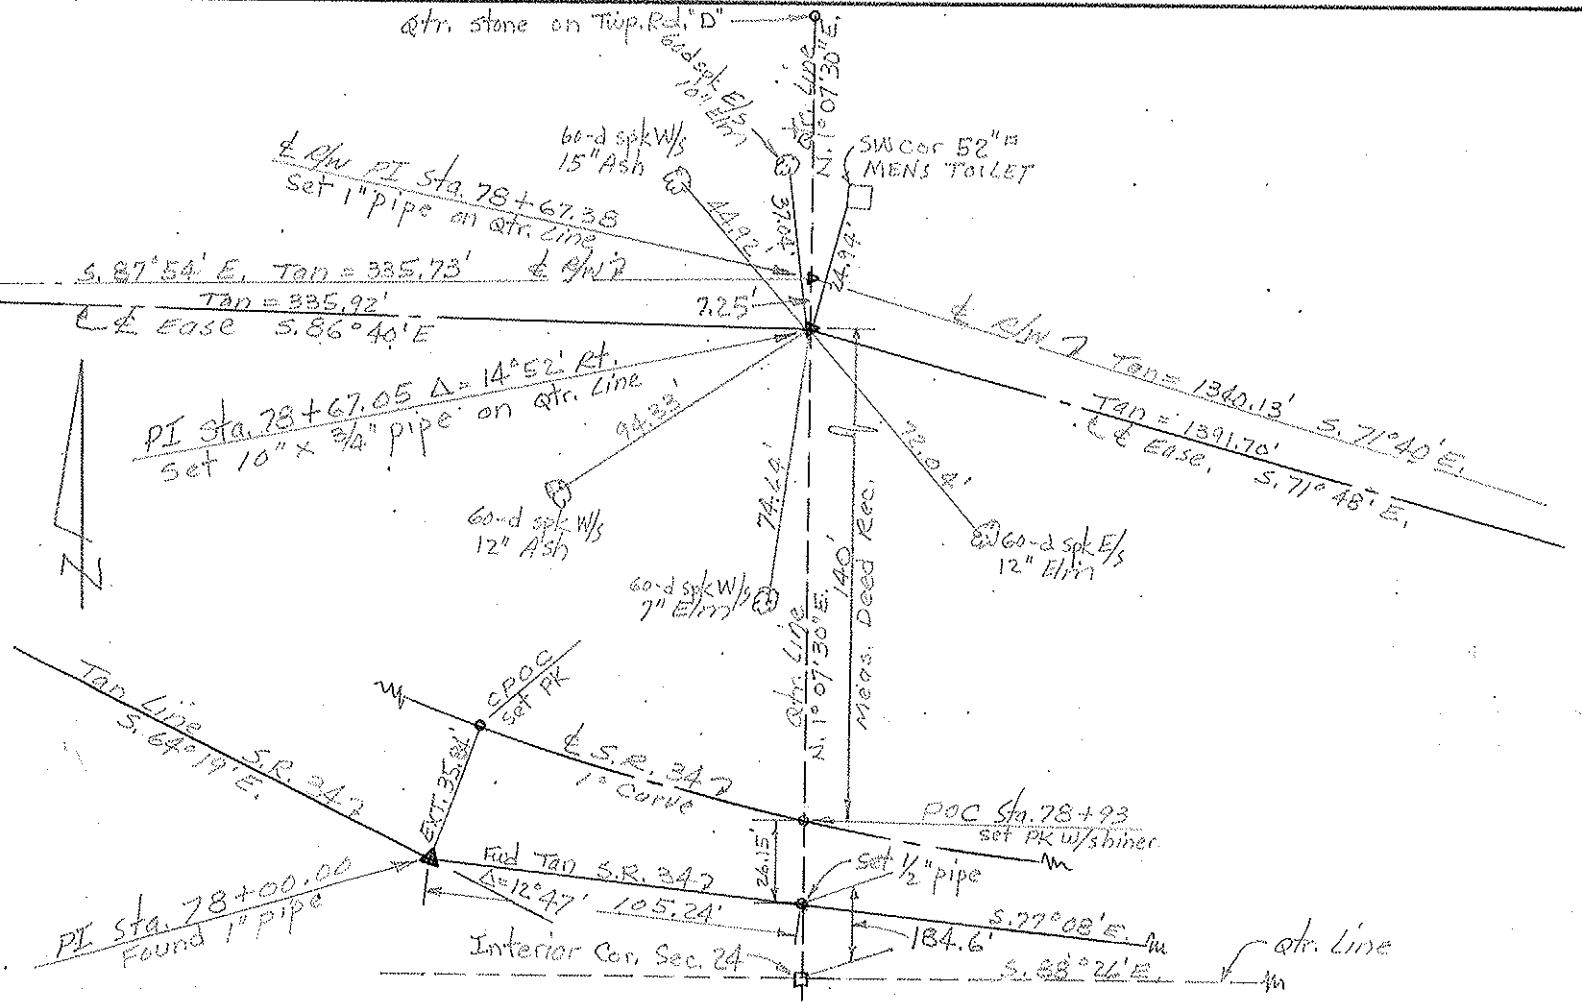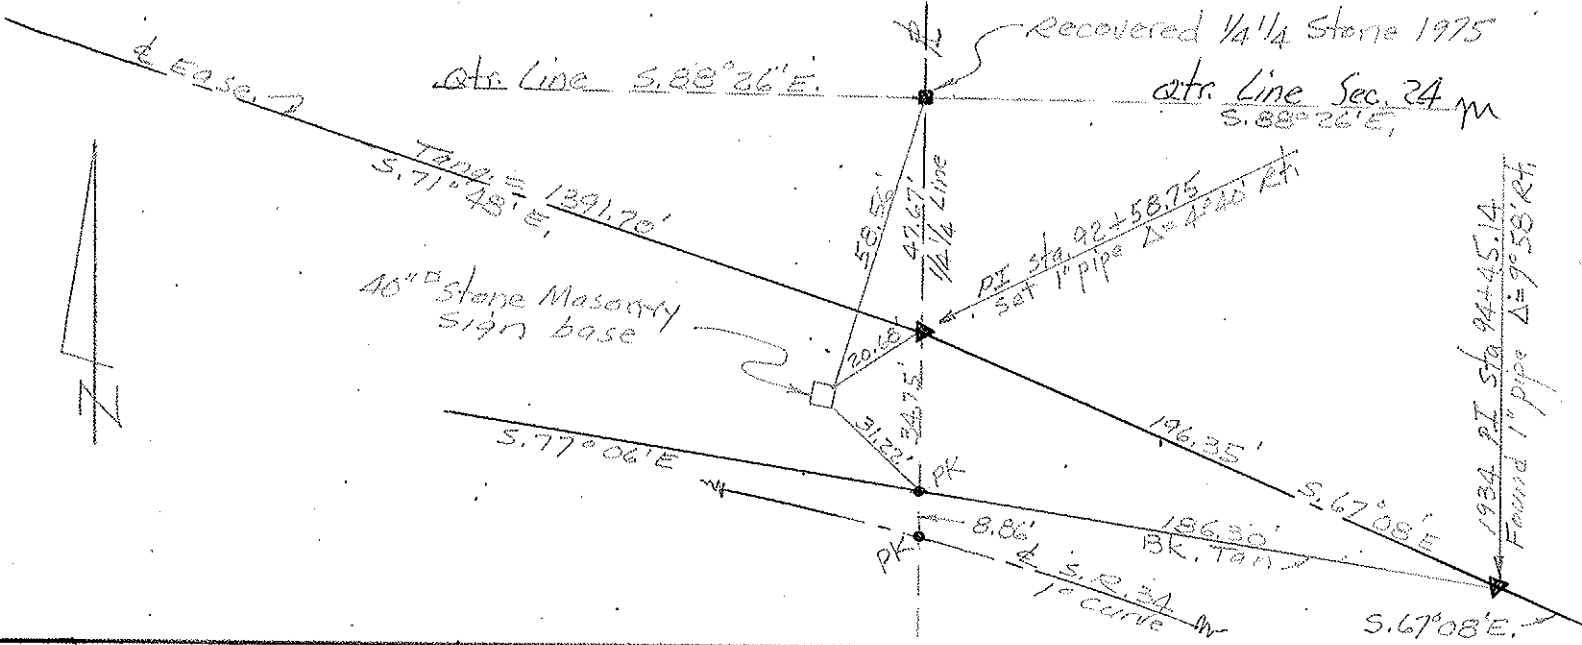

PERSONNEL	TITLE	PERSONNEL	TITLE
<u>Red Beach</u>			
<u>W. Knape</u>			

COUNTY HENRY-WILLIAMS DATE APR. 1975

S. R. 34 WEATHER _____

SEC. COUNTY LINE TEMP _____

DESCRIPTION CONTROL POINTS JOB NO. _____

