

TWO-LANE RESURFACING PROGRAM

PERSONNEL CRAIL LOENKE

NOTES TO:
B. ROSEBROOK
10-5-95

FY 1997

MARK CAUTERBURY

TED ROUSOS

PRIORITY NO. 26 7 PART 1 OF 2 SHEET 1 OF 10
COUNTY WILLIAMS ROUTE SR40 SECTION 10.27
BEGIN LOG (SLM) 10.27 ^{CALC} 542+25.00 TERMINII Edon North Corp Line
END LOG (SLM) 20.54 ^{CALC} 1084+51 TERMINII Michigan State Line
TOTAL LENGTH 9.26 MILES
MUNICIPALITY COONEY (SIGNS) BEGIN LOG (SLM) 521+50 END LOG (SLM) 544+02
MUNICIPALITY COONEY - Fd PK NAIL BEGIN LOG (SLM) 521+99 END LOG (SLM) ---

PROPOSED WORK: Edon Corp to SR107: 1 1/2" 404 - SR107 to US20: 3/4" 403, 1 1/4" 404

PAVEMENT US20 to Michigan 1 1/2" 404 SHOULDER SAME

OTHER SLM 18.7 to 19.0 ± 1" 403 course (dip in road)

^{Recommend 988 to Sta 1002+00}
STATION ESTABLISHED FROM: Fd. Mark Box to Record Pct. Sta 542+36.70 ⇒ @ North

Corp Line of Edon

S.R. 49 North of U.S. 20, to SLM = 10.26 Calc 858 + 52.8
^{Part in Mich ± 1 yr old}

End 1085+17 Joint. State Line - 1085+34 Possible Monument - Did Not Dig

1085+47 Enter Mich Sign Rt

1085+52 Enter Ohio Sign Lt

STRUCTURES:

NUMBER	STATION	WIDTH	LENGTH	PROPOSED WORK
20.02	1058 + 05	32.0'	73.5	- Concrete Deck with Shrinkage Cracks and ± 15 MAJOR PATCHES IN FARE
				to Poor Shape - PAVE OVER?

RAILROAD CROSSING: NONE

(NO WORK)

NAME _____ STATION _____ NO. TRACKS _____ LENGTH ALONG C L _____ FT

DATE 7-20-72

SHEET 2 OF 10

TWO-LANE RESURFACING PROGRAM
INTERSECTIONS

COUNTY WILLIAMS ROUTE SR 49 SECTION 10.27

L = PROP PAVT DEPTH (IN) X 10; W = WIDTH @ MOUTH; W-I = WIDTH @ THROAT

STATION	SIDE	NAME OR NO.	L	W	W-I	ASPH	CONC	REMARKS
568+09	L	Co. Rd. K	15	68.0	30.0	X		
568+09	R	Co. Rd. K	15	72.0	40.0	X		
621+65	L	Co. Rd. L	15	75.0	37.0	X		
621+65	R	SR 107	15	100.0	56.0	X		
638+45	L	Co. Rd. ZL	20	83.0	37.0	X		
683+81	L	Co. Rd. M	20	56.0	17.0			Present. No STONE Rd. } Asphalt Beyond
683+77	R	Co. Rd. M	20	78.0	24.0			STONE Rd. } Berms
710+06	L	Co. Rd. M. 50	20	65.0	25.0	X		
710+06	R	Co. Rd. M. 50	20	57.0	22.0	X		
736+75	L	OLD SR 45 LOW VOLUME OF TRAFFIC	15	127.0	55.0	Y		Feather back 15'
752+44	L	Co. Rd. N. 30	20	66.0	25.0	Y		
752+52	R	Co. Rd. N. 30	20	84.0	26.0	Y		
782+14	L	S. SIDE TURNPIKE RAMP	20	159.0	64.0			CONC
782+14	R	N. SIDE TURNPIKE RAMP	20	132.0	55.0			CONC
789+95	L	S. SIDE TURNPIKE RAMP	20.0	135.0	59.0			CONC
789+95	R	N. SIDE TURNPIKE RAMP	20.0	159.0	71.0			CONC
882+13	L	Co. Rd. O. 50	15.0	70.0	27.0	X		
908+66	L	Co. Rd. P	15.0	43.0	15.0			STONE Rd. - Berm Stone
935+24	L	Co. Rd. P. 50	15.0	80.0	32.0	Y		
935+24	R	Co. Rd. P. 50	15.0	85.0	31.0	X		

SEE SH #7-8

MAY Need more

STONE Rd. - Berm Stone

DATE 7-26-20

SHEET 3 OF 10

TWO-LANE RESURFACING PROGRAM

PAVEMENT DATA

NOTE: LOCATE ALL
CHANGES IN PAVMT WIDTH

COUNTY Will ROUTE S.R. 49 SECTION 10.27

MILE MARKER	STATION	LEFT BERM WIDTH (TYPE)	PAVEMENT WIDTH OUT/OUT WHITE LINES	RIGHT BERM WIDTH (TYPE)
—	542+40	2.6' ASPHALT	22.8'	2.3' ASPHALT
11	580+74	2.0' "	21.3'	2.2' "
12	634+57	2.2' "	20.3'	2.1' "
13	687+63	2.2' "	20.2'	2.5' "
14	739+40	2.8' "	20.7'	2.8' "
SEE SHEET NUMBER 7-8 FOR	AREA NEAR Turnpike			
15	791+94	4.3' "	23.9'	4.2' "
17	898+00	1.9' "	21.8'	1.8' "
18	950+52	2.0' "	22.1'	1.7' "
19	1003+14	2.1' "	22.1'	1.7' "
20	1057+41	2.4' "	20.9'	2.3' "
→	1085+17	2.2' "	20.8'	2.2' "
Joint - State Line				

* = STATION LOCATION

STATION	LANE LT/RT	OTHERS (SKETCH)	* ↑	* R	*SCHOOL	*ONLY	* ↑	* ↑
918+88	Both							
947+65	Both				U.B.			
					S.B.			

DATE 12-2-20SHEET 4 OF 10TWO-LANE RESURFACING PROGRAM
DEFECTIVE PAVEMENT AREASCOUNTY WILL ROUTE SR. 49 SECTION 10.27

STATION		LT BERM	LT LANE	RT LANE	RT BERM	SIZE (WIDTH)	EXISTING PAVEMENT CONDITIONS		
FROM	TO						RUTTED	CRACKED	BASE FAILURE
600+00	601+00	✓				2'	✓	✓	
607+70	612+00				✓	2.5'	✓	✓	✓
621+80	623+20	✓				3'	✓	✓	✓
630+00	648+00	✓	✓			5'	✓	✓	
645+00	647+80			✓		4'	✓	✓	✓
654+50	659+40				✓	5'	✓	✓	
654+50	661+50	✓				6'	✓	✓	
676+40	681+60				✓	3.5'	✓	✓	
684+50	688+30			✓	✓	4'	✓	✓	✓
713+50	720+20			✓	✓	5'	✓	✓	
740+30	742+70			✓	✓	6'	✓	✓	✓
750+90	751+85				✓	4'	✓	✓	
755+80	759+00			✓	✓	4'	✓	✓	✓
758+00	760+00	✓				3'	✓	✓	
763+60	768+20			✓	✓	4'	✓	✓	
767+50	769+00	✓				3'	✓	✓	
772+00	774+40	✓				3'	✓	✓	
782+50	784+20				✓	4'	✓	✓	✓
794+00	797+00			✓	✓	10'	✓	✓	
799+70	802+00			✓	✓	6'	✓	✓	✓

[illegible]

56-2-91

10

10,27

$R = RAISE$

[illegible]

SHEET NO. 6 of 10

PERSONNEL CRALD LOCHMERE TITLE Will COUNTY Will DATE 10-2-95
MARK CANTERBURY S. R. SRH9 WEATHER Nice
TED ROUSSES SEC 14.88 & 14.89 TEMP 104


DESCRIPTION Minimum Vert. Distance under bridges JOB NO. RIGHT
LEFT

S.R.	S.L.M.	Vert. Dist.	Date Checked	Remarks
S.R. 49	14.88	14.65	10-2-95	Center of PAUT UNDER 2 nd Beam
TURNPIKE OVERPASS			E.B.	from South
S.R. 49	14.89	14.68	10-2-95	Center of PAUT UNDER South Most Beam
TURNPIKE OVERPASS			W.B.	


PERSONNEL	TITLE	PERSONNEL	TITLE	COUNTY	DATE	9-26-95
LOEHRKE				WILLIAMS		
				S.R.	S.R. 49	WEATHER FAIR
Craw				SEC.	10.27	TEMP. +58

DESCRIPTION Turnpike Area = New PAUT & New Conc Ramps

LEFT CENTER LINE RIGHT JOB NO.

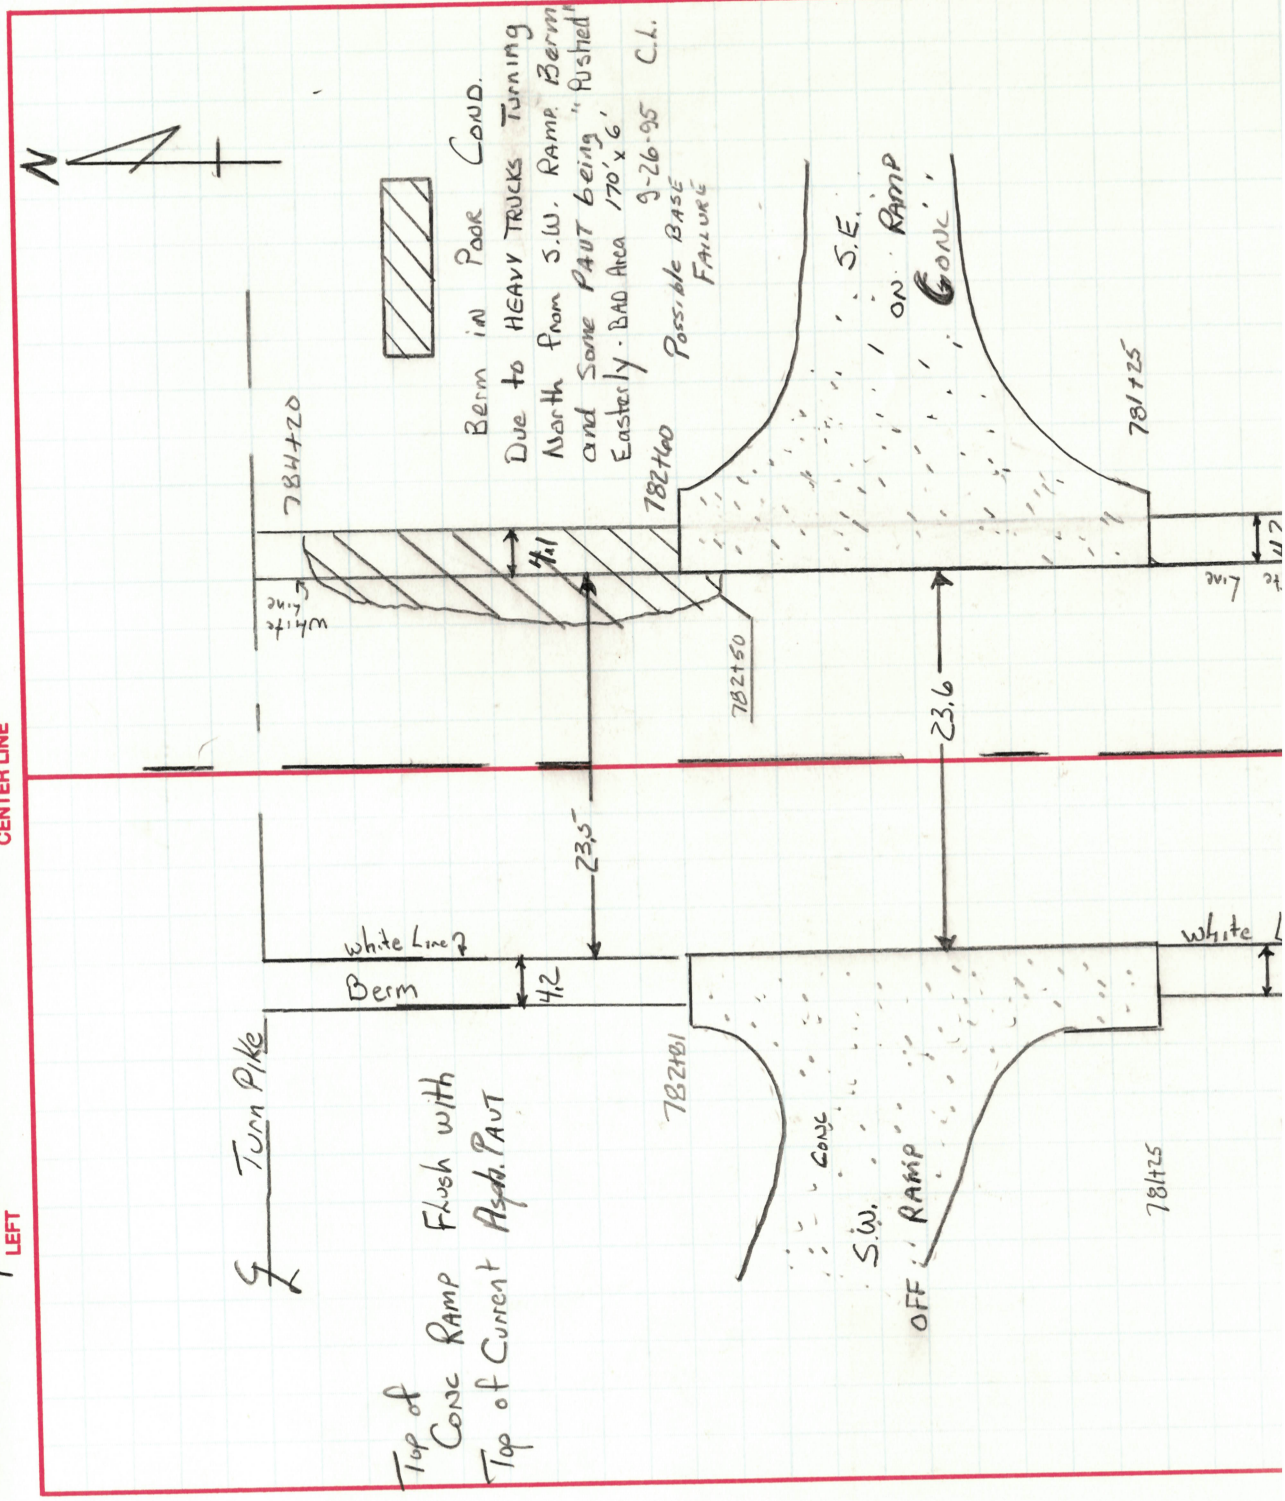


DESCRIPTION	JOB NO. _____	
	LEFT	RIGHT
Turn Pike Area		

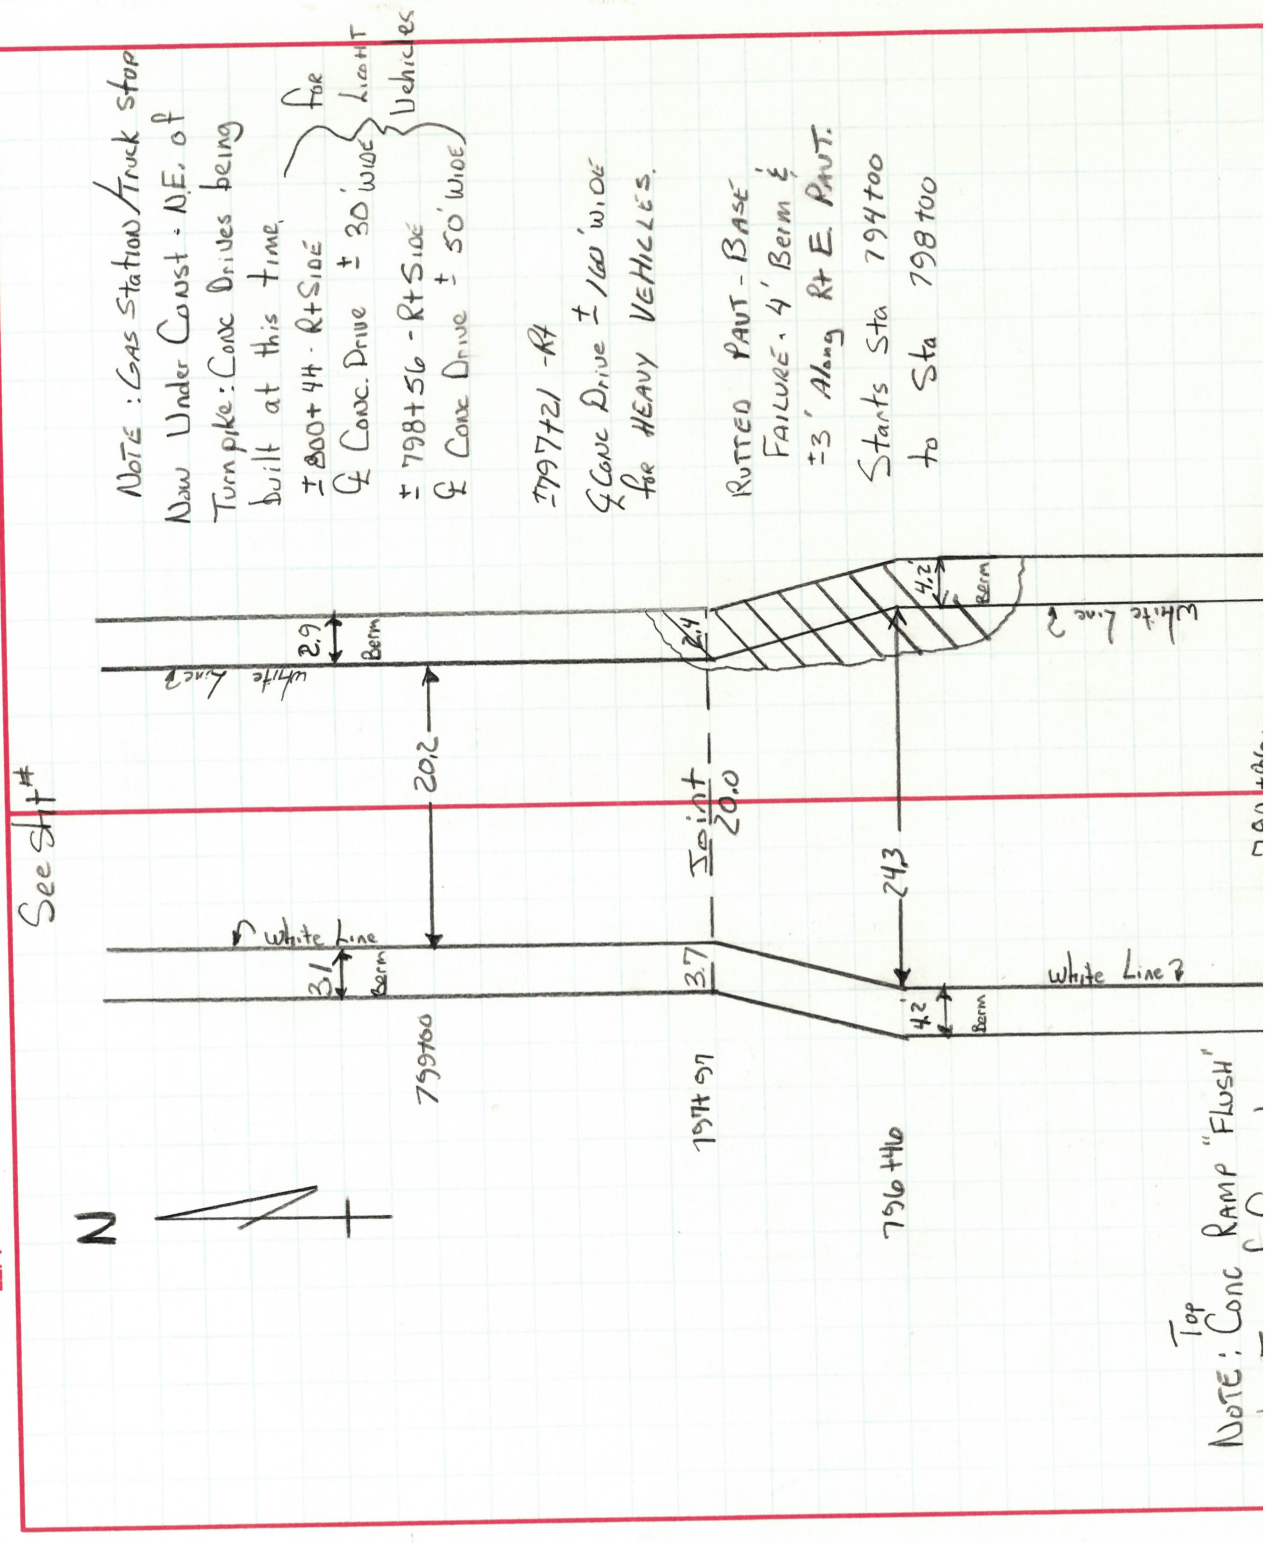

PERSONNEL	TITLE	PERSONNEL	TITLE	COUNTY	DATE	WEATHER
Loehrke		Will		Will	9-26-95	Nicer
Crew				S.R. 49		
				SEC. 10.27		TEMP. +66

DESCRIPTION	LEFT	CENTER LINE	RIGHT	JOB NO.
Will - 49 - 20.02				

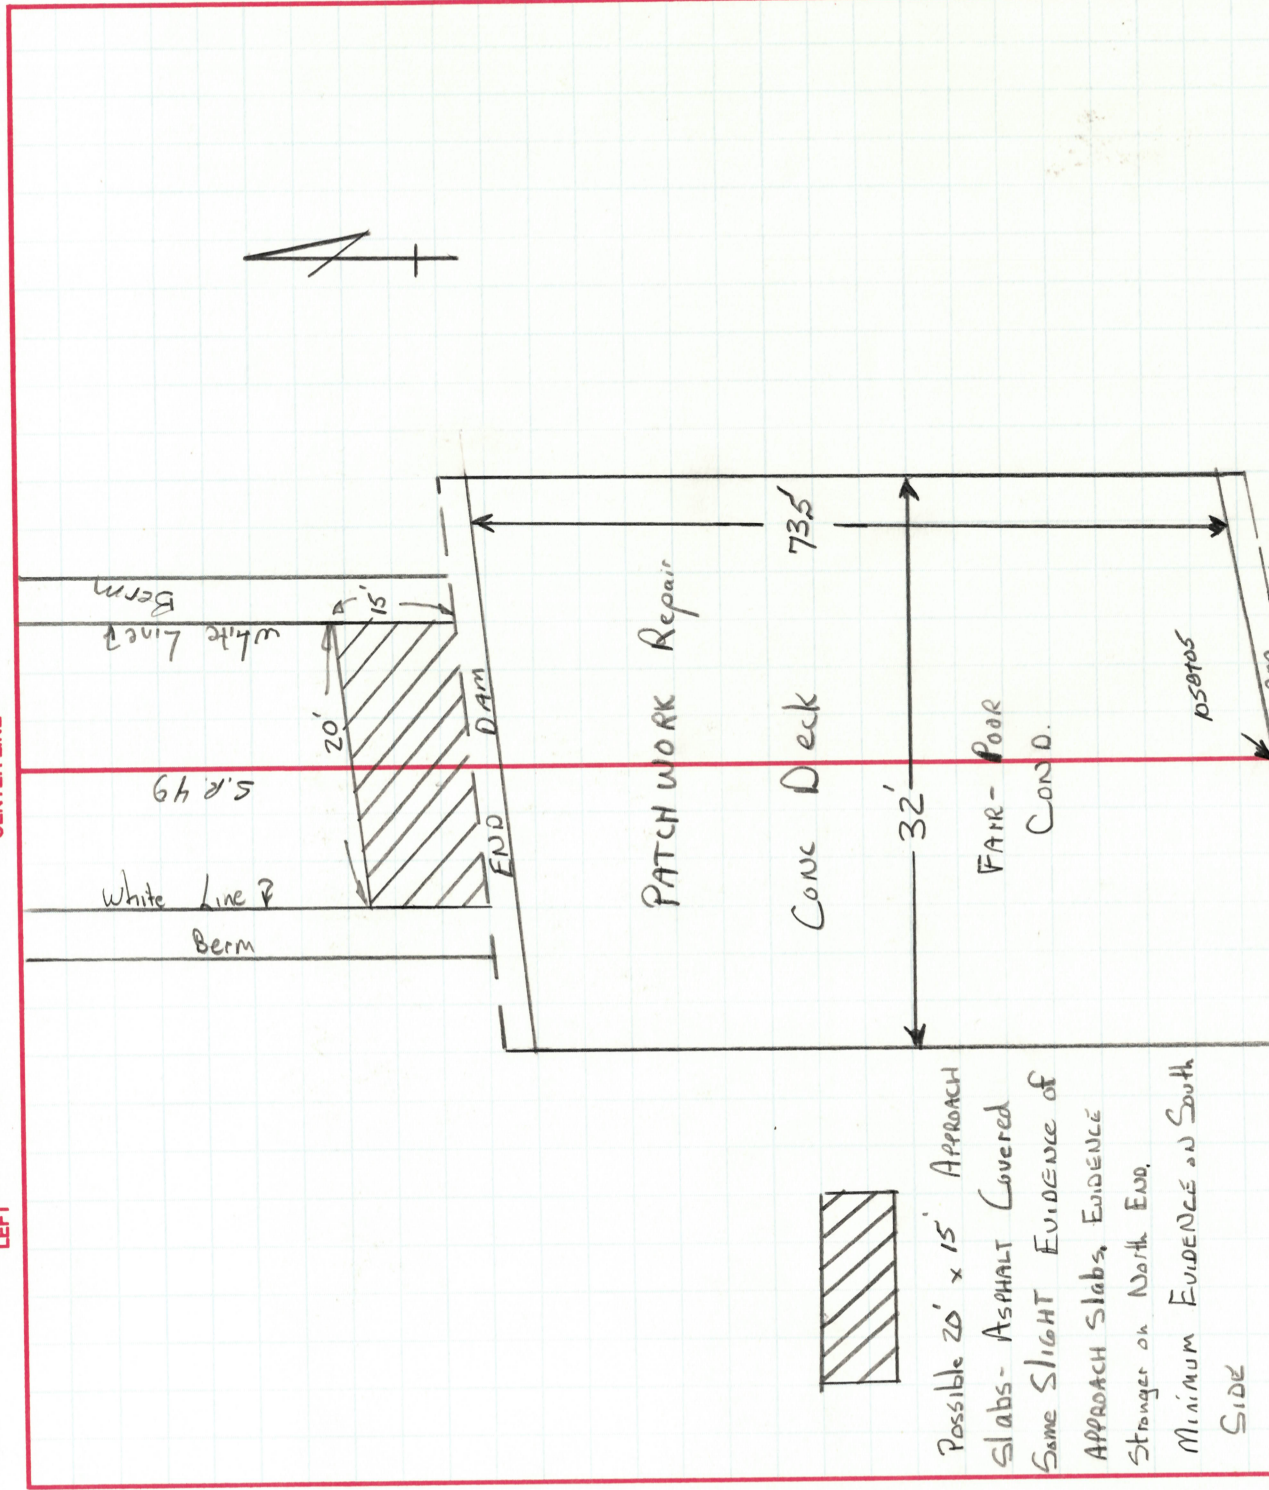


DISTRICT 2 SURVEY OFFICE

REFERENCE NO. 40 SHEET OF

DATE
WEATHER
TEMP.

ROUTE S.R. #49
COUNTY WILLIAMS
TOWNSHIP NORTHWEST
SECTION 27
T 9 S R 4 W

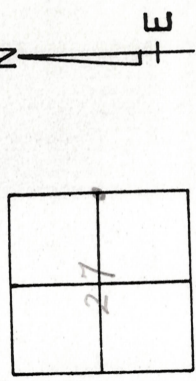

UT

FD. SHALL SPIKE
4" DEEP
9-2-86

b/r #

F-50

L Co. Po.

Copy
of
ties
No New
Measurement

O.D.O.T. DISTRICT 2 SURVEY OFFICE

PERSONNEL _____ REFERENCE NO. 46-A SHEET _____ OF _____

NOTES _____ ROUTE S.R. #49

H.C. _____ DATE _____ COUNTY WILLIAMS

R.C. _____ WEATHER _____ TOWNSHIP NORTHWEST

_____ TEMP. _____ SECTION 27

_____ T 9 S 5 R 4 W W


TYPE MONUMENT _____

ON SURFACE - BELOW _____

LEFT - & PAV'T. - RIGHT _____

_____ TO _____ EDGE PAVEMENT

S.L.M. _____

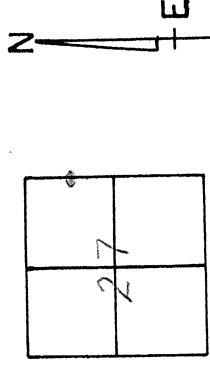

SET SMALL R.R. SPKS.
7-2-86

#49

O.D.O.T. DISTRICT 2 SURVEY OFFICE

PERSONNEL _____ REFERENCE NO. 41 SHEET _____ OF _____

NOTES _____

H.C. _____ DATE _____

R.C. _____ WEATHER _____

_____ TEMP. _____

ROUTE SR #49

COUNTY WILLIAMS

TOWNSHIP NORTHWEST

SECTION 22

T 9 S 3 R 4 W


TYPE MONUMENT _____

ON SURFACE - BELOW _____

LEFT - & PAV'T. - RIGHT _____

_____ TO _____ EDGE PAVEMENT

S.L.M. _____

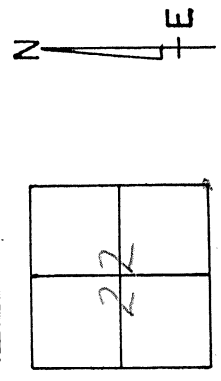

FD. SMALL R.R. SPK
4" DEEP
9-2-86

#49

E Co. Rd. "Q"

O.D.O.T. DISTRICT 2 SURVEY OFFICE

PERSONNEL _____ REFERENCE NO. 42 SHEET _____ OF _____

NOTES _____

H.C. _____

R.C. _____

DATE _____

WEATHER _____

TEMP. _____


ROUTE S.R. #49

COUNTY WILLIAMS

TOWNSHIP NORTHWEST

SECTION 22

T 9 S 4 R 4 M

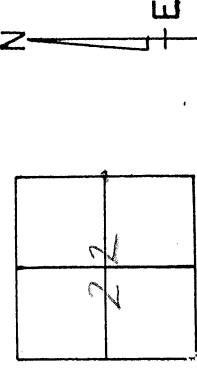

TYPE MONUMENT _____


ON SURFACE - BELOW _____

LEFT - & PAV'T. - RIGHT _____

TO _____ EDGE PAVEMENT

S.L.M. _____

SET SMALL RB. SPK.
9-2-86

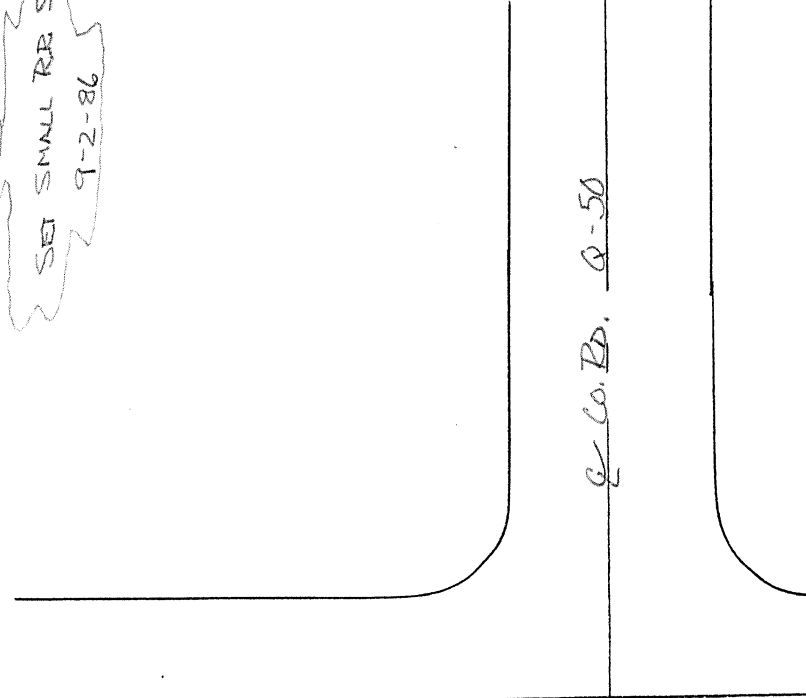

O.D.O.T. DISTRICT 2 SURVEY OFFICE

PERSONNEL _____ REFERENCE NO. 43 SHEET _____ OF _____



NOTES _____ ROUTE S.R. #49

H.C. _____ DATE _____ COUNTY WILLIAMS

R.C. _____ WEATHER _____ TOWNSHIP NORTHWEST

_____ TEMP. _____ SECTION 22

_____ T 9 S R 4 W W

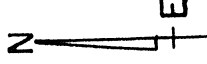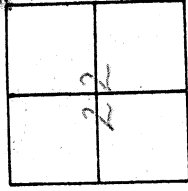

TYPE MONUMENT _____

ON SURFACE - BELOW _____

LEFT- & PAW'T - RIGHT _____

TO _____ EDGE PAVEMENT _____

S.L.M. _____

SET SMALL RR. SPK.

9-2-86

#49

E Co. Rd. "R"

O.D.O.T. DISTRICT 2 SURVEY OFFICE

PERSONNEL _____ REFERENCE NO. 44 SHEET _____ OF _____

NOTES _____ ROUTE S.R. #49

H.C. _____ DATE _____ COUNTY WILLIAMS

R.C. _____ WEATHER _____ TOWNSHIP NORTHWEST

_____ TEMP. _____ SECTION 15

_____ T 9 S 5 R 4 W 1


TYPE MONUMENT _____

ON SURFACE - BELOW _____

LEFT - & PAW'T. - RIGHT _____

TO _____ EDGE PAVEMENT _____

S.L.M. _____

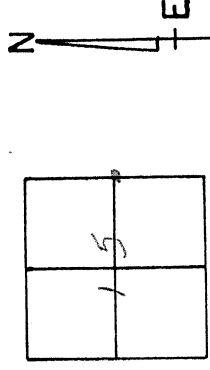

SET SMALL RR. SPE.
9-2-86

#44

O.D.O.T. DISTRICT 2 SURVEY OFFICE

PERSONNEL _____

REFERENCE NO. 45

SHEET OF

NOTES _____

H.C. _____

R.C. _____

DATE _____

WEATHER _____

TEMP. _____

ROUTE S.R. # 49

COUNTY WILLIAMS

TOWNSHIP NORTHWEST

SECTION 15

T 9 S 4 R 4 W


TYPE MONUMENT _____

ON SURFACE - BELOW _____

LEFT - & PAW'T. - RIGHT _____

TO _____ EDGE PAVEMENT

S.L.M. _____

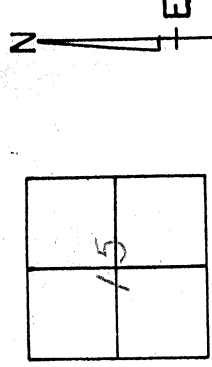

SET SMALL R.R. SPR. 9-2-86

#49

& C&RD. "5"

O.D.O.T. DISTRICT 2 SURVEY OFFICE

PERSONNEL _____ REFERENCE NO. 38 SHEET 1 OF _____



NOTES 1. Stone ROUTE SR # 49
H.C. D. Cortis COUNTY W. Illinois
R.C. P. Michaelak TOWNSHIP Northwest
J. Hoeschele SECTION 34
T _____ R _____

TYPE MONUMENT Small Spk.
ON SURFACE - BELOW 2" deep
LEFT- ϕ PAW'T. - RIGHT _____
TO _____ EDGE PAVEMENT

S.L.M. 882 + 11

Set small spike
7-2-86 JH

882+13
9-20-95

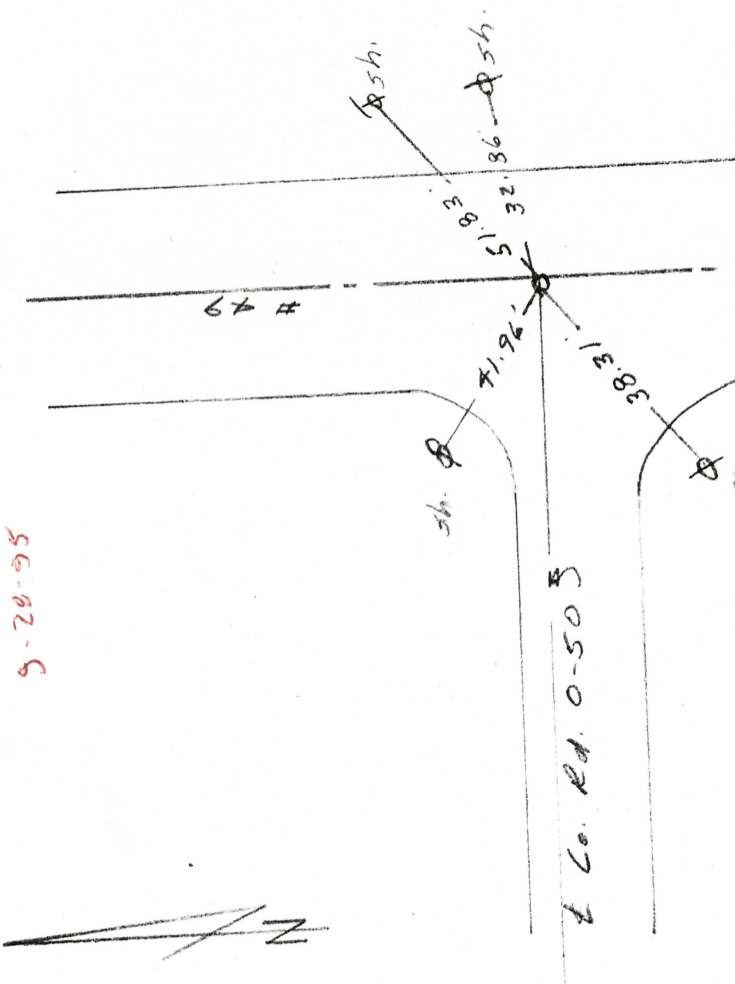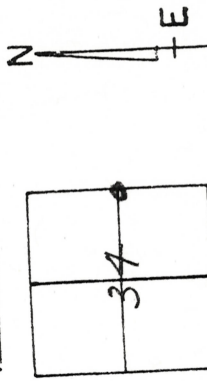


O.D.O.T. DISTRICT 2 SURVEY OFFICE

PERSONNEL _____ REFERENCE NO. 39 SHEET 2 OF _____


NOTES 1. Stone ROUTE SR #49
H.C. D. Curtis COUNTY Williams
R.C. R. Michalak TOWNSHIP Northwest
J. Hesseholder SECTION 34
T _____ R _____

TYPE MONUMENT Small PK Spike
ON SURFACE - BELOW 2" deep
LEFT - & PAW'T. - RIGHT _____
TO _____ EDGE PAVEMENT _____
S.L.M. 908459

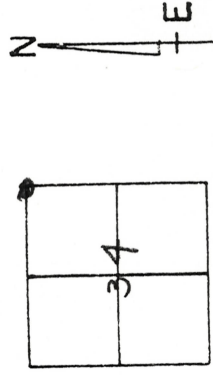

Set Small Spike
9-2-86
JAH


900 + 60

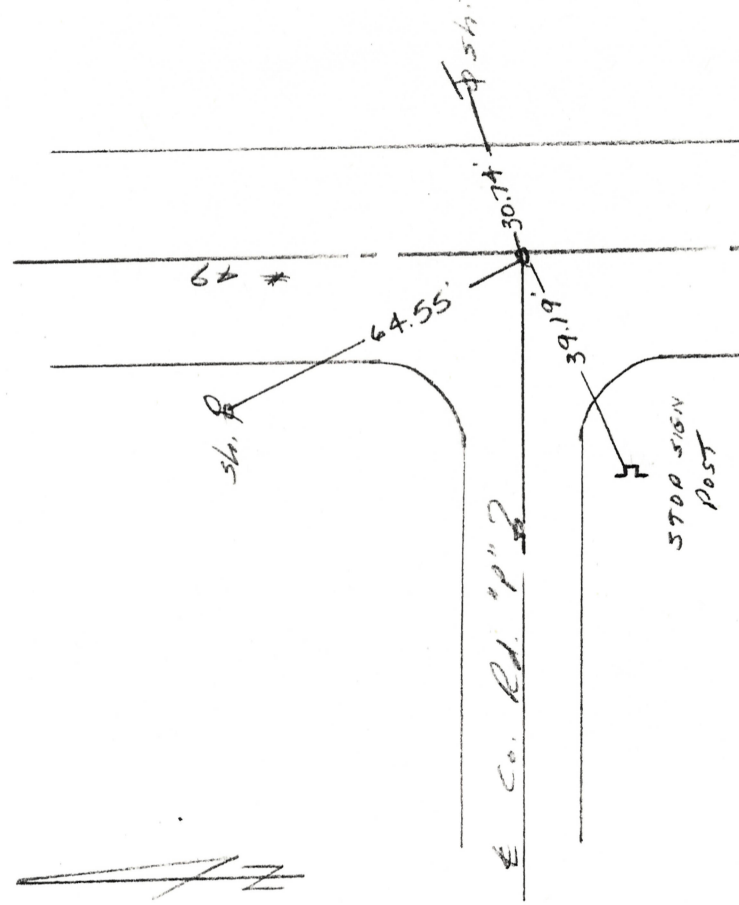

O.D.O.T. DISTRICT 2 SURVEY OFFICE


PERSONNEL _____ REFERENCE NO. 70 SHEET 3 OF _____

NOTES L. Stearns ROUTE SR # 49
H.C. D. Curtis COUNTY Williams
R.C. R. Michaelok TOWNSHIP Northwest
J. Hoescholder SECTION 27
T _____ R _____

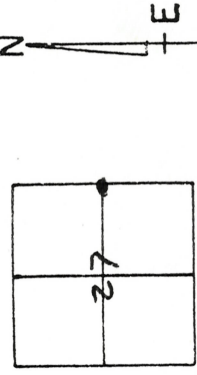

TYPE MONUMENT Small Spk.
ON SURFACE - BELOW 2" deep
LEFT- & PAW'T. - RIGHT _____
TO _____ EDGE PAVEMENT _____
S.L.M. 935+10

Fd. Small Spike
4" deep
7-2-86 gth

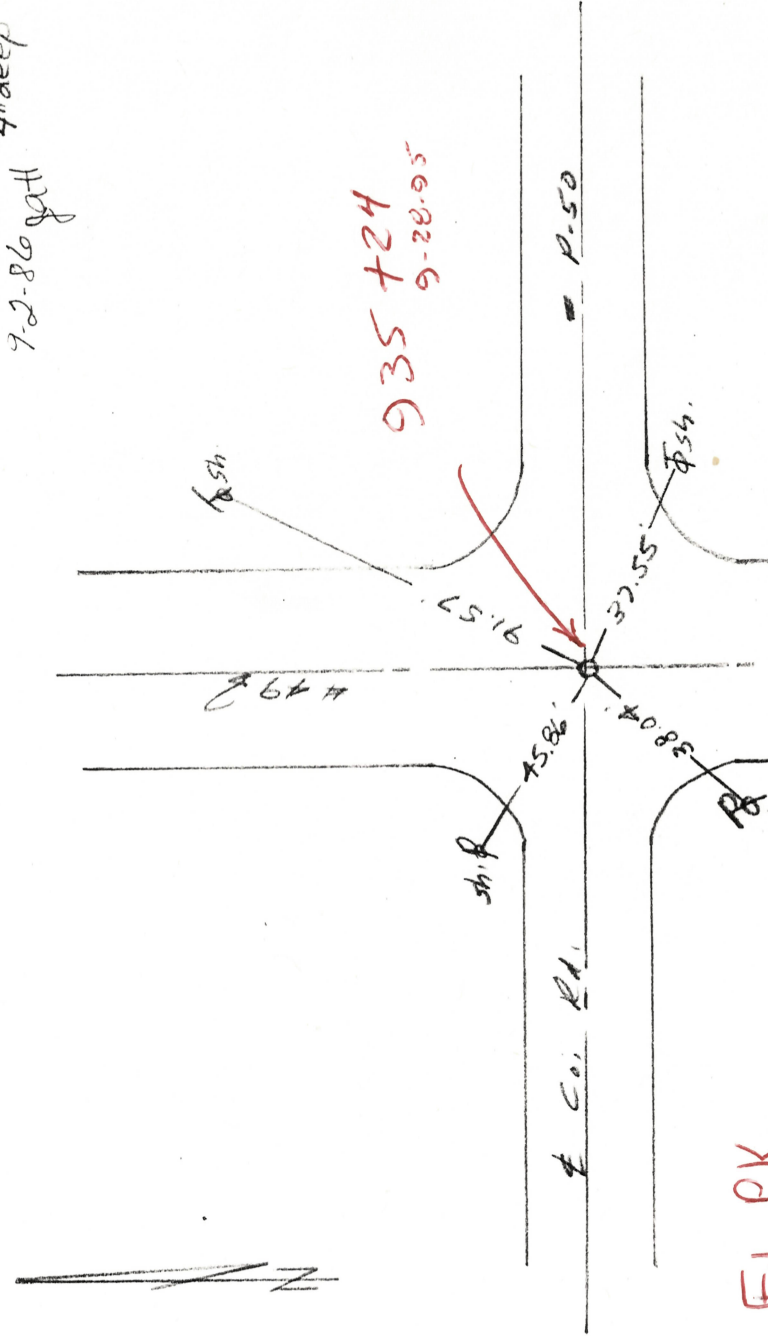

E. PK

O.D.O.T. DISTRICT 2 SURVEY OFFICE

PERSONNEL

REFERENCE NO. 40-A

SHEET 4 OF

NOTES

H.C. D. Curtis

R.C. R. Michalak

J. Houscholder

L. Stone

DATE 8 April 86

WEATHER cool

TEMP. 50°

ROUTE SR#49

COUNTY Williams

TOWNSHIP Northwest

SECTION 27

T R


TYPE MONUMENT Small RR. Spks

ON SURFACE - BELOW 2" deep

LEFT- ϕ PAW'T. - RIGHT


TO EDGE PAVEMENT

S.L.M. 978+35, 978+39

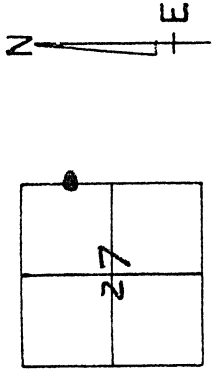

Set Sm. R.R. Spks.

9-2-86
jath

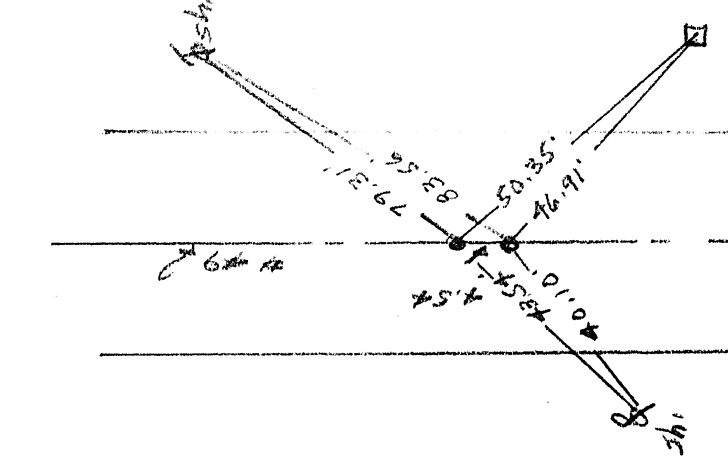


O.D.O.T. DISTRICT 2 SURVEY OFFICE

PERSONNEL _____ REFERENCE NO. 41 SHEET 5 OF _____

NOTES 1.54 auc DATE 8 April 86 ROUTE SR# 49
H.C. D. Curtis WEATHER Coal COUNTY Williams
R.C. R. Michalak TEMP. 50° TOWNSHIP Northwest
J. Housholder SECTION 22


T _____ R _____

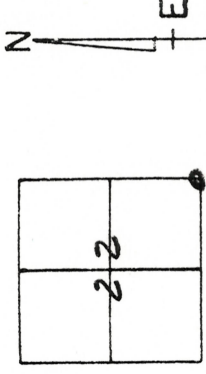

TYPE MONUMENT Small RR Spk.
ON SURFACE - BELOW 2" deep
LEFT - & PAV'T. - RIGHT _____
TO _____ EDGE PAVEMENT _____
S.L.M. 961 + 60

Fd. Sm. R.R. Spk. 4" deep
9-2-86 JAH

961 + 65
9-28-95

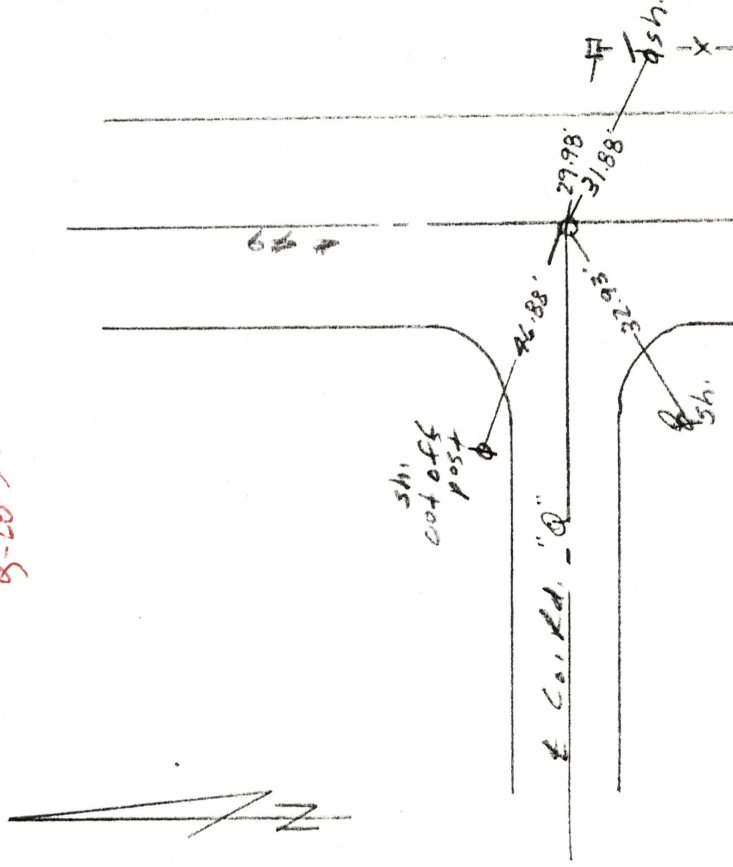

O.D.O.I. DISTRICT 2 SURVEY OFFICE

PERSONNEL

REFERENCE NO. 42 SHEET 6 OF

NOTES 1. Stone

H.C. D. Curtis

R.C. R. Michaelak

J. Householder

DATE 8 April 86

WEATHER Coal

TEMP. 51°

ROUTE SR #49

COUNTY Wilkes

TOWNSHIP Norham

SECTION 22

T R


TYPE MONUMENT Loc. RR Spk.

ON SURFACE - BELOW 2" deep

LEFT- & PAW'T. - RIGHT


TO EDGE PAVEMENT

S.L.M. 988 + 08

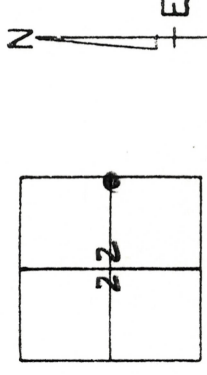

Set Sm RR Spk
9-2-86 JAH

988 + 447
9-28-95

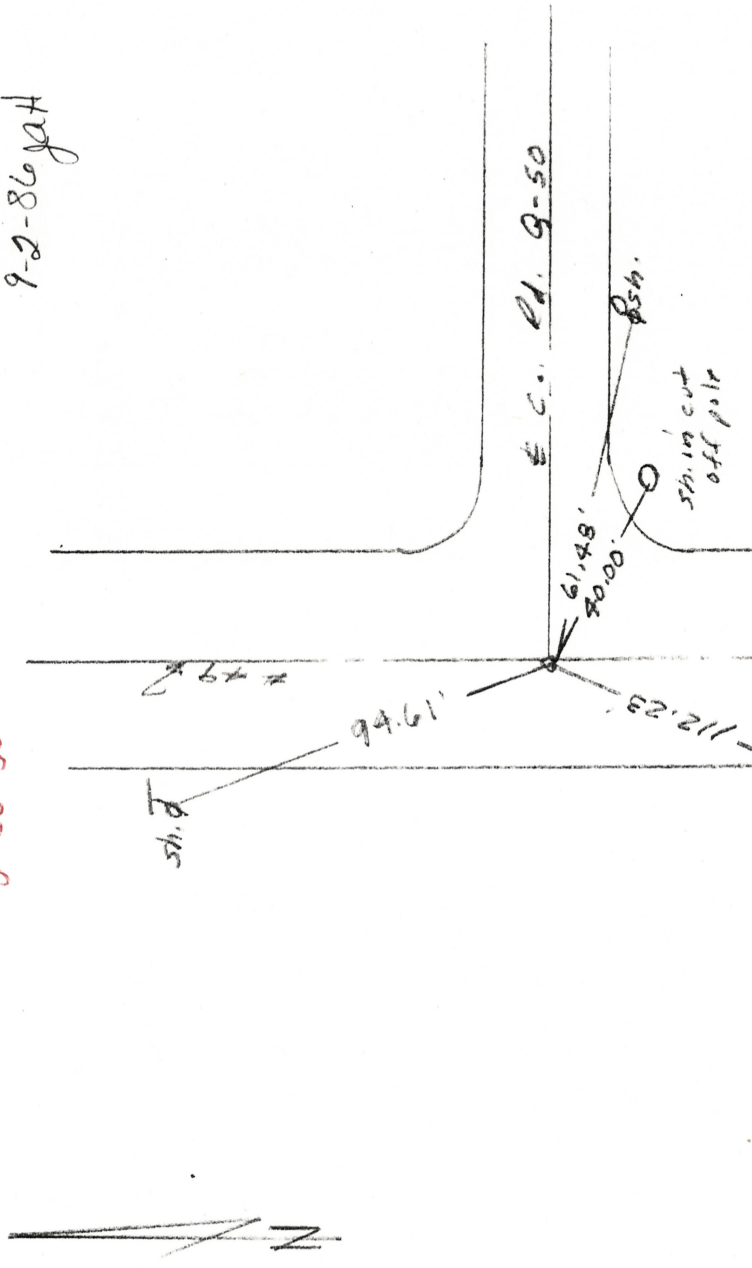

O.D.O.T. DISTRICT 2 SURVEY OFFICE

PERSONNEL

REFERENCE NO. 43

SHEET 7 OF 10

NOTES 1. StateNOTES 1. State

H.C. Dr. Courtis

R.C. R. Michael

J. Householder

DATE 8 April 86

WEATHER cool

TEMP. 51°

ROUTE SR #49

COUNTY Williams

TOWNSHIP Northwest

SECTION 22

18


TYPE MONUMENT Small PK Spk.

ON SURFACE - BELOW 2" deep

LEFT - & PAV'T. - RIGHT

TO EDGE PAVEMENT

SI M 1014 + 64

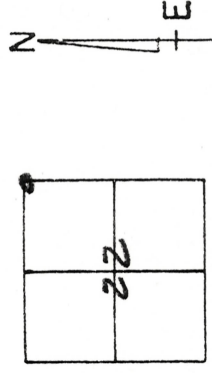


Set Sm. R. R. Spk.

92-86
Hb

10/5/08

56-82-5

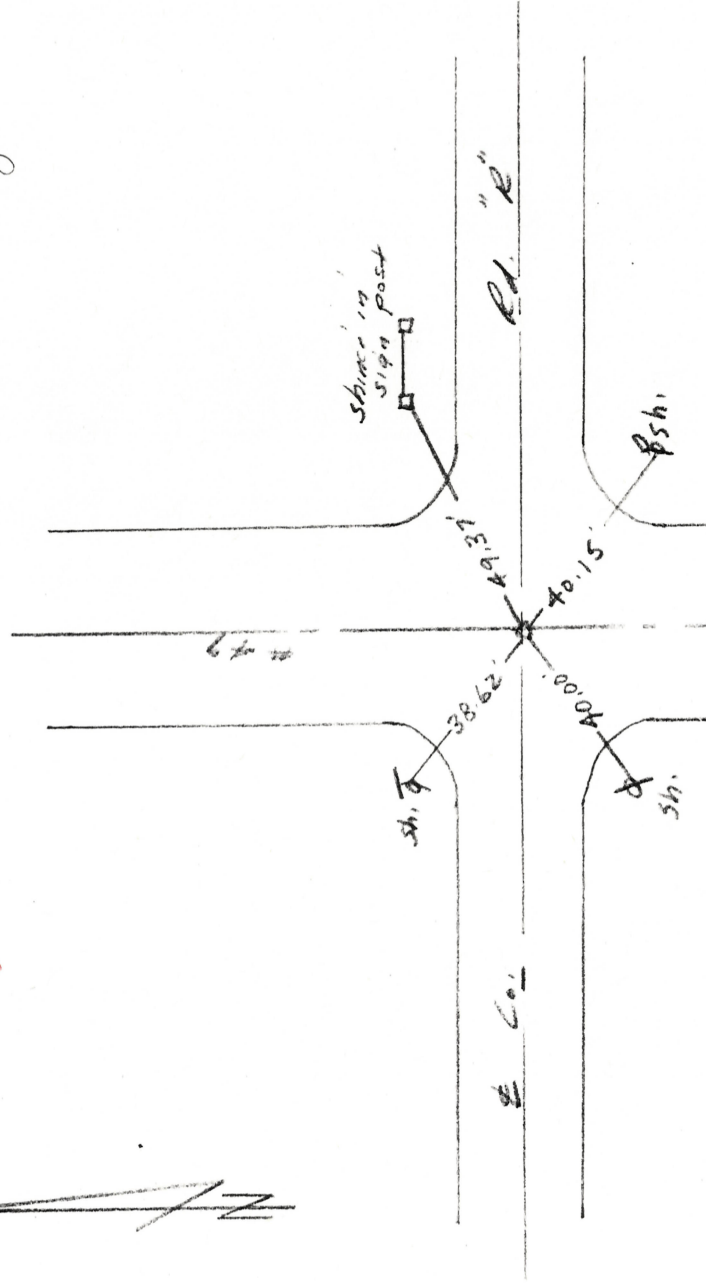

O.D.O.T. DISTRICT 2 SURVEY OFFICE

PERSONNEL _____ REFERENCE NO. 44 SHEET 8 OF _____


NOTES 1. Stone ROUTE SR #49

H.C. D. Curtis DATE 8 April 86 COUNTY Williams

R.C. R. Michalak WEATHER Cool TOWNSHIP Northwest

J. Henschel TEMP. 520 SECTION 15

T _____ R _____

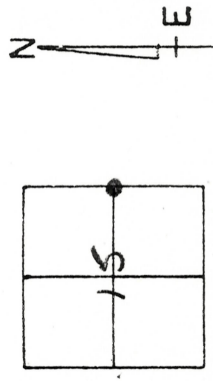

TYPE MONUMENT Small RR Spk.

ON SURFACE - BELOW 2" deep


LEFT- & PAV'T. - RIGHT _____

TO _____ EDGE PAVEMENT _____

S.L.M. 1041 + 15

Set Sm. R.R. Spk.
9-2-86 yalt

1041+68
90-2-95

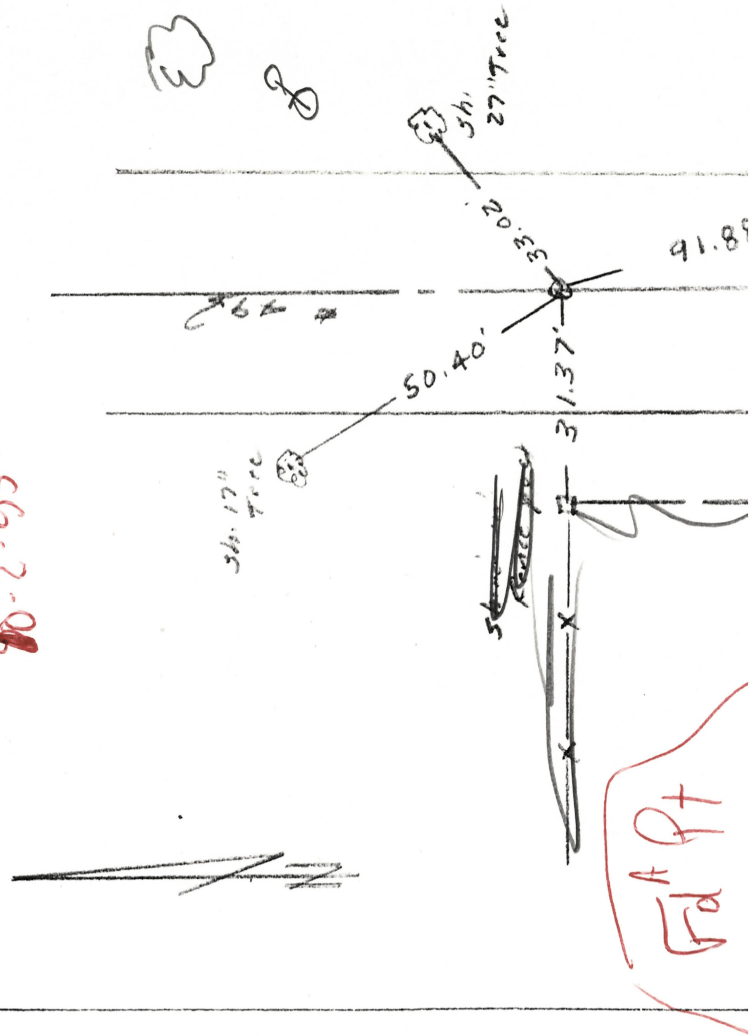

O.D.O.T. DISTRICT 2 SURVEY OFFICE

PERSONNEL _____ REFERENCE NO. 45 SHEET 9 OF _____

NOTES L. Stone DATE 8 April 86 ROUTE SR #49

H.C. D. Curtis WEATHER cool COUNTY Williams

R.C. R. Michaelak TEMP. 51° TOWNSHIP Northwest

J. Hooschelder SECTION 15

T _____ R _____


TYPE MONUMENT Small RR Spt.

ON SURFACE - BELOW 2" deep

LEFT- & PAV'T. - RIGHT _____

TO _____ EDGE PAVEMENT _____

S.L.M. 1067 + 67

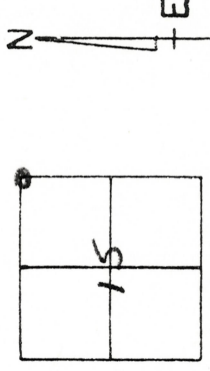

Set Sm R.R. Spt.
9-2-86 JAH

0608 + 29

