


# AS-BUILT SURVEY

BEING PART OF STATE ROUTE 2,  
IN PORTAGE TOWNSHIP, OTTAWA COUNTY, OHIO  
PREPARED FOR VERNON NAGEL, INC. AND AT THE  
REQUEST OF MR. JASON RICKEY



## GRAPHIC SCALE

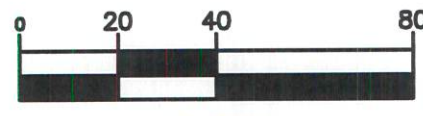

( IN FEET )


1 inch = 40 ft.

## LEGEND

- EC EDGE OF CONCRETE
- EJ EDGE OF JOINT
- EP EDGE OF PAVEMENT

## NOTE:

ELEVATIONS WERE OBSERVED  
ON 12/04/2023

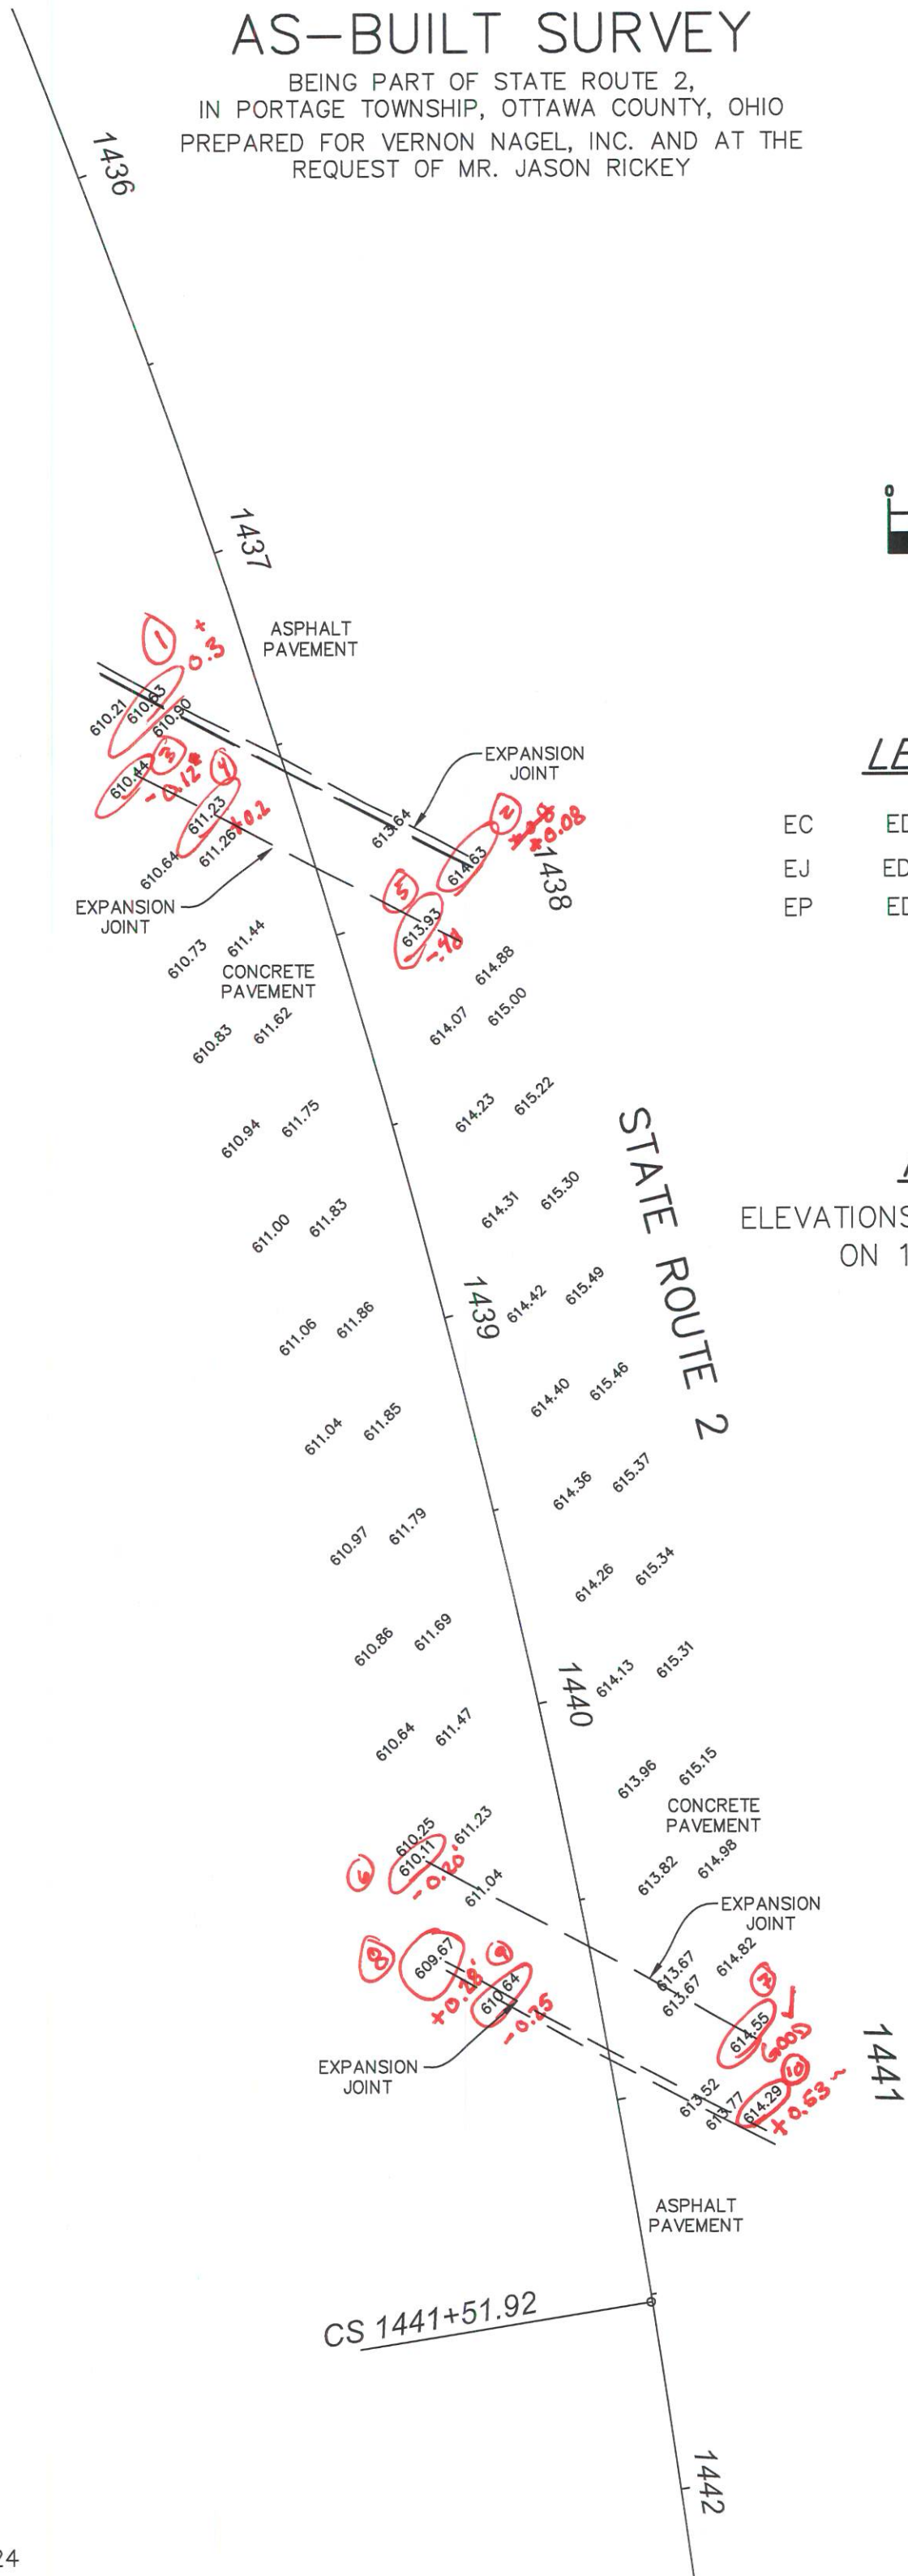

CS 1441+51.92




1720 Indian Wood Circle  
Suite E  
Maumee, OH 43537  
Phone: (419) 877-0400  
Fax: (419) 877-1140

# AS-BUILT SURVEY

BEING PART OF STATE ROUTE 2,  
IN PORTAGE TOWNSHIP, OTTAWA COUNTY, OHIO  
PREPARED FOR VERNON NAGEL, INC. AND AT THE  
REQUEST OF MR. JASON RICKEY



## GRAPHIC SCALE

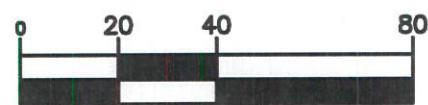

( IN FEET )


1 inch = 40 ft.

## LEGEND

- EC EDGE OF CONCRETE
- EJ EDGE OF JOINT
- EP EDGE OF PAVEMENT

## NOTE:

ELEVATIONS WERE OBSERVED  
ON 09/24/2024

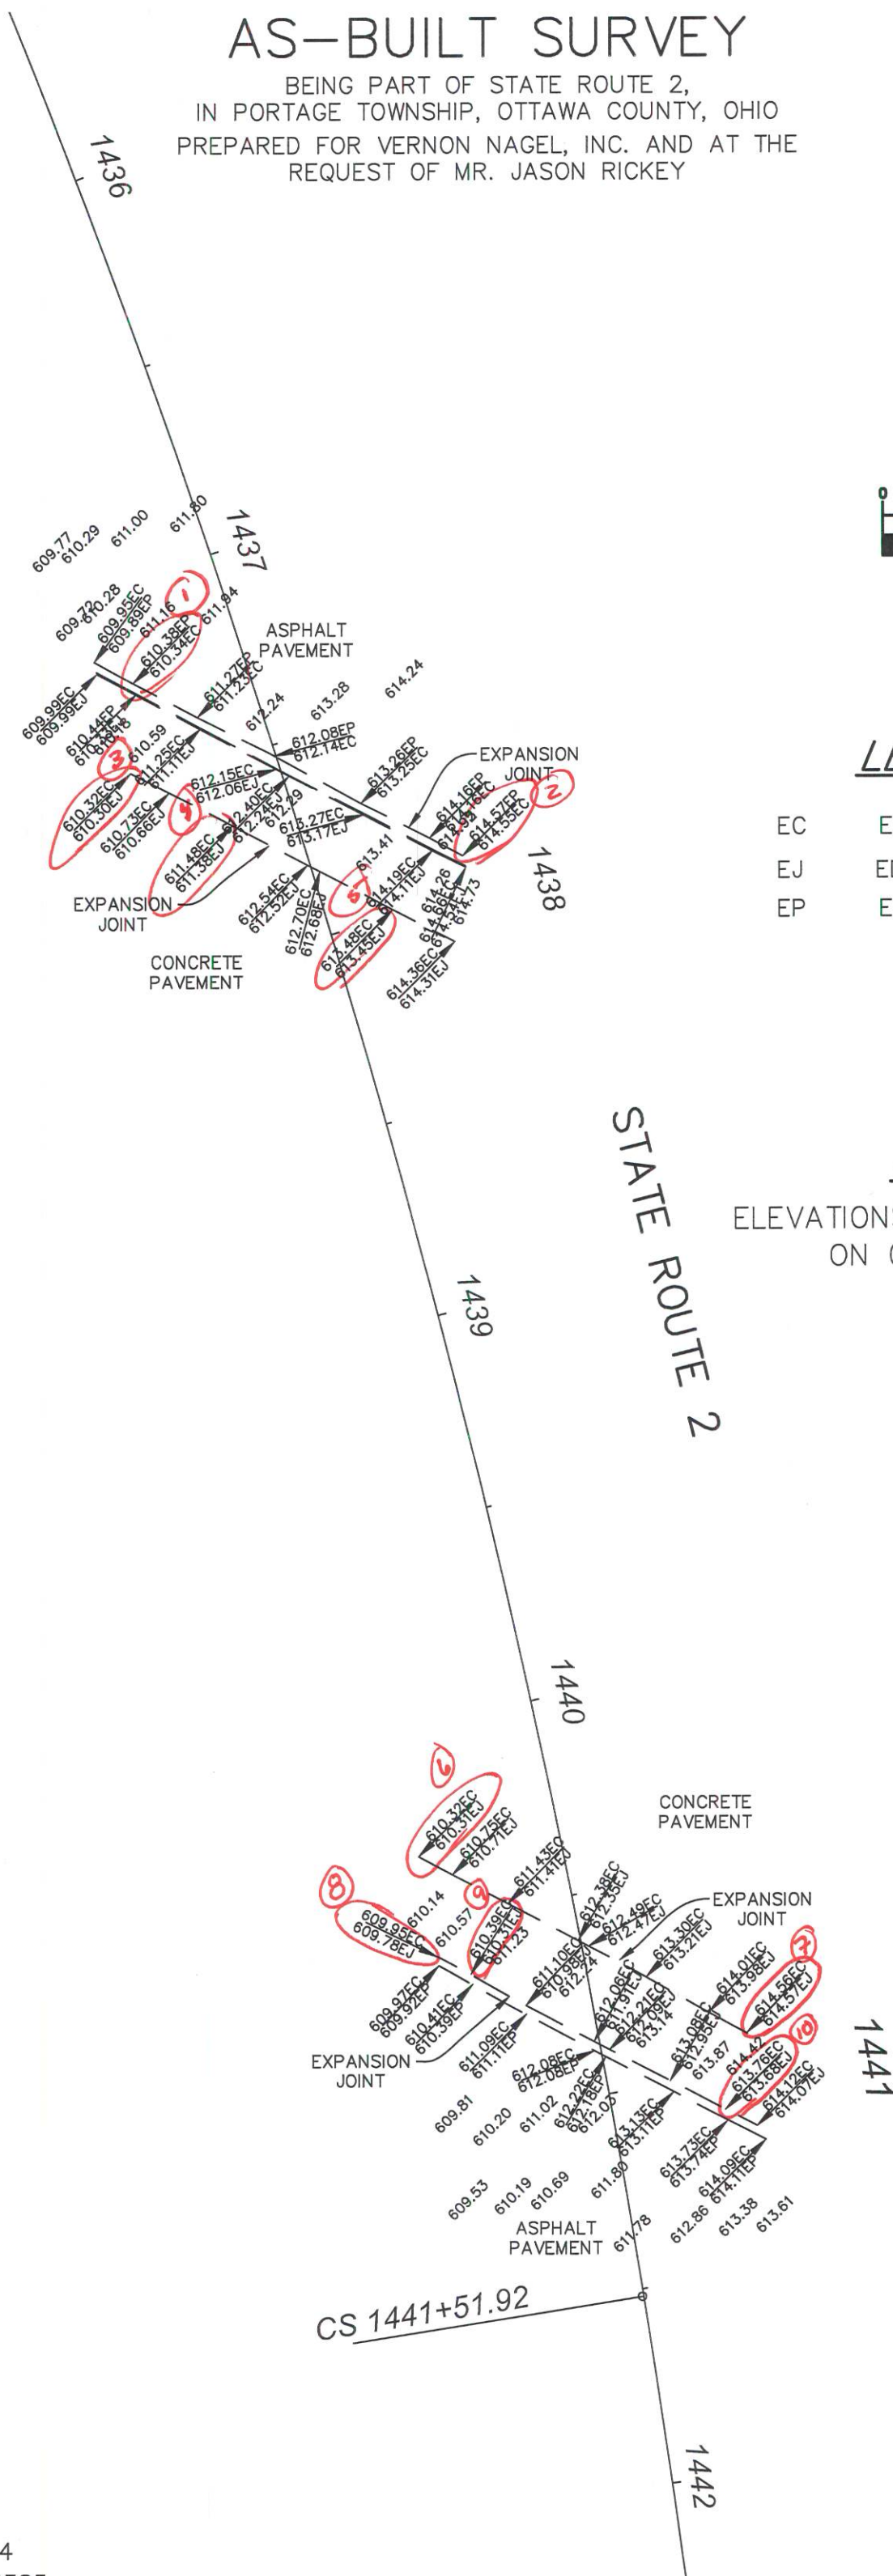

1720 Indian Wood Circle  
Suite E  
Maumee, OH 43537  
Phone: (419) 877-0400  
Fax: (419) 877-1140