


O.D.O.T. DISTRICT 2 SURVEY OFFICE (USE ONLY)

PERSONNEL _____ REFERENCE NO. 1 SHEET 1 OF 17
NOTES ROUSOS DATE 5/19/2009 ROUTE SR 49
H.C. HOMAN WEATHER SUNNY COUNTY WILLIAMS
R.C. ROUSOS TEMP. 75° TOWNSHIP ST. JOSEPH
SECTION 34
T 6 N R 1 E

TYPE MONUMENT PK NAIL
ON SURFACE - ~~BELOW~~ ON _____
LEFT - ☉ PAV'T - ~~RIGHT~~ 6.6'
3.2' TO LT EDGE PAVEMENT
S.L.M. 1+72

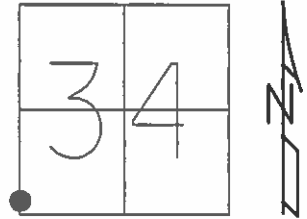

GRID: NORTHING: 649149.161 EASTING: 1351808.181

RECORD:
SET PK/WASHER
9/14/92, MB

