

O.D.O.T. DISTRICT 2 SURVEY OFFICE (USE ONLY)

PERSONNEL

REFERENCE NO. 2

SHEET 3 OF 37

NOTES RHOADES  
 H.C. RHOADES  
 R.C. WHITAKER

DATE 7/28/22  
 WEATHER SUNNY  
 TEMP. 76°

ROUTE SR 49  
 COUNTY WILLIAMS  
 TOWNSHIP ST JOSEPH  
 SECTION 34  
 T 6 N R 1 E

DWG BY RHOADES PID PAVETRAIN

TYPE MONUMENT MAG/WASHER

ON SURFACE - ~~BELOW~~ ON

OFFSET  $\phi$  PAVEMENT 0.4' ~~LT~~ : RT

11.1' TO LT EDGE PAVEMENT


STATION: 28+19

HORZ.DATUM: NAD83 2011


GEOID: NAVD88 2018

GRID: NORTHING: 651787.857

EASTING: 1351939.790

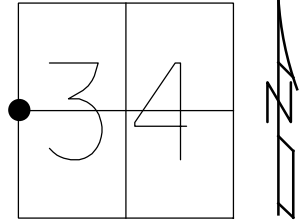


RECORD: P.I.  
 STA. 28+09.3  
 $\Delta = 0^\circ 09'$  LT REC  
 $\Delta = 0^\circ 08' 40''$  LT MEAS.  
 FD 1" IPIPE  
 1" DOWN  
 7/21/82, STONE  
 SET P.K./WASHER  
 9/14/92, MB  
 FD SM.R.R.SPIKE  
 5/19/09, DCH  
 SET MAG/WASHER  
 8/4/09, DCH  
 FD MAG/WASHER  
 REF2  
 7/28/22,  
 3/8/23, JMR

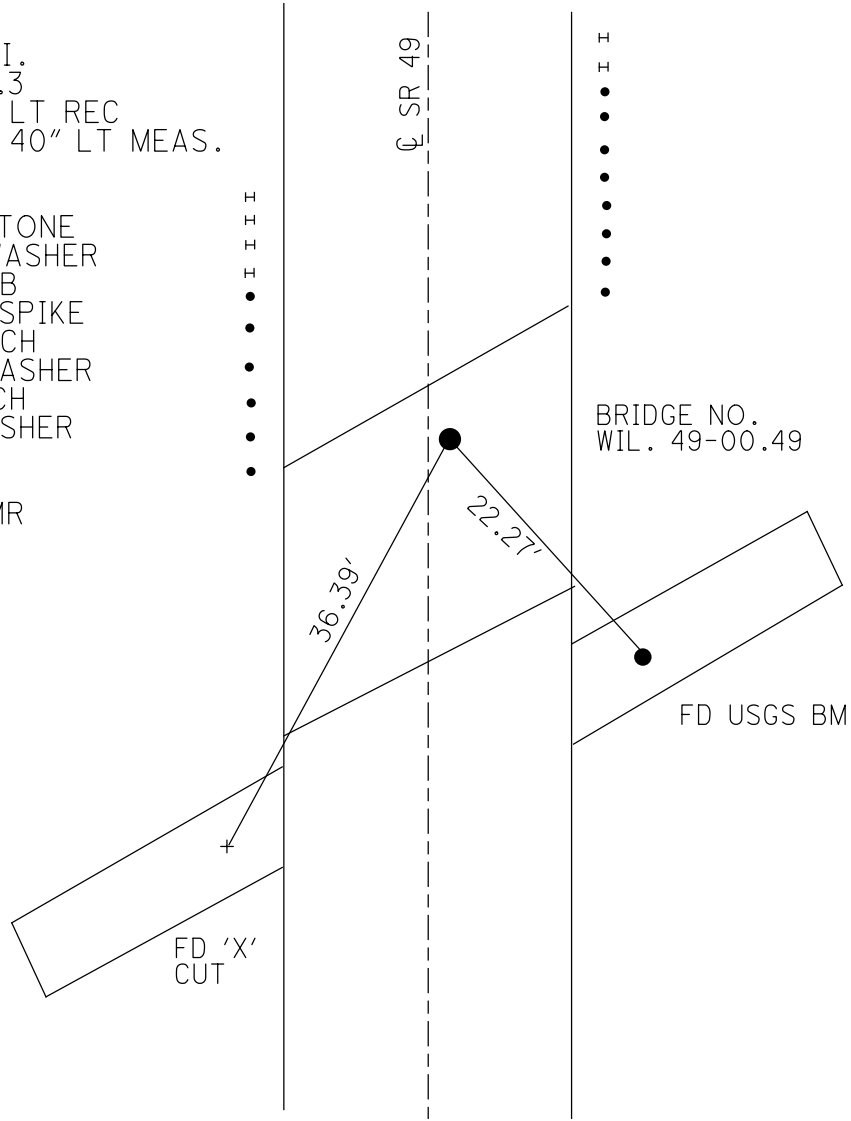

O.D.O.T. DISTRICT 2 SURVEY OFFICE (USE ONLY)

PERSONNEL \_\_\_\_\_ REFERENCE NO. 2 SHEET 3 OF 17  
 NOTES ROUSOS DATE 5/19/2009 ROUTE SR 49  
 H.C. HOMAN WEATHER SUNNY COUNTY WILLIAMS  
 R.C. ROUSOS TEMP. 75° TOWNSHIP ST. JOSEPH  
 \_\_\_\_\_ SECTION 34  
 \_\_\_\_\_ T 6 N R 1 E

TYPE MONUMENT SM. RR SPIKE  
 ON SURFACE - ~~BELOW~~ ON  
~~LEFT~~ - CL PAV'T - RIGHT 1.0'  
11.1 TO LT EDGE PAVEMENT  
 S.L.M. 28.19

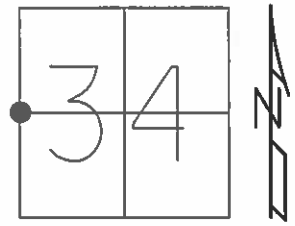

GRID: NORTHING: 651787.877 EASTING: 1351939.756

RECORD: P.I.  
 STA. 28+09.3  
 $\Delta = 0^\circ 09' \text{ LT REC}$   
 $\Delta = 0^\circ 08' 40'' \text{ LT MEAS.}$   
 FD 1" IPIPE  
 1" DEEP  
 7/21/82, STONE  
 SET P.K./WASHER  
 9/14/92, MB  
 SET MAG/WASHER  
 8/4/09, DH

