


O.D.O.T. DISTRICT 2 SURVEY OFFICE (USE ONLY)

PERSONNEL _____ REFERENCE NO. 4 SHEET 11 OF 37
 NOTES TRENKA DATE 7/16/18 ROUTE SR 49
 H.C. LEU WEATHER CLOUDY COUNTY WILLIAMS
 R.C. HAGEMEYER TEMP. 75° TOWNSHIP ST. JOSEPH
 _____ SECTION 27
 _____ T 6 N R 1 E


TYPE MONUMENT MAG NAIL
 ON SURFACE - ~~BELOW~~ ON
~~LEFT~~ - CL PAV'T - RIGHT 0.9', 8' N OF CL E
- TO - EDGE PAVEMENT
 S.L.M. 80+46

GRID: NORTHING: 656967.293 EASTING: 1352370.918

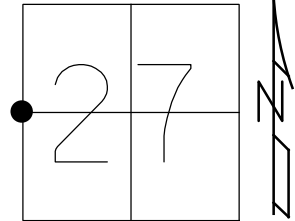

RECORD:
 FD IPIN
 4" DOWN
 5/3/00, MB
 SET P.K./WASHER
 8/1/00, MRC
 FD 3/4" IPIN
 6" DOWN
 5/20/09, DCH
 SET MAG/WASHER
 REF4
 2/22/17, DCH
 SET MAG/WASHER
 9/20/19, JLL

NOTE:
 US 6 = REF4

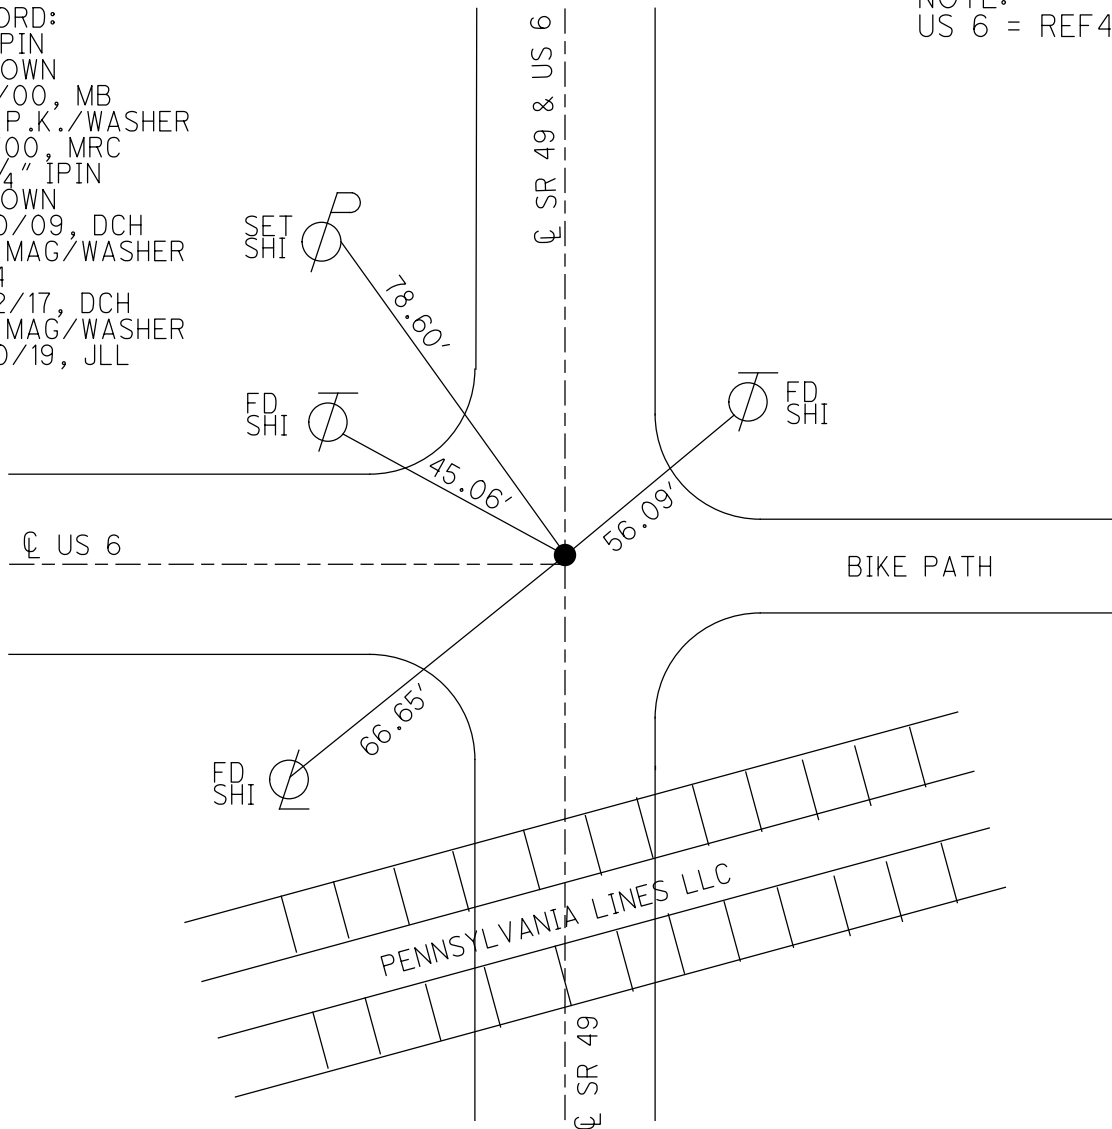


O.D.O.T. DISTRICT 2 SURVEY OFFICE (USE ONLY)

PERSONNEL _____ REFERENCE NO. 4 SHEET 11 OF 17
 NOTES ROUSOS DATE 5/20/09 ROUTE SR 49
 H.C. HOMAN WEATHER CLOUDY COUNTY WILLIAMS
 R.C. ROUSOS TEMP. 64° TOWNSHIP ST. JOSEPH
 _____ SECTION 27
 _____ T 6 N R 1 E

TYPE MONUMENT 3/4" IPIN
~~ON SURFACE~~ - BELOW 6"
 LEFT - ☉ PAV'T - RIGHT ON, 8' N OF ☉ E
- TO - EDGE PAVEMENT
 S.L.M. 80+46

GRID: NORTHING: 656918.952 EASTING: 1352271.229

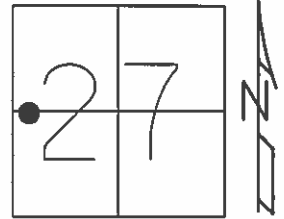

RECORD:
 FD 3/4" IPIN
 1992, 2012

