


O.D.O.T. DISTRICT 2 SURVEY OFFICE (USE ONLY)


PERSONNEL _____ REFERENCE NO. 4 A SHEET 11 OF 17
NOTES TRENKA DATE 7/16/18 ROUTE SR 49
H.C. LEU WEATHER CLOUDY COUNTY WILLIAMS
R.C. HAGEMEYER TEMP. 75° TOWNSHIP ST. JOSEPH
SECTION 27
T 6 N R 1 E

TYPE MONUMENT SQUARE BOLT
~~ON SURFACE~~ - BELOW 2"
LEFT - ☉ PAV'T - ~~RIGHT~~ ON _____
- TO - EDGE PAVEMENT
S.L.M. 83+36
GRID: NORTHING: 657257.313 EASTING: 1352376.426

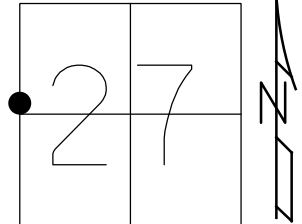

RECORD:
FD IPIPE
4" DOWN
5/3/00, MB
SET P.K./WASHER
8/1/00, MRC
FD SQUARE BOLT
2" DOWN
5/20/19, DCH
REFA4
2/22/17, DCH
SET MAG/WASHER
9/20/19, JLL


NOTE:
US 6 = REFA4

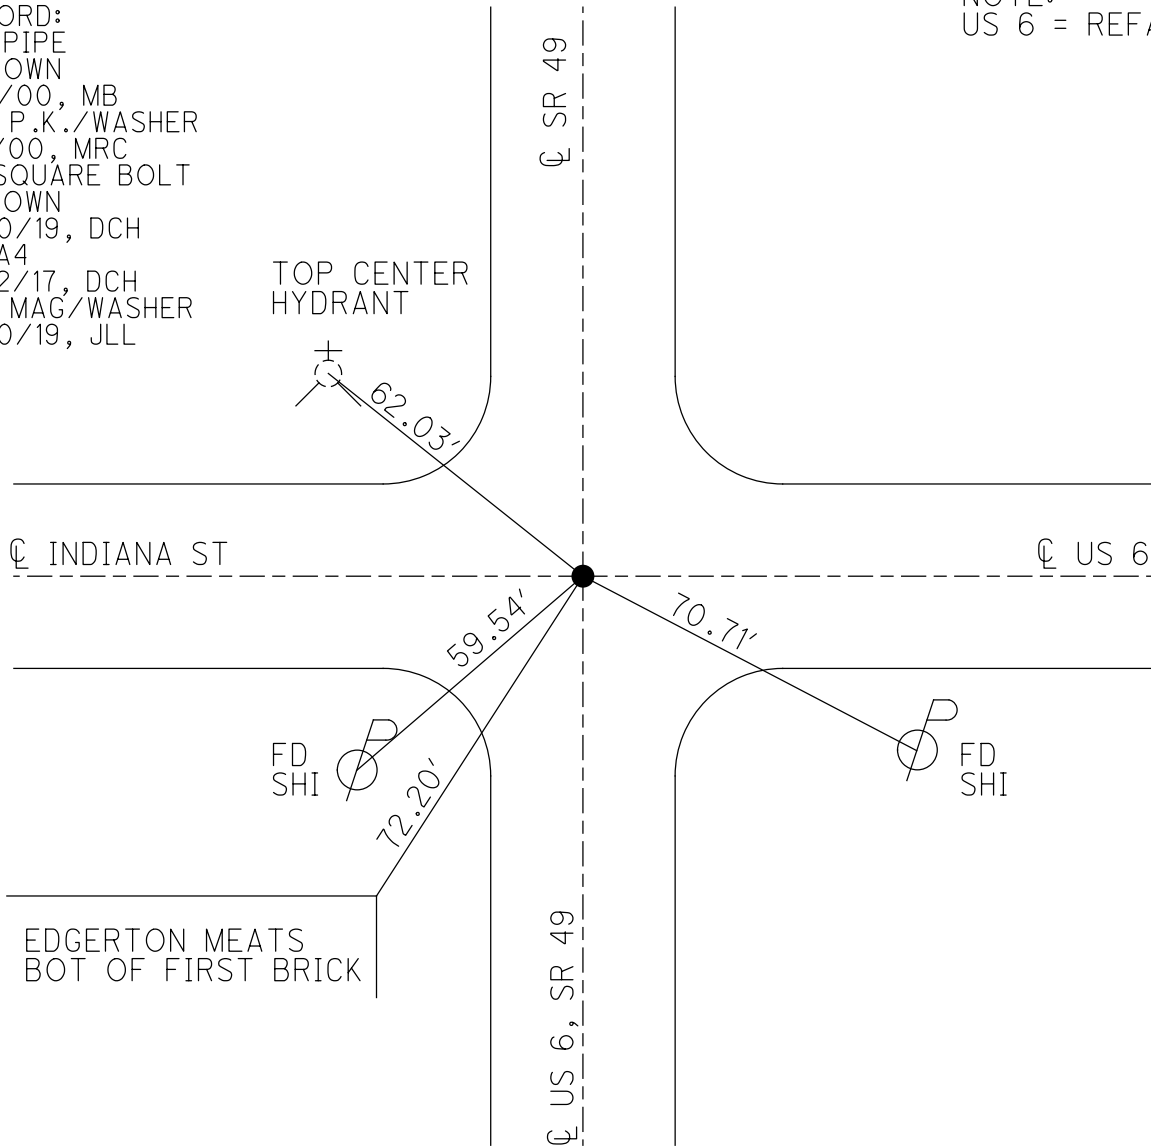

O.D.O.T. DISTRICT 2 SURVEY OFFICE (USE ONLY)

PERSONNEL _____ REFERENCE NO. 4 A SHEET 12 OF 17
 NOTES ROUSOS DATE 5/20/09 ROUTE SR 49
 H.C. HOMAN WEATHER CLOUDY COUNTY WILLIAMS
 R.C. ROUSOS TEMP. 64° TOWNSHIP ST. JOSEPH
 _____ SECTION 27
 _____ T 6 N R 1 E

TYPE MONUMENT SQUARE BOLT
~~ON SURFACE~~ - BELOW 2"
 LEFT - ☉ PAV'T - RIGHT ON
- TO - EDGE PAVEMENT
 S.L.M. 83+36

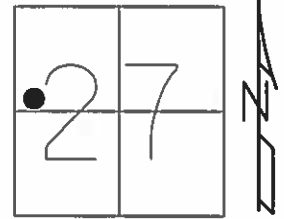

GRID: NORTHING: 657208.982 EASTING: 1352276.866

RECORD:
 FD SQ. BOLT
 1992, 2012

