
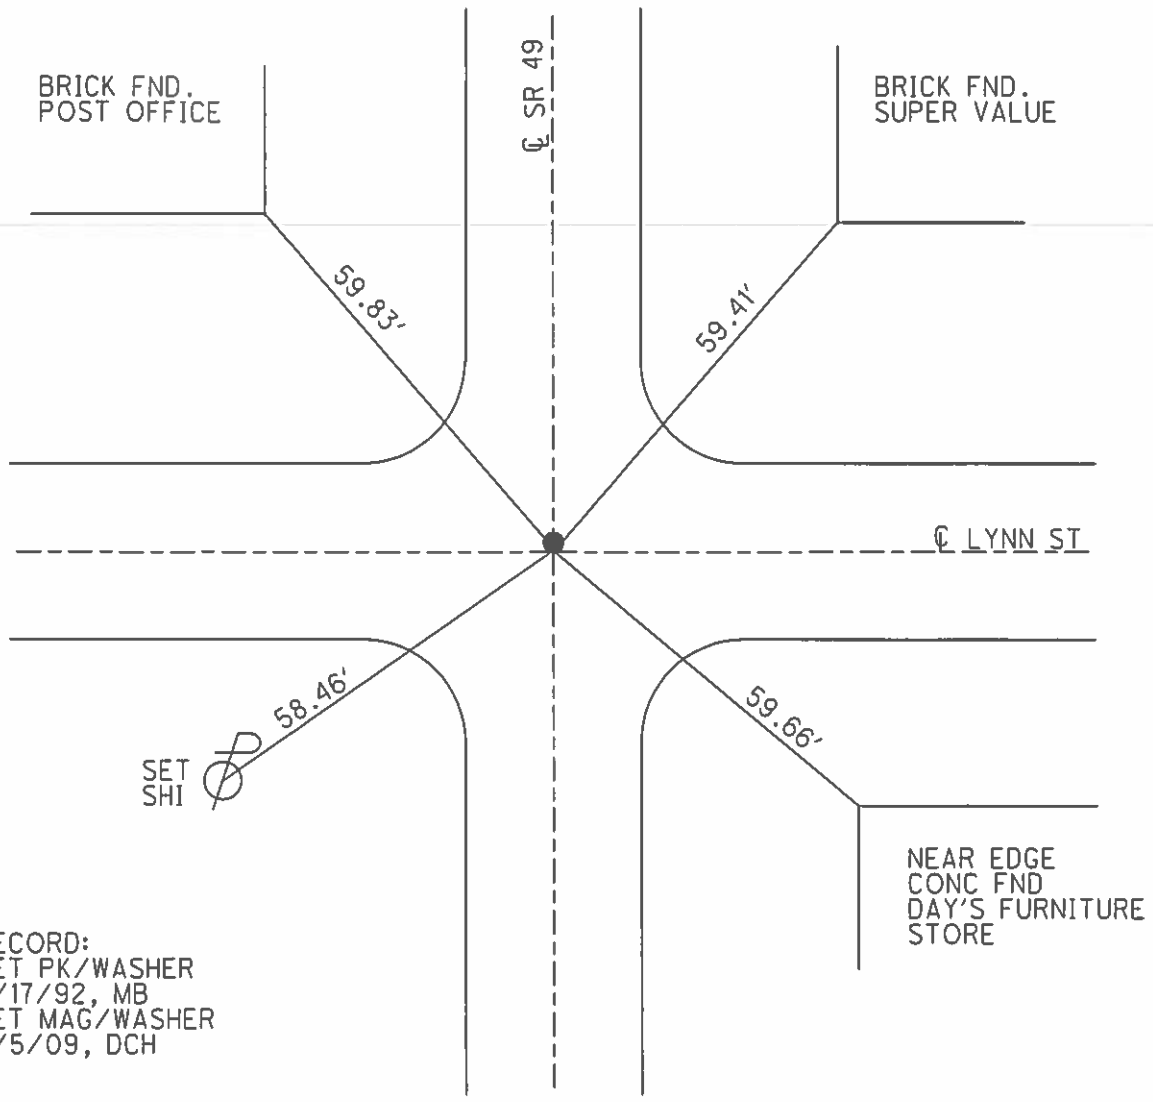


O.D.O.T. DISTRICT 2 SURVEY OFFICE (USE ONLY)

PERSONNEL _____ REFERENCE NO. 4 B SHEET 13 OF 17
 NOTES ROUSOS DATE 5/20/09 ROUTE SR 49
 H.C. HOMAN WEATHER CLOUDY COUNTY WILLIAMS
 R.C. ROUSOS TEMP. 64° TOWNSHIP ST. JOSEPH
 _____ SECTION 27
 _____ T 6 N R 1 E

TYPE MONUMENT P.K.NAIL
 ON SURFACE - ~~BELOW~~ ON _____
 LEFT - ☉ PAV'T - RIGHT ON, 2' N OF ☉ E&W
- TO - EDGE PAVEMENT
 S.L.M. 87+27
 GRID: NORTHING: 657602.510 EASTING: 1352284.610

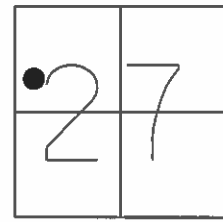

RECORD:
 SET PK/WASHER
 9/17/92, MB
 SET MAG/WASHER
 8/5/09, DCH