


O.D.O.T. DISTRICT 2 SURVEY OFFICE (USE ONLY)


PERSONNEL \_\_\_\_\_ REFERENCE NO. 4 C SHEET 14 OF 17  
 NOTES ROUSOS DATE 5/20/09 ROUTE SR 49  
 H.C. HOMAN WEATHER CLOUDY COUNTY WILLIAMS  
 R.C. ROUSOS TEMP. 64° TOWNSHIP ST. JOSEPH  
 \_\_\_\_\_ SECTION 27  
 \_\_\_\_\_ T 6 N R 1 E

TYPE MONUMENT P.K.NAIL  
 ON SURFACE - ~~BELOW~~ 2"  
 LEFT - ☉ PAV'T - RIGHT ON  
- TO - EDGE PAVEMENT  
 S.L.M. 91+14

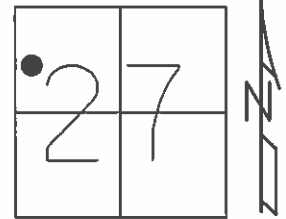

GRID: NORTHING: 657988.745 EASTING: 1352292.648

RECORD:  
 SET PK/WASHER  
 9/16/92, MB  
 SET MAG/WASHER  
 5/20/09, DCH

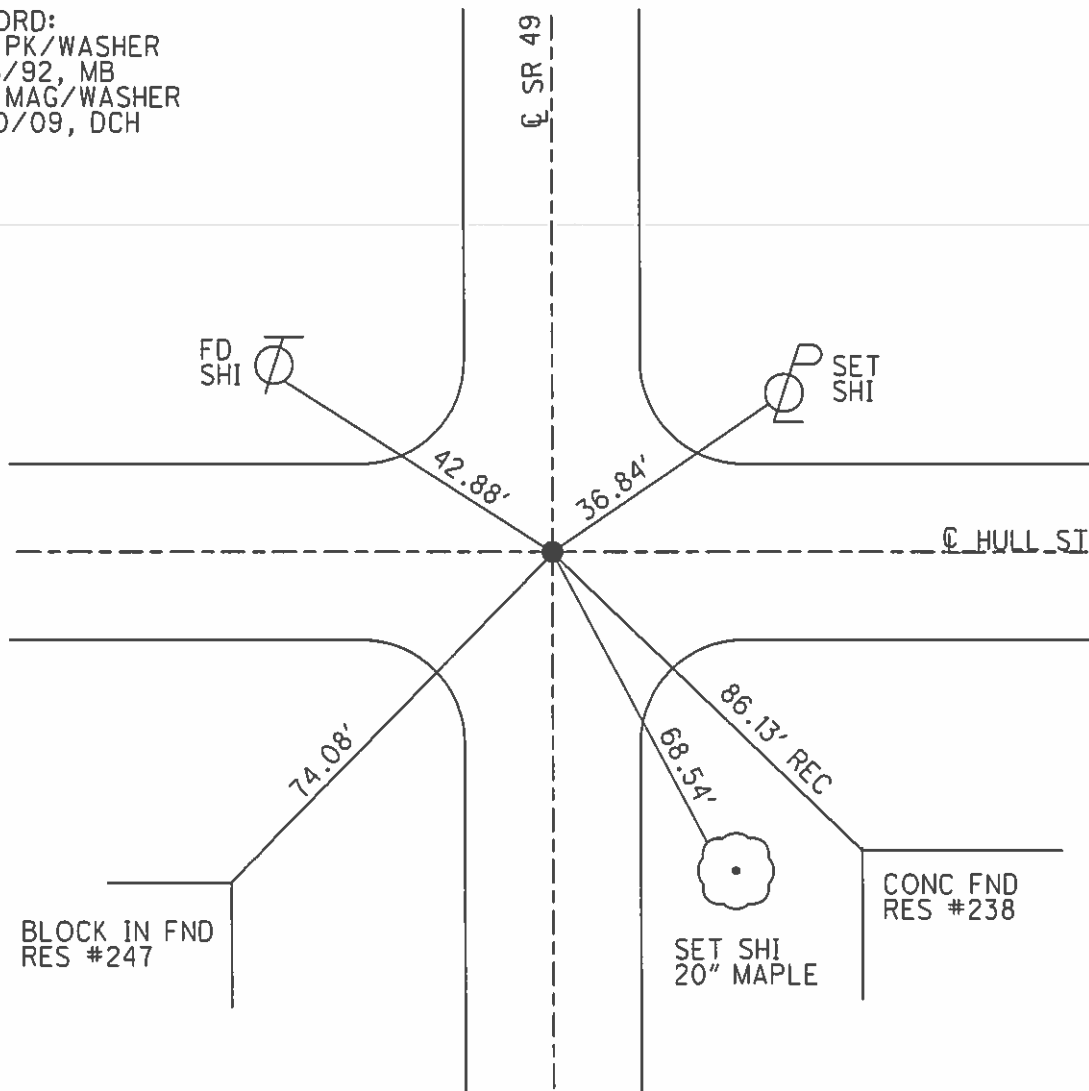

CONC FND  
 RES #238