

O.D.O.T. DISTRICT 2 SURVEY OFFICE (USE ONLY)

PERSONNEL

REFERENCE NO. 5 A

SHEET 17 OF 37

NOTES ROUSOS
 H.C. HOMAN
 R.C. ROUSOS

DATE 8/04/09
 WEATHER PTLY CLOUDY
 TEMP. 80°

ROUTE SR 49
 COUNTY WILLIAMS
 TOWNSHIP ST. JOSEPH
 SECTION 22
 T 6 N R 1 E

DWG BY NIESE PID 94334

TYPE MONUMENT SM.R.R.SPIKE

ON SURFACE - ~~BELOW~~ ON _____

OFFSET 0.8' LT : ~~RT~~

11.0' TO RT EDGE PAVEMENT



STATION: 132+07.12

HORIZ.DATUM: NAD83 (2011)


GEOID: NAVD88 2012A

GRID: NORTHING: 662057.268

EASTING: 1352362.814

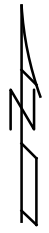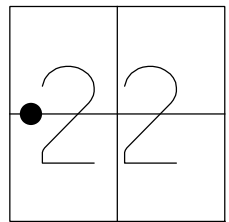


RECORD:
 STA. 137+79.06
 1932 PLAN
 SET P.K./WASHER
 8/03/00, MDB
 SET MAG/WASHER
 8/4/09, DCH
 FD MAG/WASHER
 REFA5
 7/23/18, JFO
 4/5/21, JFO

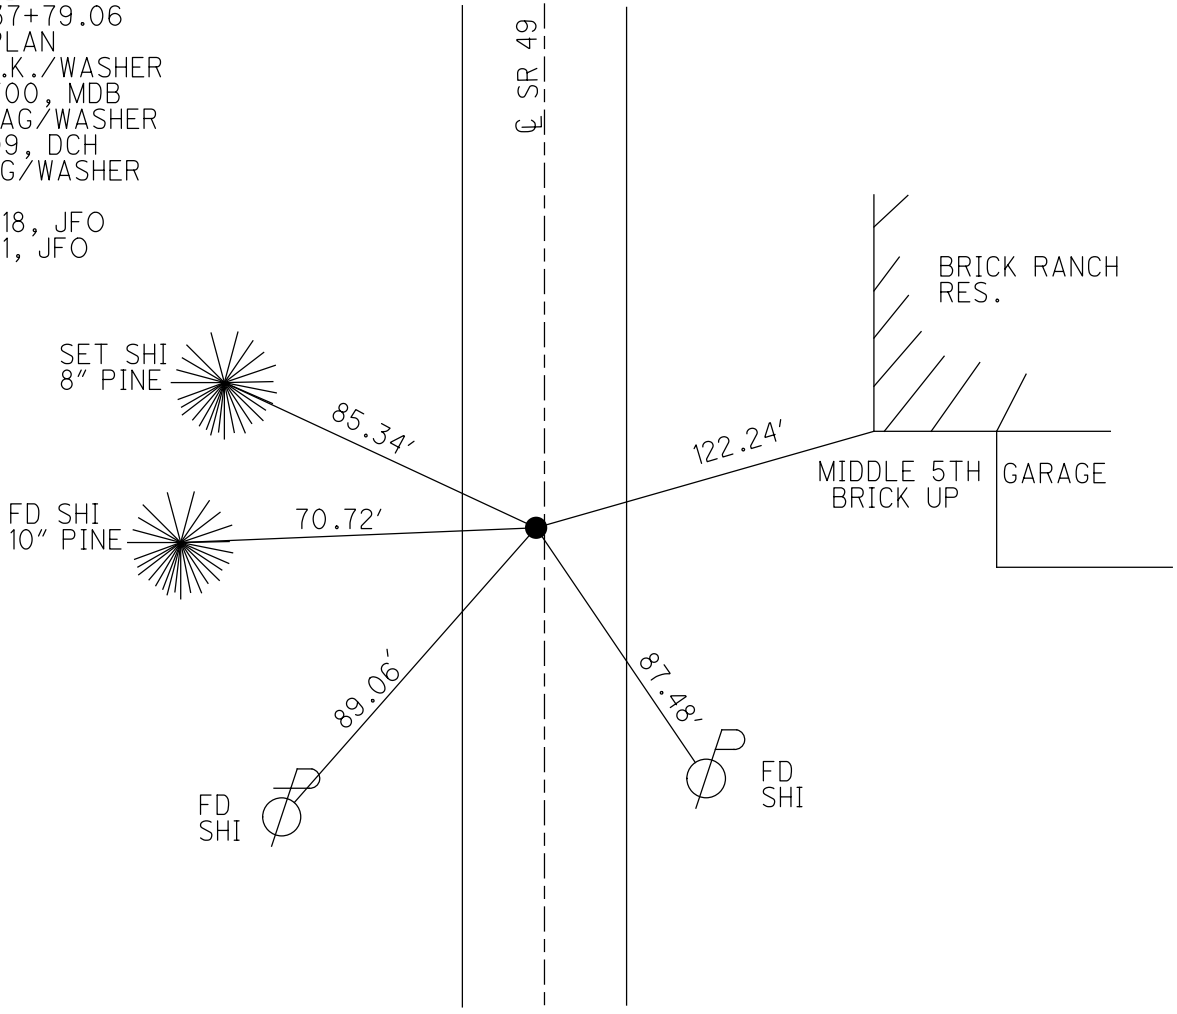

O.D.O.T. DISTRICT 2 SURVEY OFFICE (USE ONLY)

PERSONNEL _____ REFERENCE NO. 6 SHEET 17 OF 17
 NOTES ROUSOS DATE 8/4/09 ROUTE SR 49
 H.C. HOMAN WEATHER PTLY CLOUDY COUNTY WILLIAMS
 R.C. ROUSOS TEMP. 80° TOWNSHIP ST. JOSEPH
 _____ SECTION 22
 _____ T 6 N R 1 E

TYPE MONUMENT SM. RR SPK
 ON SURFACE - ~~BELOW~~ ON
 LEFT - Q PAV'T - ~~RIGHT~~ 0.8'
11.0' TO RT. EDGE PAVEMENT
 S.L.M. 131+86

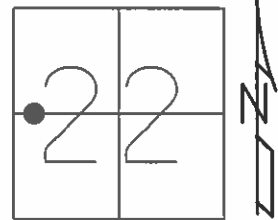

GRID: NORTHING: 662057.216 EASTING: 1352362.662

RECORD:
 STA. 137+79.06
 1932 PLAN
 SET PK/WASHER
 8/03/00, MDB
 SET MAG/WASHER
 8/4/09, DCH

