


O.D.O.T. DISTRICT 2 SURVEY OFFICE (USE ONLY)


PERSONNEL _____ REFERENCE NO. 17 SHEET 33 OF 37
 NOTES RHOADES DATE 4/2/20 ROUTE SR 49
 H.C. O'DONNELL WEATHER SUNNY COUNTY WILLIAMS
 R.C. BALBAUGH TEMP. 44° TOWNSHIP FLORENCE
 DWG BY NIESE PID 94334 SECTION 33
 T 7 N R 1 E

TYPE MONUMENT 1" IPIPE
~~ON SURFACE~~ - BELOW 6.5"
 OFFSET CL PAVEMENT ON LT : RT
10.5' TO RT EDGE PAVEMENT
 STATION: 358+67.04

HORZ. DATUM: NAD83 (2011) GEOID: NAVD88 2012A
 GRID: NORTHING: 680759.526 EASTING: 1347216.594

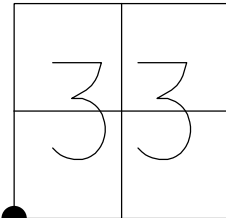

RECORD:
 1932 PLAN
 STA. 365+32.67
 FD 1" IPIPE
 4" DOWN
 6/7/00, MB
 SET P.K./WASHER
 8/23/00, MDB
 D.N.F.
 10/15/18, JFO
 FD 1" IPIPE
 6 1/2" DOWN
 REF17
 4/2/20, JFO
 SET MAG/WASHER
 4/6/21, DSA

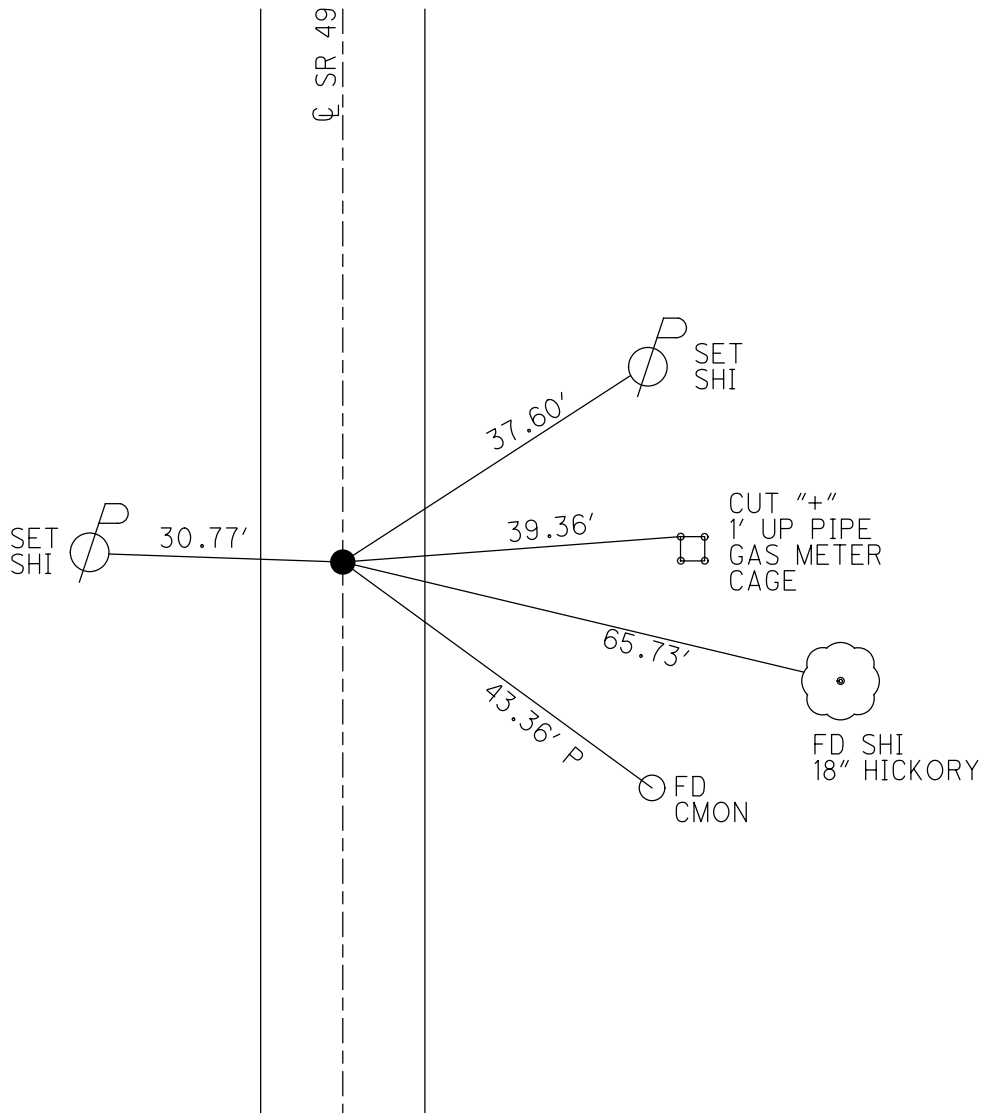

O.D.O.T. DISTRICT 2 SURVEY OFFICE

PERSONNEL

REFERENCE NO. 17

SHEET 16 OF 25

NOTES BARNHISEL

H.C. MOSEK

DATE 6-7-00

ROUTE 49

R.C. CANTERBURY

WEATHER SUNNY

COUNTY WILLIAMS

TEMP. +70°

TOWNSHIP FLORENCE

SECTION 33

T7 N R 1 E


TYPE MONUMENT 1" IRON PIPE

ON SURFACE - BELOW 4"

LEFT - & PAV'T. - RIGHT YES

0.5 TO RT EDGE PAVEMENT

S.L.M. 358+84

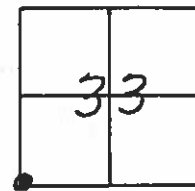

Record: Sta: 365+32.67
1932 Plan

Reset PK/WASHER
8-23-00
mDB

