



O.D.O.T. DISTRICT 2 SURVEY OFFICE (USE ONLY)

PERSONNEL _____ REFERENCE NO. 21 SHEET 37 OF 37
 NOTES RHOADES DATE 4/2/20 ROUTE SR 49
 H.C. O'DONNELL WEATHER SUNNY COUNTY WILLIAMS
 R.C. BALBAUGH TEMP. 45° TOWNSHIP FLORENCE
 DWG BY NIESE PID 94334 SECTION 28
 T 7 N R 1 E

TYPE MONUMENT MAG SPIKE
 ON SURFACE - ~~BELOW~~ ON
 OFFSET ☉ PAVEMENT ON LT : RT
11.2' TO RT EDGE PAVEMENT
 STATION: 437+64.30

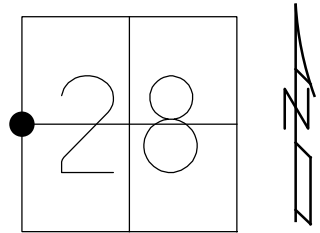

HORIZ.DATUM: NAD83 (2011) GEOID: NAVD 2012A
 GRID: NORTHING: 688655.243 EASTING: 1347372.668

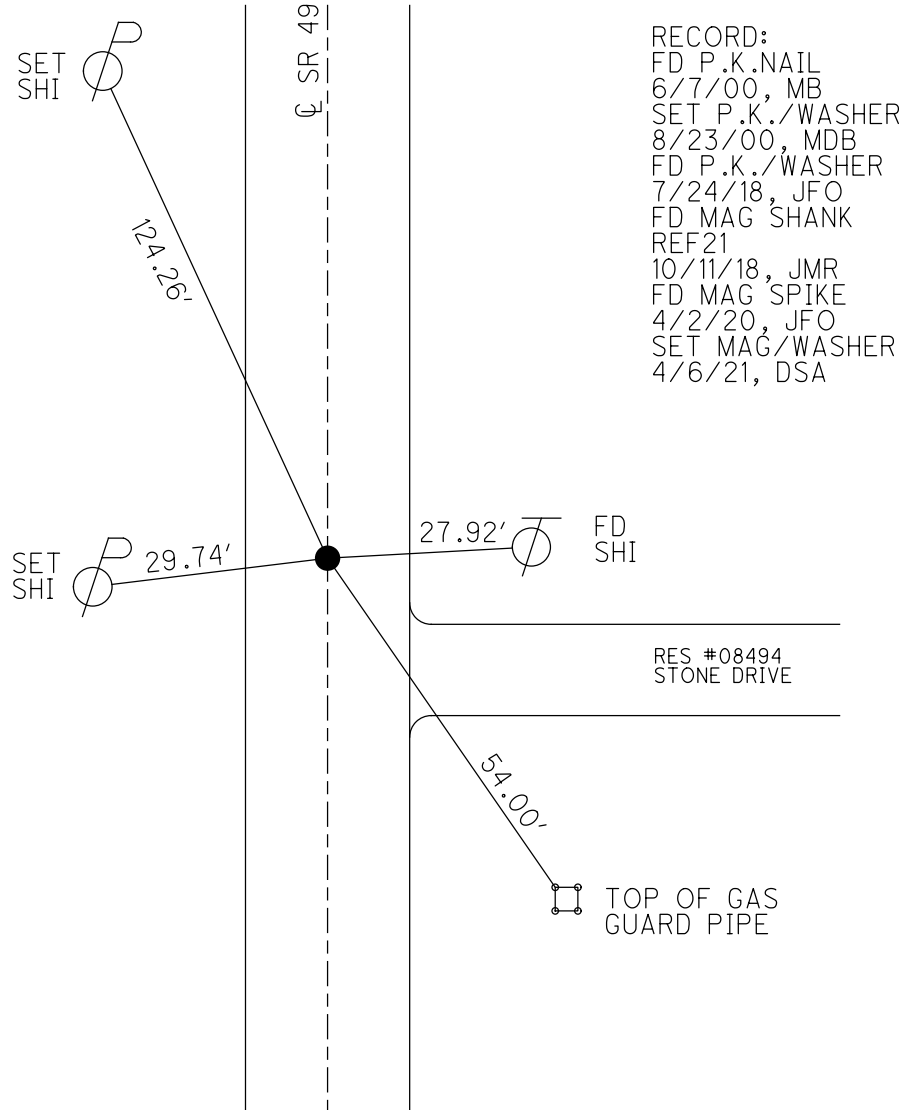

RECORD:
 FD P.K.NAIL
 6/7/00, MB
 SET P.K./WASHER
 8/23/00, MDB
 FD P.K./WASHER
 7/24/18, JFO
 FD MAG SHANK
 REF21
 10/11/18, JMR
 FD MAG SPIKE
 4/2/20, JFO
 SET MAG/WASHER
 4/6/21, DSA

O.D.O.T. DISTRICT 2 SURVEY OFFICE

PERSONNEL

REFERENCE NO. 21

SHEET 20 OF 25

NOTES BARNAISEL

H.C. MOSEK

R.C. CANTERBURY

DATE 6-7-00

WEATHER SUNNY

TEMP. +70°

ROUTE 49

COUNTY WILLIAMS

TOWNSHIP FLORENCE

SECTION 28

T 7 N 1 R 1 E


TYPE MONUMENT PK NAIL

ON SURFACE - ~~BELOW~~ yes

LEFT - & PAU'T. - RIGHT yes

11.2' TO R. EDGE PAVEMENT

S.L.M. 437+94

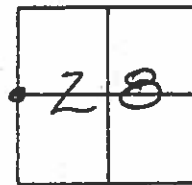

Reset PK/WASHER

8-23-00

MD B

