

O.D.O.T. DISTRICT 2 SURVEY OFFICE (USE ONLY)

PERSONNEL

REFERENCE NO. 22

SHEET 1 OF 18

NOTES RHOADES DATE 4/2/20  
 H.C. O'DONNELL WEATHER SUNNY  
 R.C. BALBAUGH TEMP. 45°

ROUTE SR 49  
 COUNTY WILLIAMS  
 TOWNSHIP FLORENCE  
 SECTION 28

DWG BY NIESE PID 94334

T 7 N R 1 E

TYPE MONUMENT MAG SHANK

ON SURFACE - ~~BELOW~~ ON

OFFSET ☐ PAVEMENT ON LT : RT

- TO - EDGE PAVEMENT


STATION: 463+96.69

HORZ. DATUM: NAD83 (2011)


GEOID: NAVD88 2012A

GRID: NORTHING: 691287.093

EASTING: 1347425.764

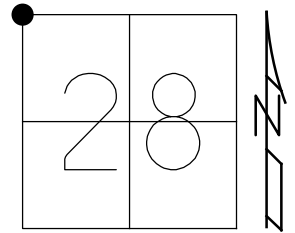


RECORD: 1932  
 STA. 470+69.12  
 FD P.K.NAIL  
 6/7/00, MB  
 SET P.K./WASHER  
 8/23/00, MDB  
 FD P.K./WASHER  
 2/7/11, MC  
 FD MAG SHANK  
 REF22  
 10/11/18, JMR  
 4/2/20, JFO  
 SET MAG/WASHER  
 4/6/21, DSA

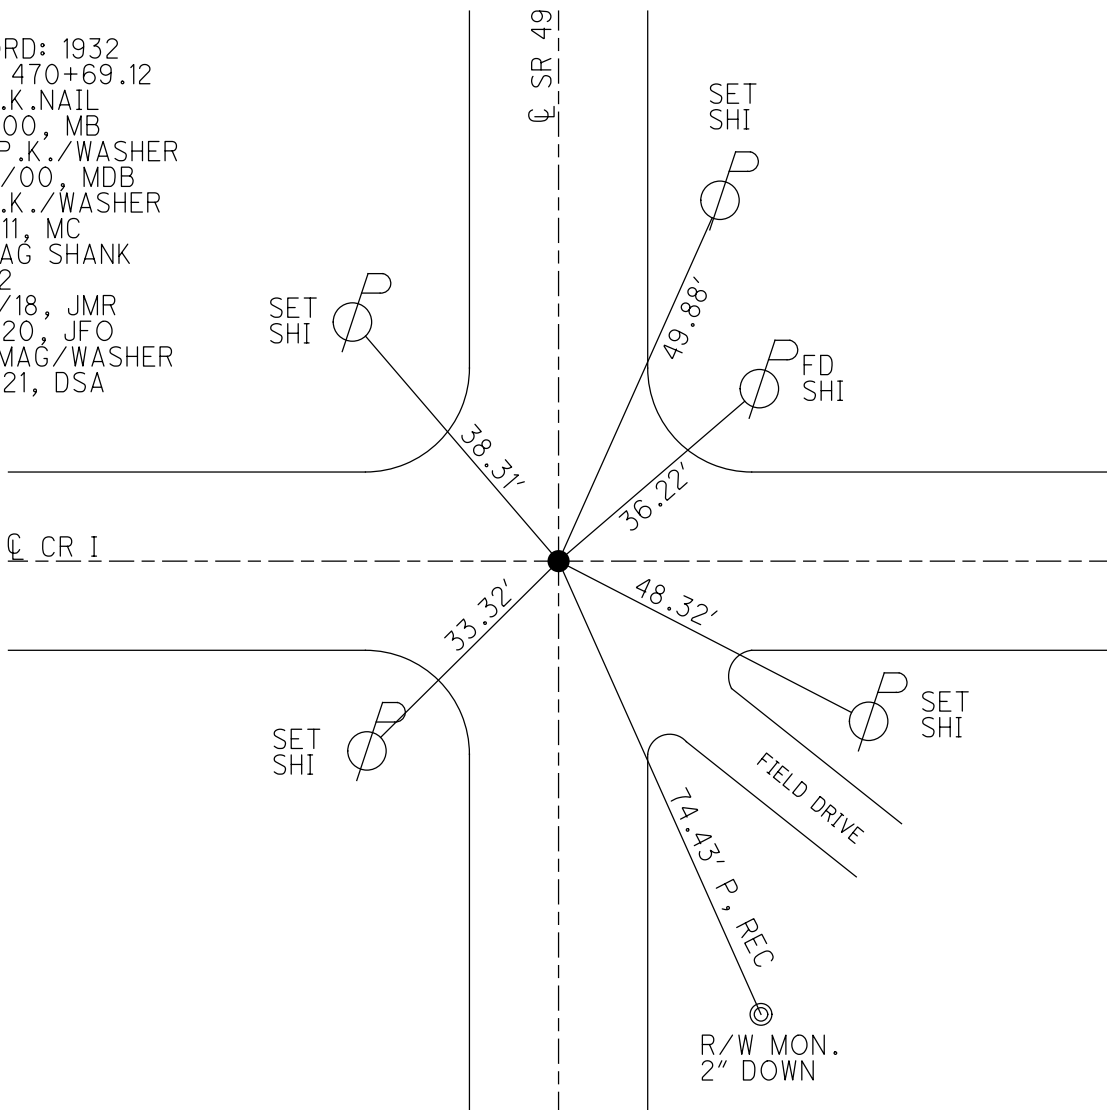

**O.D.O.T. DISTRICT 2 SURVEY OFFICE (USE ONLY)**

PERSONNEL \_\_\_\_\_ REFERENCE NO. 22 SHEET 1 OF 18  
 NOTES BARNHISEL DATE 6/7/00 ROUTE SR 49  
 H.C. MOSER WEATHER SUNNY COUNTY WILLIAMS  
 R.C. CANTERBURY TEMP. 75° TOWNSHIP FLORENCE  
 \_\_\_\_\_ SECTION 28  
 \_\_\_\_\_ T 7 N R 1 E

TYPE MONUMENT P.K.NAIL  
 ON SURFACE - ~~BELOW~~ ON  
 LEFT - ☉ PAV'T - RIGHT ON, ON ☉ E & W  
\_\_\_\_\_ TO \_\_\_\_\_ EDGE PAVEMENT  
 S.L.M. 463+21.89

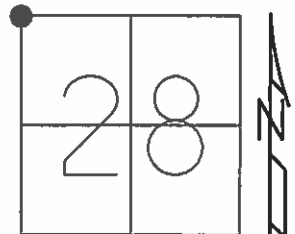

Grid: Northing: 691287.088 Easting: 1347425.693

RECORD: 1932  
 STA. 470+69.12  
 RESET P.K./WASHER  
 8/23/00, MOB  
 FD P.K./WASHER  
 1/20/11, MC  
 GPS, REF22  
 2/7/11

