


O.D.O.T. DISTRICT 2 SURVEY OFFICE (USE ONLY)


PERSONNEL _____ REFERENCE NO. 24 SHEET 3 OF 18
 NOTES HUSS DATE 5/4/12 ROUTE SR 49
 H.C. CANTERBURY WEATHER FAIR COUNTY WILLIAMS
 R.C. HARBAUGH TEMP. 75° TOWNSHIP FLORENCE
 DWG BY NIESE PID 94334 SECTION 21
 T 7 N R 1 E

TYPE MONUMENT MAG/WASHER
 ON SURFACE - ~~BELOW~~ ON
 OFFSET Q PAVEMENT ON LT : RT
14.0' TO RT EDGE PAVEMENT
 STATION: 516+60.46

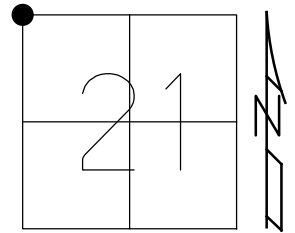

HORZ.DATUM: NAD83 (2011) GEOID: NAVD88 2012A
 GRID: NORTHING: 696549.483 EASTING: 1347546.124

RECORD:
 FD P.K.SHANK
 REF24
 1/31/11, SAH
 SET MAG/WASHER
 9/5/12, SAH
 FD MAG/WASHER
 REF24
 10/11/18, JMR
 4/6/21, DSA

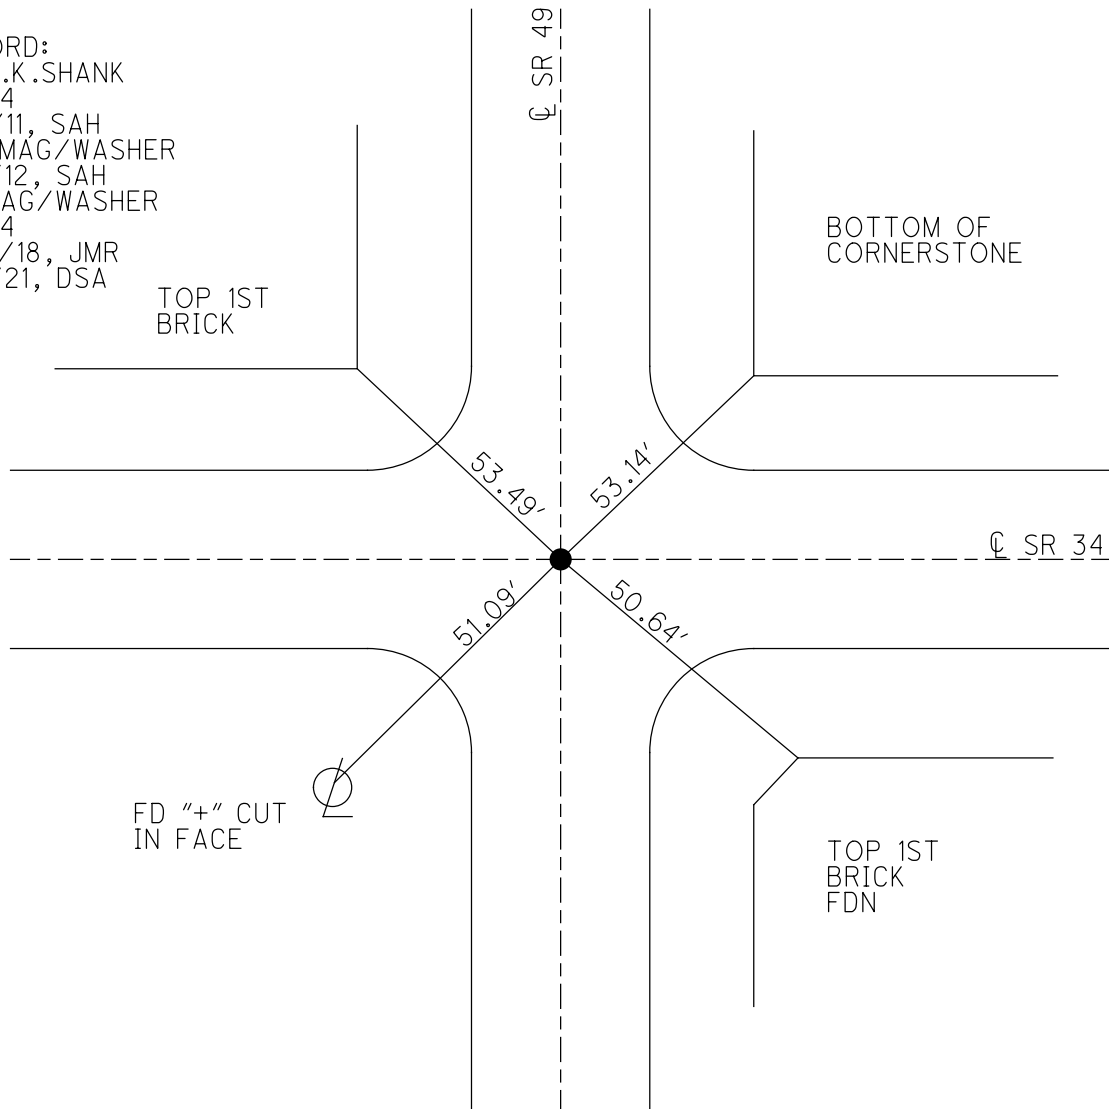

O.D.O.T. DISTRICT 2 SURVEY OFFICE (USE ONLY)

PERSONNEL _____ REFERENCE NO. 24 SHEET 3 OF 18

NOTES HUSS DATE 5/4/12 ROUTE SR 49
 H.C. CANTERBURY WEATHER FAIR COUNTY WILLIAMS
 R.C. HARBAUGH TEMP. 75° TOWNSHIP FLORENCE
 _____ SECTION 21
 _____ T 7 N R 1 E

TYPE MONUMENT MAG/WASHER


ON SURFACE - ~~BELOW~~ ON

LEFT - ☉ PAV'T - RIGHT ON

14.0' TO RT EDGE PAVEMENT


S.L.M. 515+85.60

Grid: Northing: 696549.426 Easting: 1347546.075

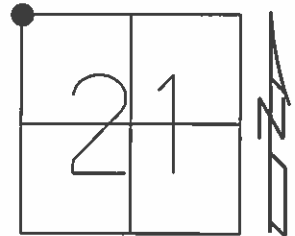

FD P.K.SHANK
 1/26/11, MC
 GPS, REF 24
 1/31/11


SET MAG/WASHER
 9/5/12, SAH

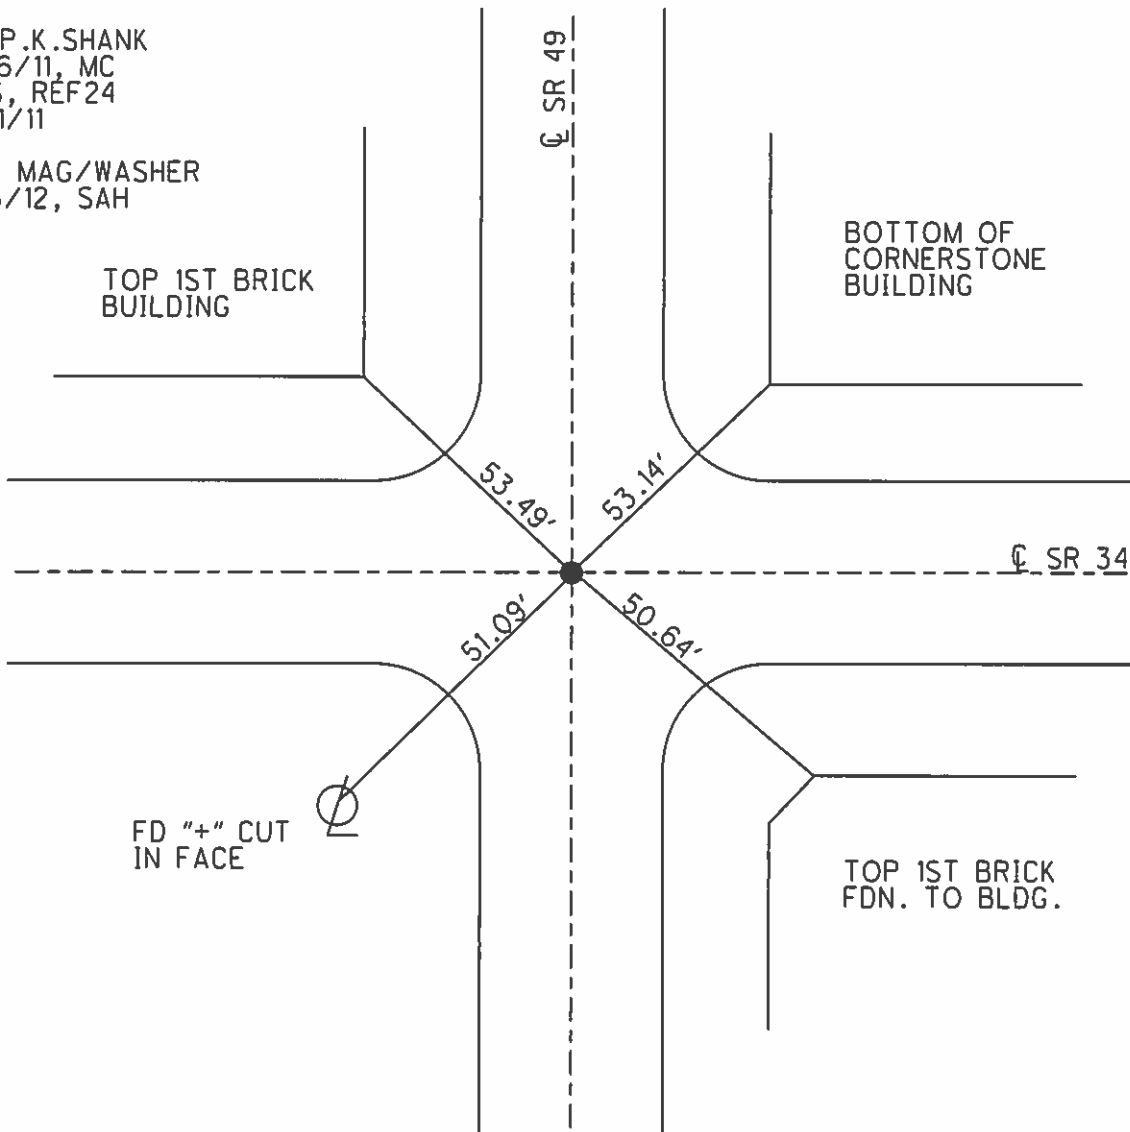

O.D.O.T. DISTRICT 2 SURVEY OFFICE (USE ONLY)

PERSONNEL _____ REFERENCE NO. 5 SHEET 15 OF 25
 NOTES HUSS DATE 5/4/12 ROUTE SR 34
 H.C. CANTERBURY WEATHER FAIR COUNTY WILLIAMS
 R.C. HARBAUGH TEMP. 75° TOWNSHIP FLORENCE
 _____ SECTION 16
 _____ T 7 N R 1 E

TYPE MONUMENT MAG/WASHER
 ON SURFACE - ~~BELOW~~ ON
 LEFT - ☉ PAV'T - RIGHT ON
- TO - EDGE PAVEMENT
 S.L.M. 517+03

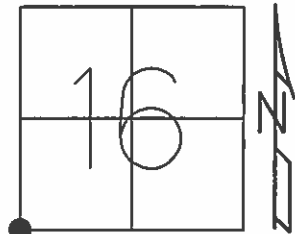

Grid: Northing: 696549.425 Easting: 1347546.075

FD P.K.SHANK
 1/26/11, MC
 GPS, REF5
 1/31/11, MC

SET MAG/WASHER
 9/5/12, SAH

