


O.D.O.T. DISTRICT 2 SURVEY OFFICE (USE ONLY)

PERSONNEL \_\_\_\_\_ REFERENCE NO. 28 SHEET 8 OF 18  
 NOTES HUSS DATE 5/10/12 ROUTE SR 49  
 H.C. HUSS WEATHER CLEAR/BREEZY COUNTY WILLIAMS  
 R.C. CANTERBURY TEMP. 54° TOWNSHIP FLORENCE  
 \_\_\_\_\_ SECTION 8  
 \_\_\_\_\_ T 7 N R 1 E


TYPE MONUMENT SM.R.R.SPIKE  
~~ON SURFACE~~ - BELOW 0.35'  
 LEFT - ☉ PAV'T - ~~RIGHT~~ 1.3'  
 - TO - EDGE PAVEMENT ON ☉ SR 107  
 S.L.M. 621+52.99

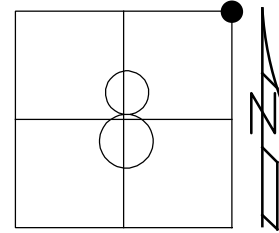

Grid: Northing: 707113.843 Easting: 1347791.591

RECORD:  
 SET SM RR SPIKE  
 5-23-85, CL  
 FD SM.R.R.SPIKE  
 4/25/88, DC  
 FD 1" IPIPE  
 2" BELOW  
 5/20/97, MB  
 SET P.K./WASHER  
 10-02-97, MB  
 FD SM.R.R.SPIKE  
 REF28  
 2/7/11, MB  
 0.35' DOWN  
 5/10/12, MC  
 SET MAG/WASHER  
 9/11/12, SAH  
 FD MAG/WASHER  
 REF1  
 6-17-14  
 12/31/14, EBW  
 FD MAG/WASHER  
 9/18/19, JMR

NOTE: REF 1 SR 107

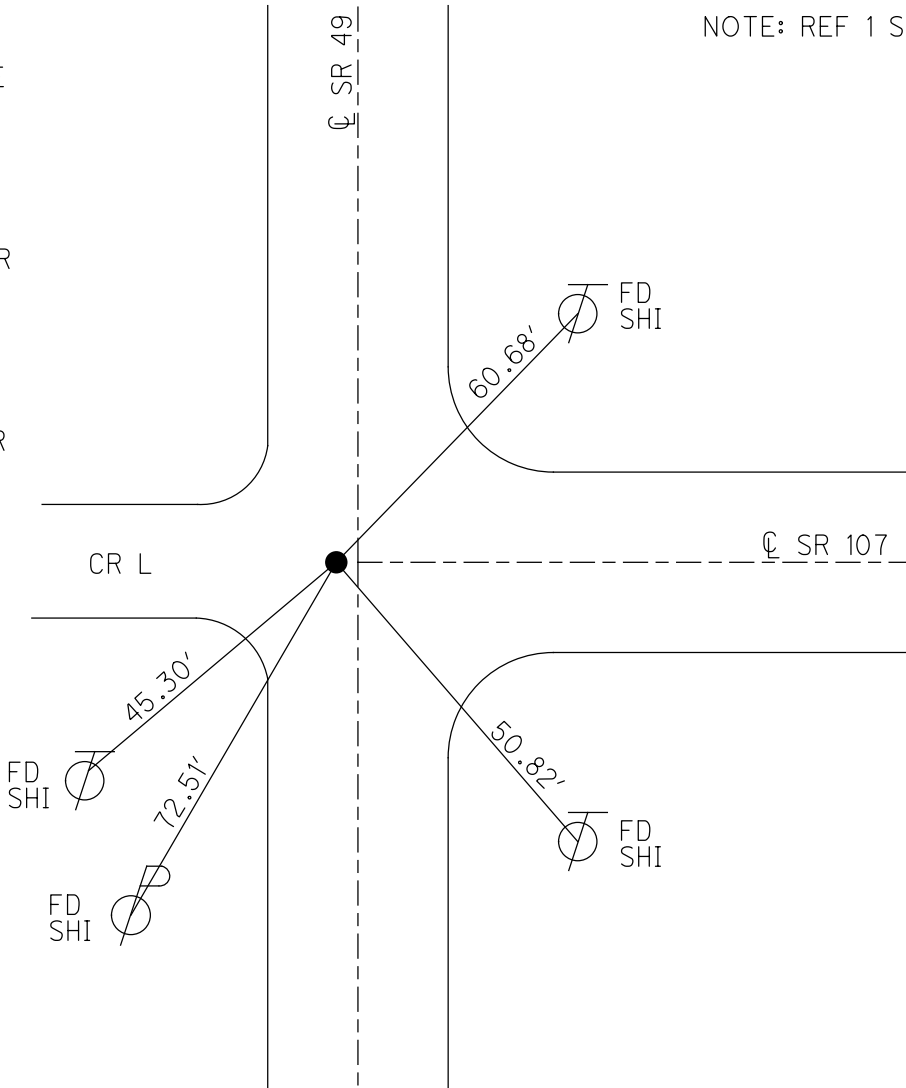

O.D.O.T. DISTRICT 2 SURVEY OFFICE (USE ONLY)

PERSONNEL \_\_\_\_\_ REFERENCE NO. 28 SHEET 8 OF 18  
 NOTES HUSS DATE 5/10/12 ROUTE SR 49  
 H.C. HUSS WEATHER CLEAR/BREEZY COUNTY WILLIAMS  
 R.C. CANTERBURY TEMP. 54° TOWNSHIP FLORENCE  
 \_\_\_\_\_ SECTION 8  
 \_\_\_\_\_ T 7 N R 1 E

TYPE MONUMENT SM.R.R.SPIKE


~~ON SURFACE~~ - BELOW 0.35'

LEFT - ℄ PAV'T - ~~RIGHT~~ 1.3', ON ℄ SR 107

- TO - EDGE PAVEMENT

S.L.M. 621+52.99, 0+00 SR 107

Grid: Northing: 707113.960 Easting: 1347791.506

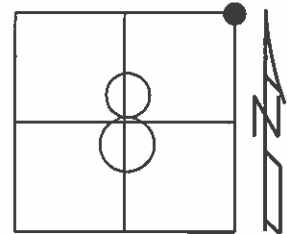

NOTE: REF1 SR 107

SET SM.R.R.SPIKE  
5/23/85, CL

FD 1" IPIPE  
5/20/97, MB

RESET P.K./WASHER  
10/2/97, MB

FD SM.R.R.SPIKE  
1/25/11, MC  
GPS, REF28  
2/7/11

SET MAG/WASHER  
9/11/12, SAH

