


O.D.O.T. DISTRICT 2 SURVEY OFFICE (USE ONLY)

PERSONNEL \_\_\_\_\_ REFERENCE NO. 31 SHEET 13 OF 18  
 NOTES HUSS DATE 5/10/12 ROUTE SR 49  
 H.C. HUSS WEATHER CLEAR/BREEZY COUNTY WILLIAMS  
 R.C. CANTERBURY TEMP. 58° TOWNSHIP FLORENCE  
 \_\_\_\_\_ SECTION 33  
 \_\_\_\_\_ T & N R 1 E

TYPE MONUMENT SM.R.R.SPIKE  
~~ON SURFACE~~ - BELOW 0.38'  
 LEFT - ☉ PAV'T - RIGHT ON  
- TO - EDGE PAVEMENT  
 S.L.M. 709+79.67

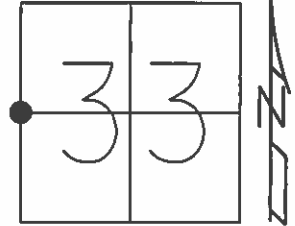


Grid: Northing: 715938.259 Easting: 1347996.319

FD SM.R.R.SPIKE  
5/20/97, MB

RESET P.K./WASHER  
10/3/97, MB

FD SQ.HEADED SPIKE  
1/25/11, MC  
GPS, REF31  
2/8/11

SET MAG/WASHER  
9/12/12, SAH

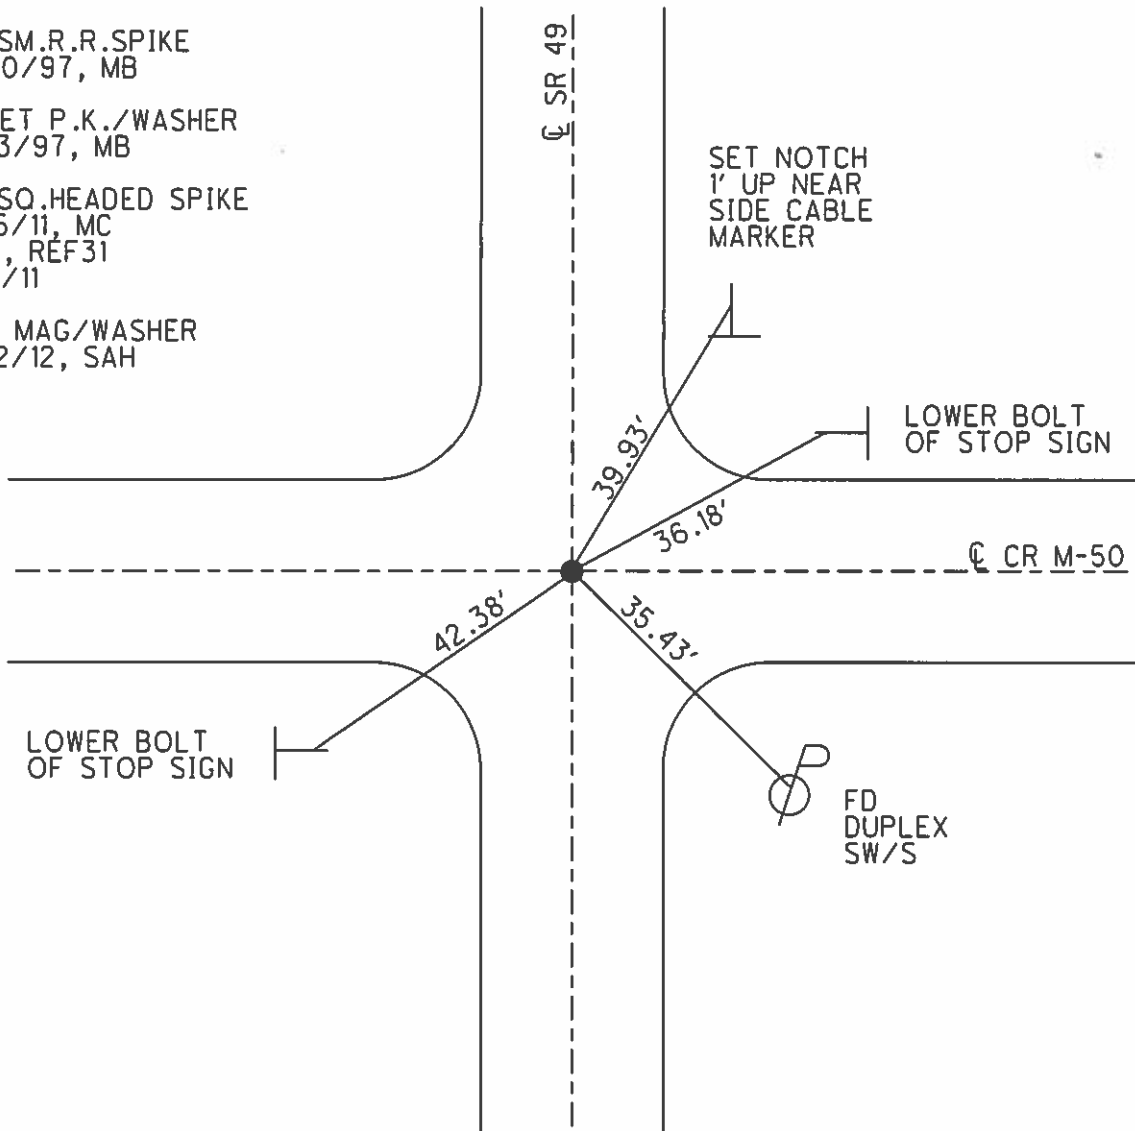

LOWER BOLT OF STOP SIGN

FD  
DUPLEX  
SW/S